# PLAT OF SURVEY
# TOPOGRAPHICAL MAPPING

## LOT 27 OF TUSCANY OF LAKE GENEVA PHASE 2

LOCATED IN PART OF THE SE 1/4 OF THE SW 1/4 AND THE NE 1/4 OF THE SW 1/4 OF SECTION 34, TOWN 2 NORTH, RANGE 18 EAST, AND THE NE 1/4 OF THE NW 1/4 OF SECTION 3, TOWN 1 NORTH, RANGE 18 EAST, WALWORTH COUNTY, WISCONSIN

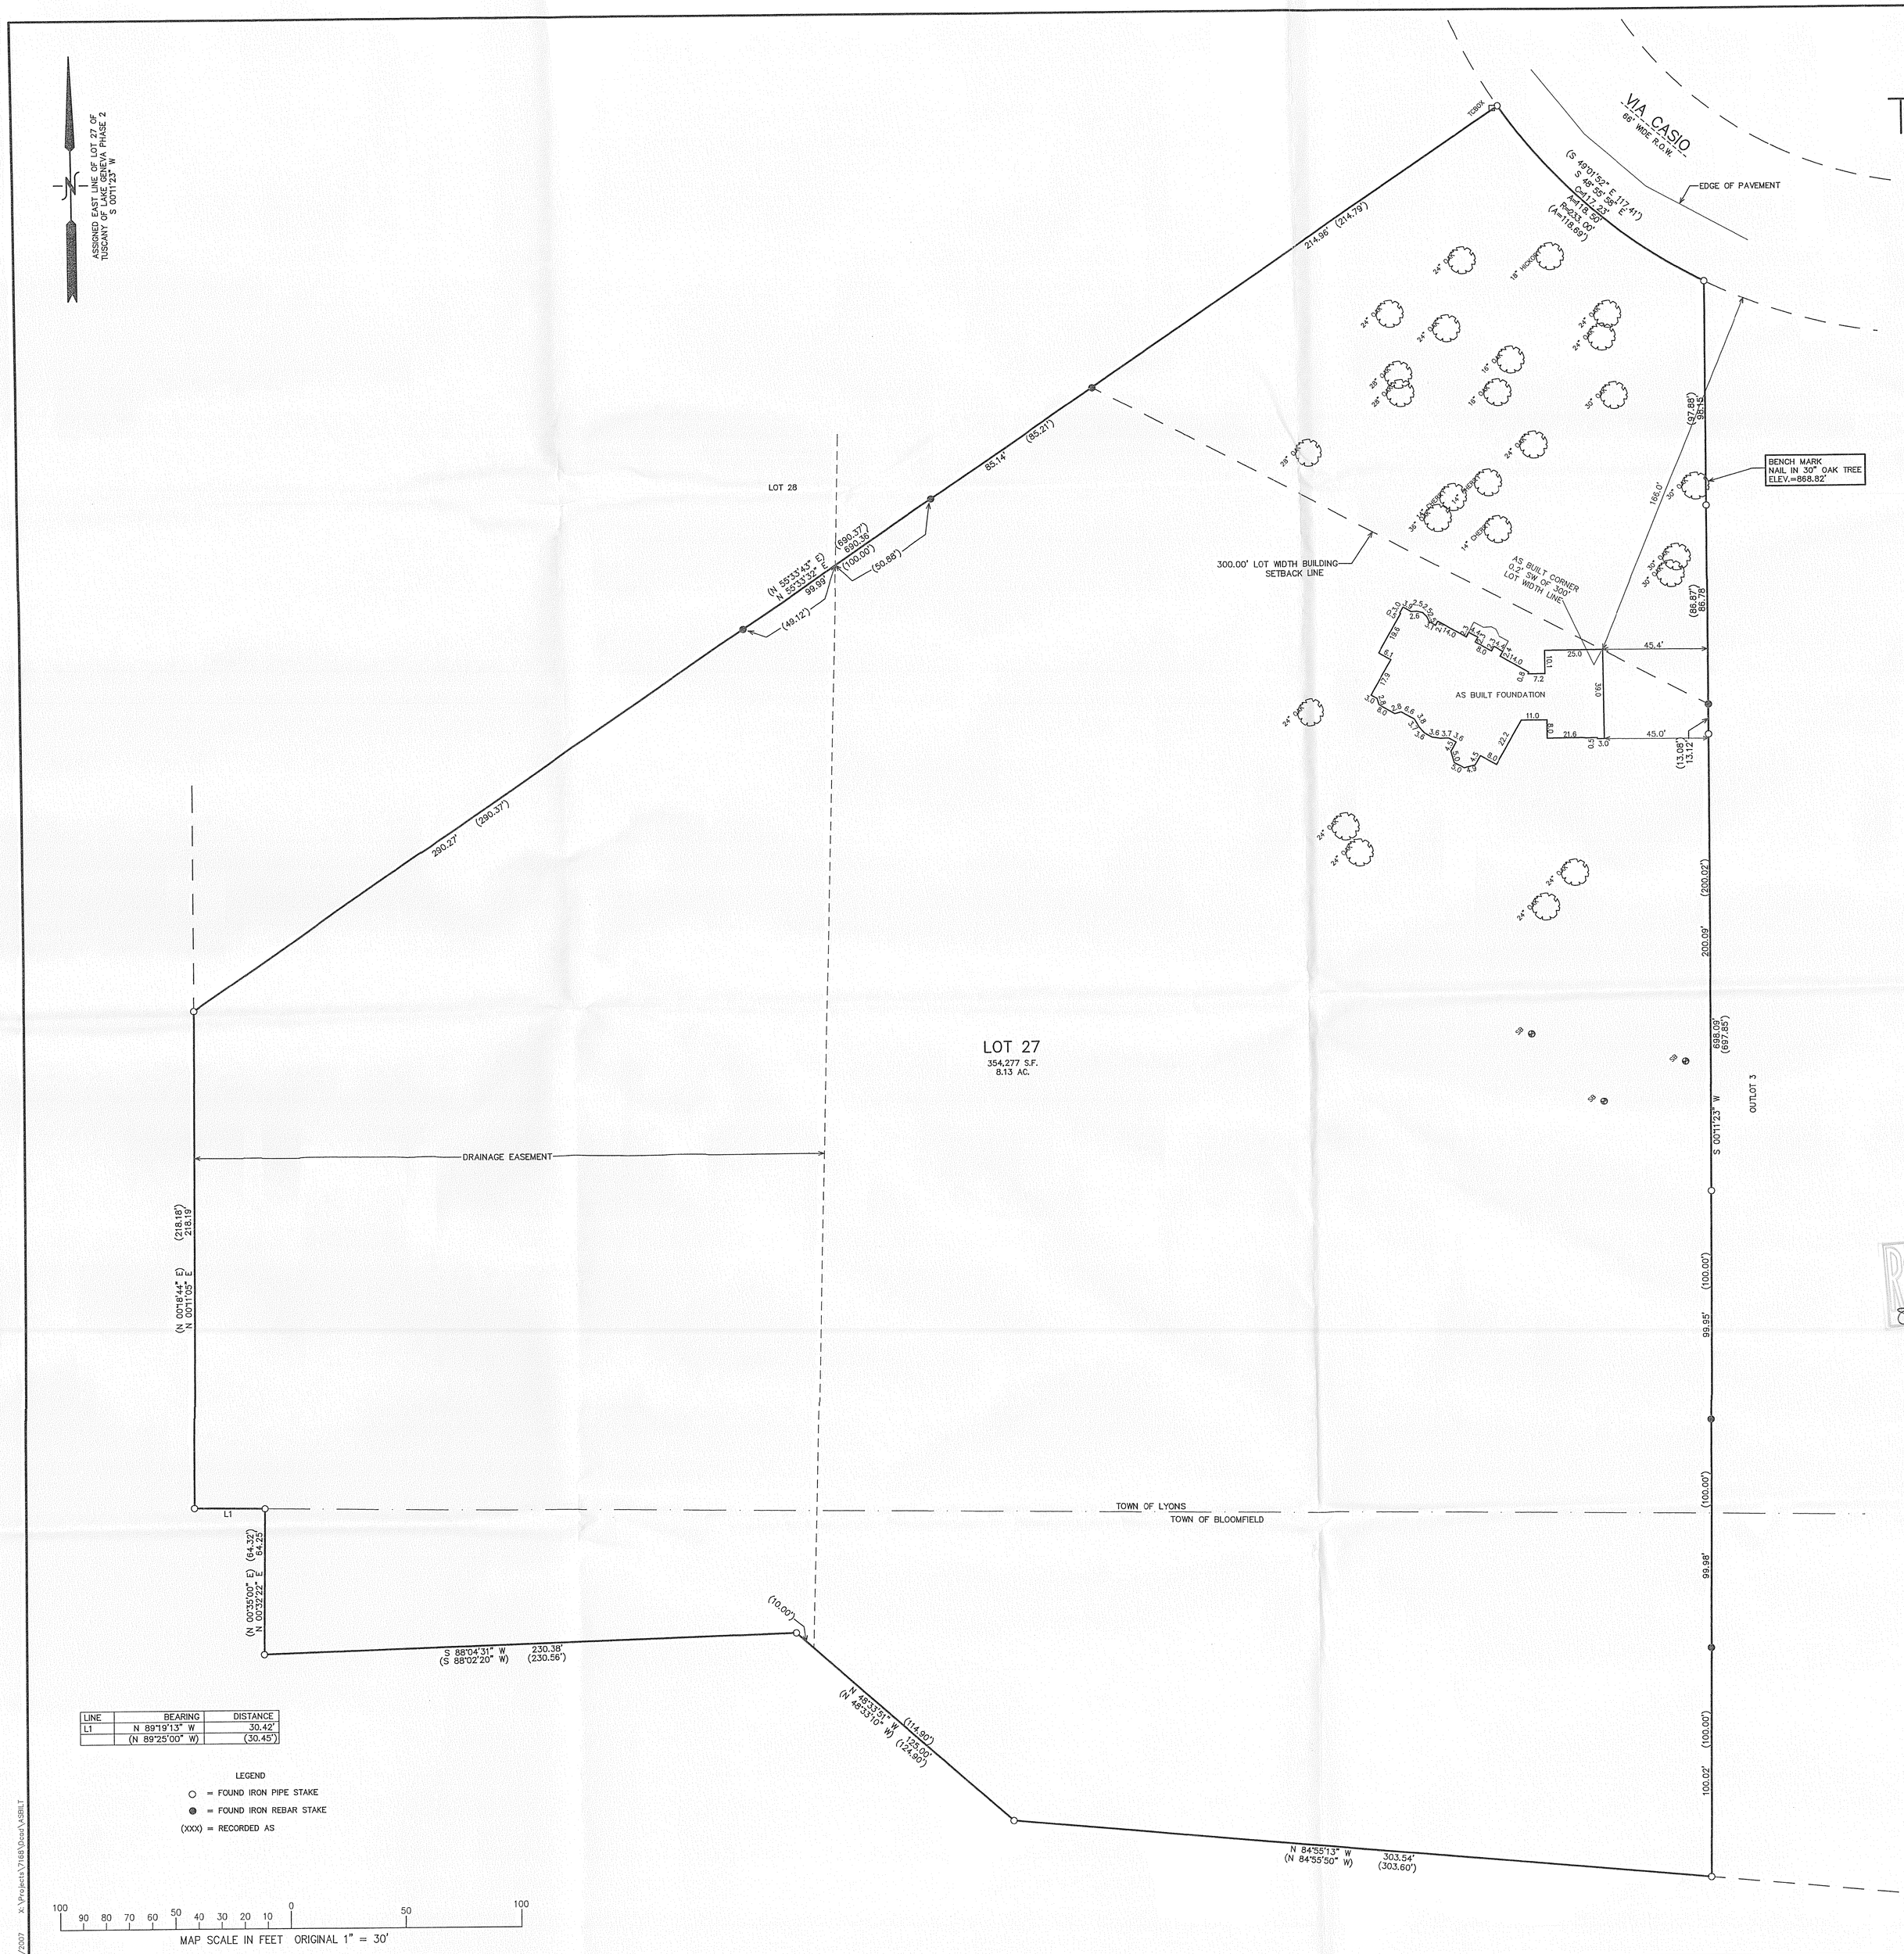


| LINE | BEARING | DISTANCE |
|---|---|---|
| L1 | N 89°19'13" W | 30.42' |
| | (N 89°25'00" W) | (30.45') |

LEGEND

○ = FOUND IRON PIPE STAKE

● = FOUND IRON REBAR STAKE

(XXX) = RECORDED AS

RECEIVED APR - 9 2007

NOTE: COPIES OF THIS MAP TO WHICH THE FOLLOWING CERTIFICATE WILL APPLY SHOW THE SURVEYOR'S ORIGINAL SEAL AND SIGNATURE IN RED INK. COPIES BY ANY OTHER MEANS MAY HAVE ALTERATIONS WHICH DO NOT REPRESENT THE SURVEYOR'S WORK PRODUCT.

I HEREBY CERTIFY THAT THE ABOVE DESCRIBED PROPERTY HAS BEEN SURVEYED UNDER MY DIRECTION AND THAT THE ABOVE MAP IS A TRUE REPRESENTATION THEREOF AND SHOWS THE SIZE AND LOCATION OF THE PROPERTY AND ITS EXTERIOR BOUNDARIES. THIS SURVEY IS MADE FOR THE USE OF THE PRESENT OWNERS OF THE PROPERTY, AND ALSO THOSE WHO PURCHASE, MORTGAGE, OR GUARANTEE THE TITLE THERETO WITHIN ONE YEAR FROM THE DATE HEREOF.

DATED: OCTOBER 26, 2006

REVISED 03-01-2007 TO SHOW AS BUILT FOUNDATION

WISCONSIN PETER S. GORDON S-2101 ELKHORN, WI LAND SURVEYOR

PETER S. GORDON R.L.S. 2101

– WORK ORDERED BY –
BILL NELSON
N1599 WILLOWBROOK DRIVE
LAKE GENEVA, WI 53147


FARRIS, HANSEN & ASSOCIATES, INC.
ENGINEERING – ARCHITECTURE – SURVEYING
7 RIDGWAY COURT P.O. BOX 437
ELKHORN, WISCONSIN 53121
OFFICE: (262) 723-2098 FAX: (262) 723-5886


REVISIONS

| PROJECT NO. |
|---|
| 7168 |
| DATE |
| 10/26/2006 |
| SHEET NO. |
| 1 OF 1 |

3/1/2007 X:\Projects\7168\Dcad\ASBLT

MTU2-3 NTU2-3

218-1630