Plat of Survey

of


Lot 1 of Certified Survey Map No. 3966,

recorded in Vol. 24 of Certified Survey Maps of Walworth County on Page 211 and located in the Southeast 1/4 of Section 33, Town 2 North, Range 18 East, Town of Lyons, Walworth County, Wisconsin.

Prepared for: **Ken Mulhollon**
6433 Town Line Road
Lake Geneva, Wisconsin. 53147


Bearings reference to the Wisconsin State Plane Coordinate System, South Zone.


Detail of House
1"=20'

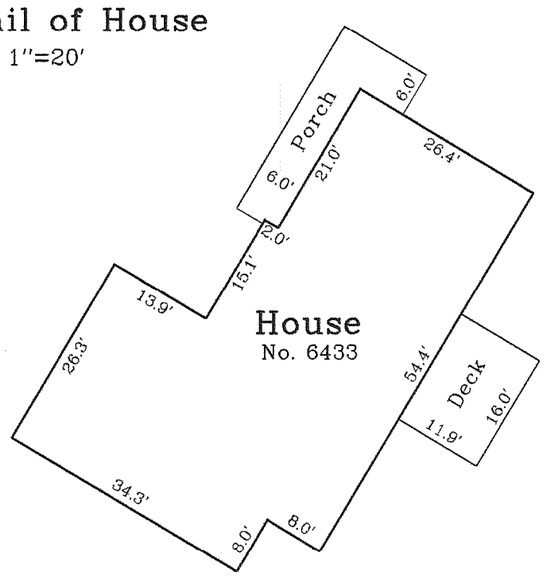

RECEIVED
AUG - 1 2007

Location Sketch
Section 33,
Town 2 North, Range 18 East.
1"=3000'

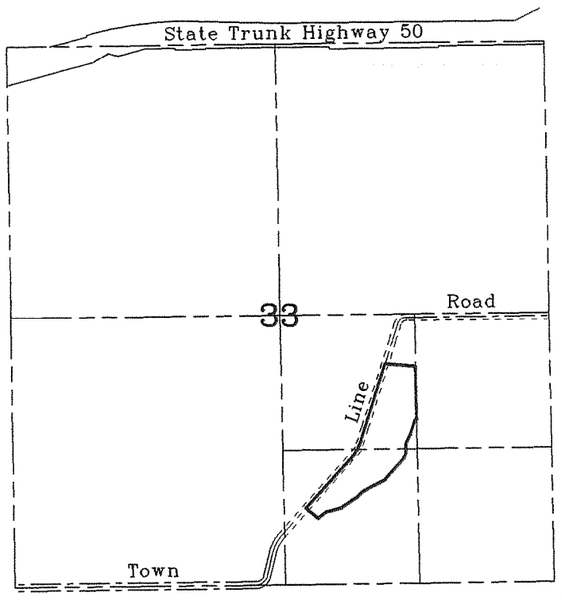

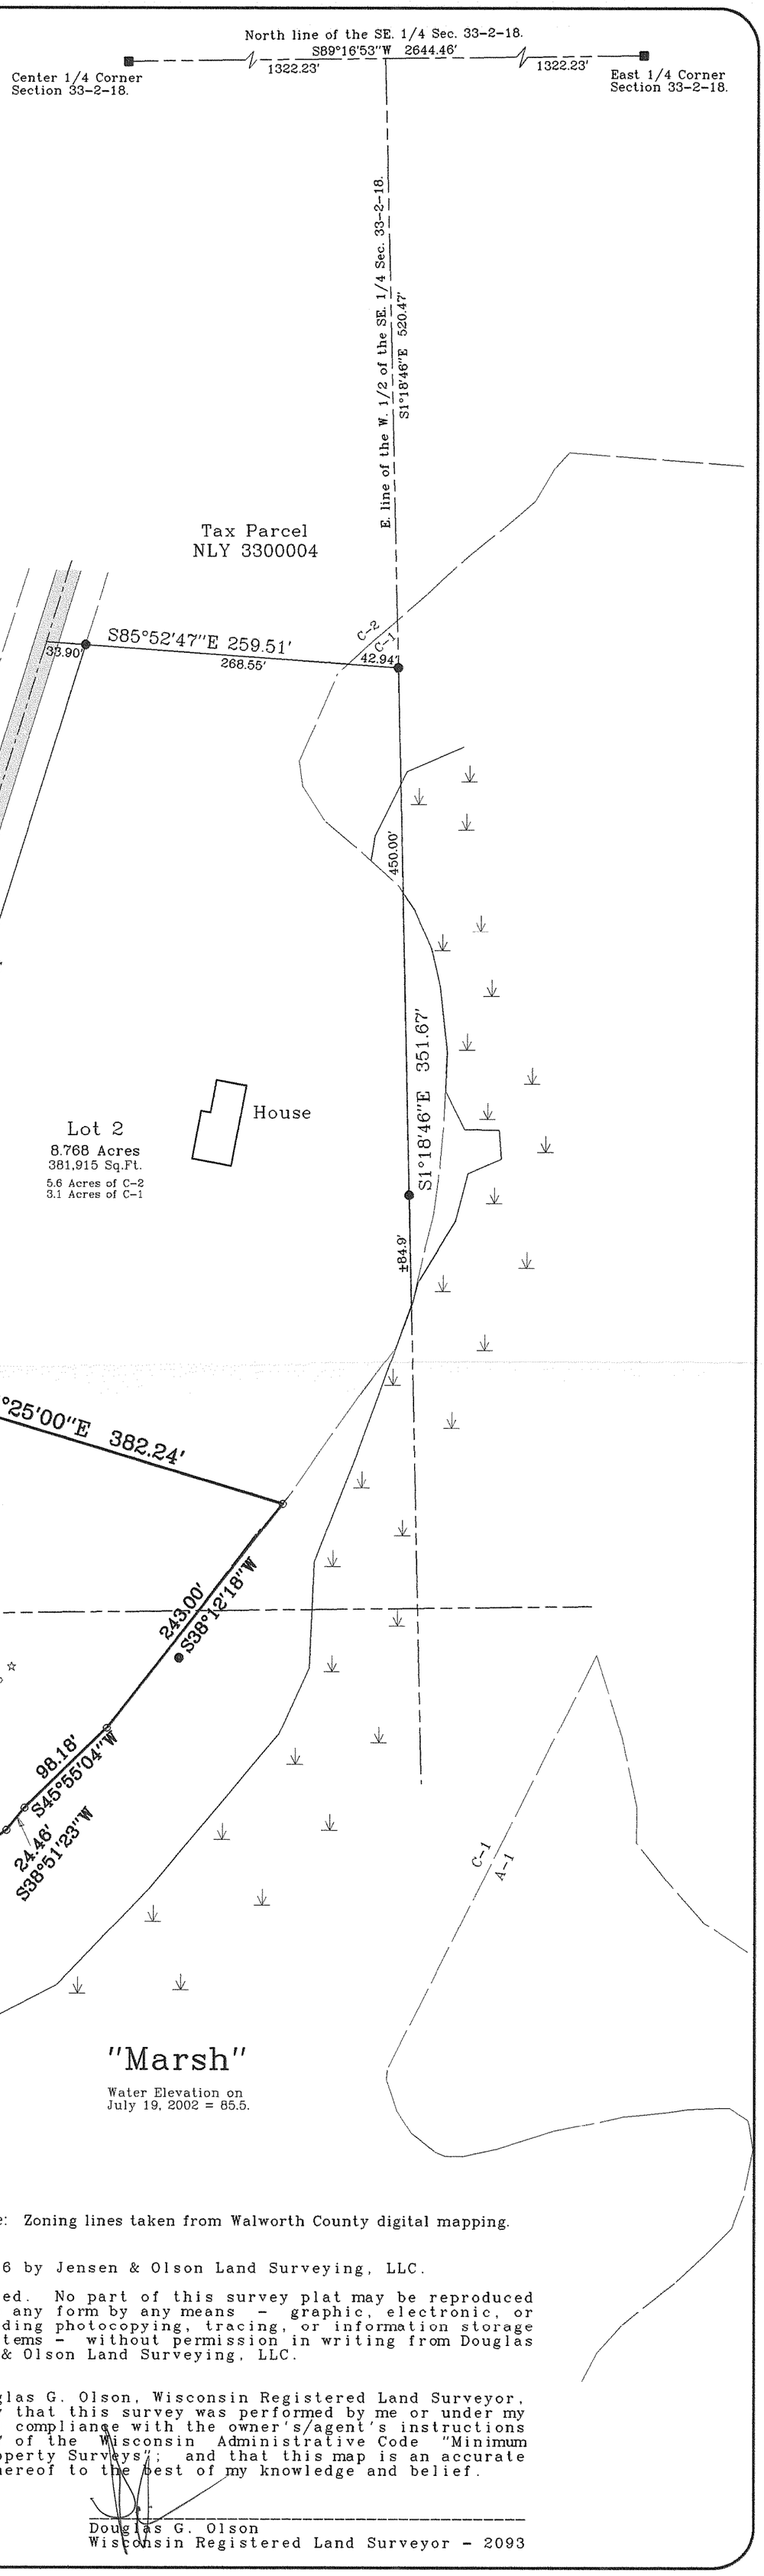

Note: Zoning lines taken from Walworth County digital mapping.

Copyright c 2006 by Jensen & Olson Land Surveying, LLC.

All rights reserved. No part of this survey plat may be reproduced or transmitted in any form by any means - graphic, electronic, or mechanical, including photocopying, tracing, or information storage and retrieval systems - without permission in writing from Douglas G. Olson, Jensen & Olson Land Surveying, LLC.

I, Douglas G. Olson, Wisconsin Registered Land Surveyor, do hereby certify that this survey was performed by me or under my direction in full compliance with the owner's/agent's instructions and Chapter A-E 7 of the Wisconsin Administrative Code "Minimum Standards for Property Surveys"; and that this map is an accurate representation thereof to the best of my knowledge and belief.

DOUGLAS G. OLSON S-2093 ELKHORN, WI

Douglas G. Olson
Wisconsin Registered Land Surveyor - 2093

2003.152

Sheet 1 of 1 Sheets

Job Reference Number
2003.152

Legend
- Found County Section Corner
- Found Iron Pipe
- Found Iron Rod, 3/4" dia.
- ( ) Recorded Information
- Soil Boring
- Utility Box
- Asphalt Surface
- Concrete Cover
- Septic Vent

Jensen & Olson Land Surveying, LLC
45 South Wisconsin Street P.O. Box 322
Elkhorn, Wisconsin. 53121
Telephone (262) 723-3434
Facsimile (262) 723-8044

Scale in Feet
1" = 100'
0' 50' 100' 200'

Survey Date: January 5, 2004.
Revisions: No. 1 - Rezone Area
No. 2 - Proposed Hse.
No. 3 - Proposed Hse.
No. 4 - Bigger Deck
No. 5 - Foundation

NA3966-1

218-1653