
PREPARED FOR:
GINA NOCEK
KEEFE REAL ESTATE, INC.
751 GENEVA PARKWAY
LAKE GENEVA, WI 53147

# PLAT OF SURVEY

-OF-

LOT 3 OF CERTIFIED SURVEY MAP NO. 964, LOCATED IN THE NORTHWEST 1/4 OF SECTION 30, TOWN 2 NORTH, RANGE 18 EAST, WALWORTH COUNTY, WISCONSIN, RECORDED SEPTEMBER 7, 1979, IN VOL. 4 PAGE 221, IN THE OFFICE OF THE REGISTER OF DEEDS FOR WALWORTH COUNTY, WISCONSIN, AS DOC. NO. 51047.

KROTT SURVEYING INC.
N3705 WILLOW BEND LANE
LAKE GENEVA WI. 53147
PHONE # (262)248-3697
FAX # (262)249-0639

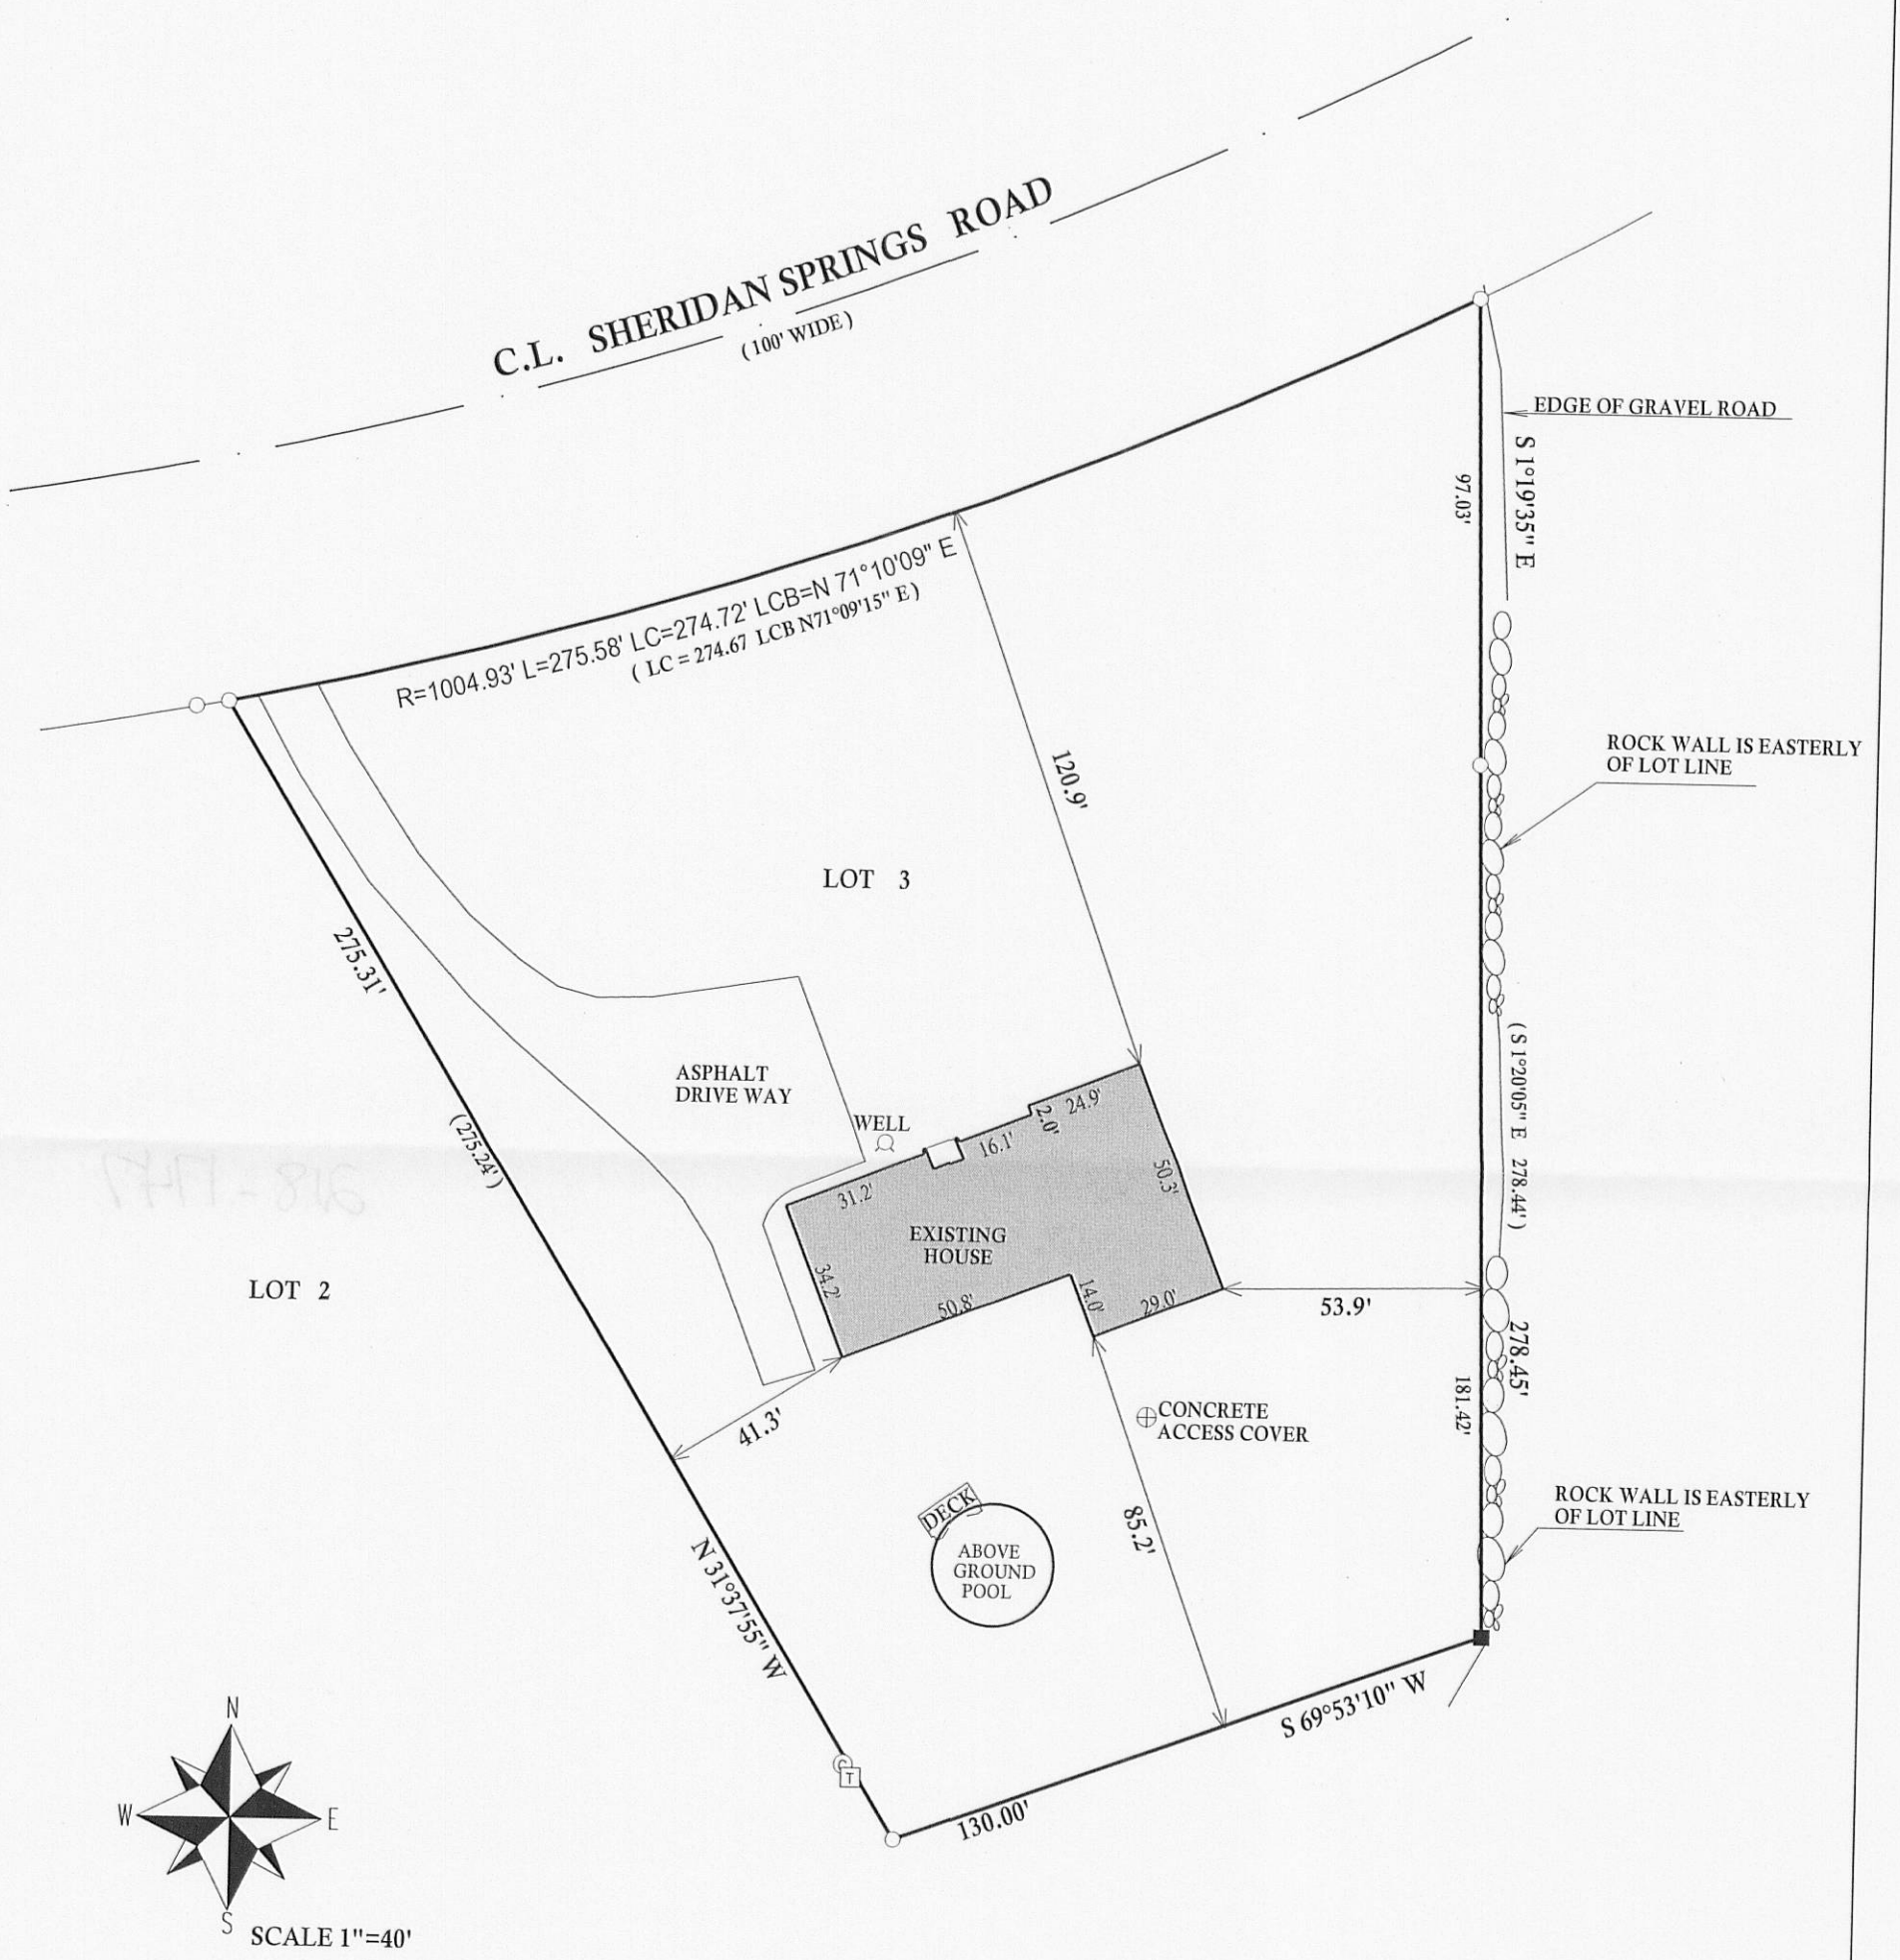


*LEGEND*

- © CABLE T.V. PEDESTAL
- T ELEC. TRANSFORMER
- ○ FOUND IRON PIPE
- □ FOUND IRON BAR
- ■ SET IRON BAR
- (XX) RECORDED AS

JOB #10-099 TAX ID # NA96400003

RECEIVED
JUN 21 2010
By

I have surveyed the above-described property and the above map is a true representation thereof and shows the size and location of the property, its exterior boundaries, the location and dimensions of all structures thereon, fences apparent easements and roadways and visible encroachments. if any.

This survey is made for the exclusive use of the present owners of the property, and also those who puchase, mortgage,or insure the title therto within one (1) year from date hereof; and as to them I warrant the accuracy of said survey map.

WISCONSIN
JOHN P.
KROTT
S-2258
LAKE GENEVA
WIS.
LAND SURVEYOR

DATED THIS 16th, DAY OF JUNE, 2010

JOHN KROTT S - 2258
Wisconsin Registered Land Surveyor
*( original if signed in red )*