
PREPARED FOR
JACK PEASE
2131 RIDGE DR.
LAKE GENEVA WI. 53147

KROTT SURVEYING INC.
N3705 WILLOW BEND LANE
LAKE GENEVA WI. 53147
PHONE # (262)248-3697
FAX # (262)249-0639

PLAT OF SURVEY

-OF-

LOT 10, SECOND ADDITION TO HEATHERIDGE, A SUBDIVISION IN THE SOUTHWEST 1/4 OF SECTION 18, TOWN 2 NORTH, RANGE 18 EAST, TOWN OF LYONS, COUNTY OF WALWORTH, STATE OF WISCONSIN.

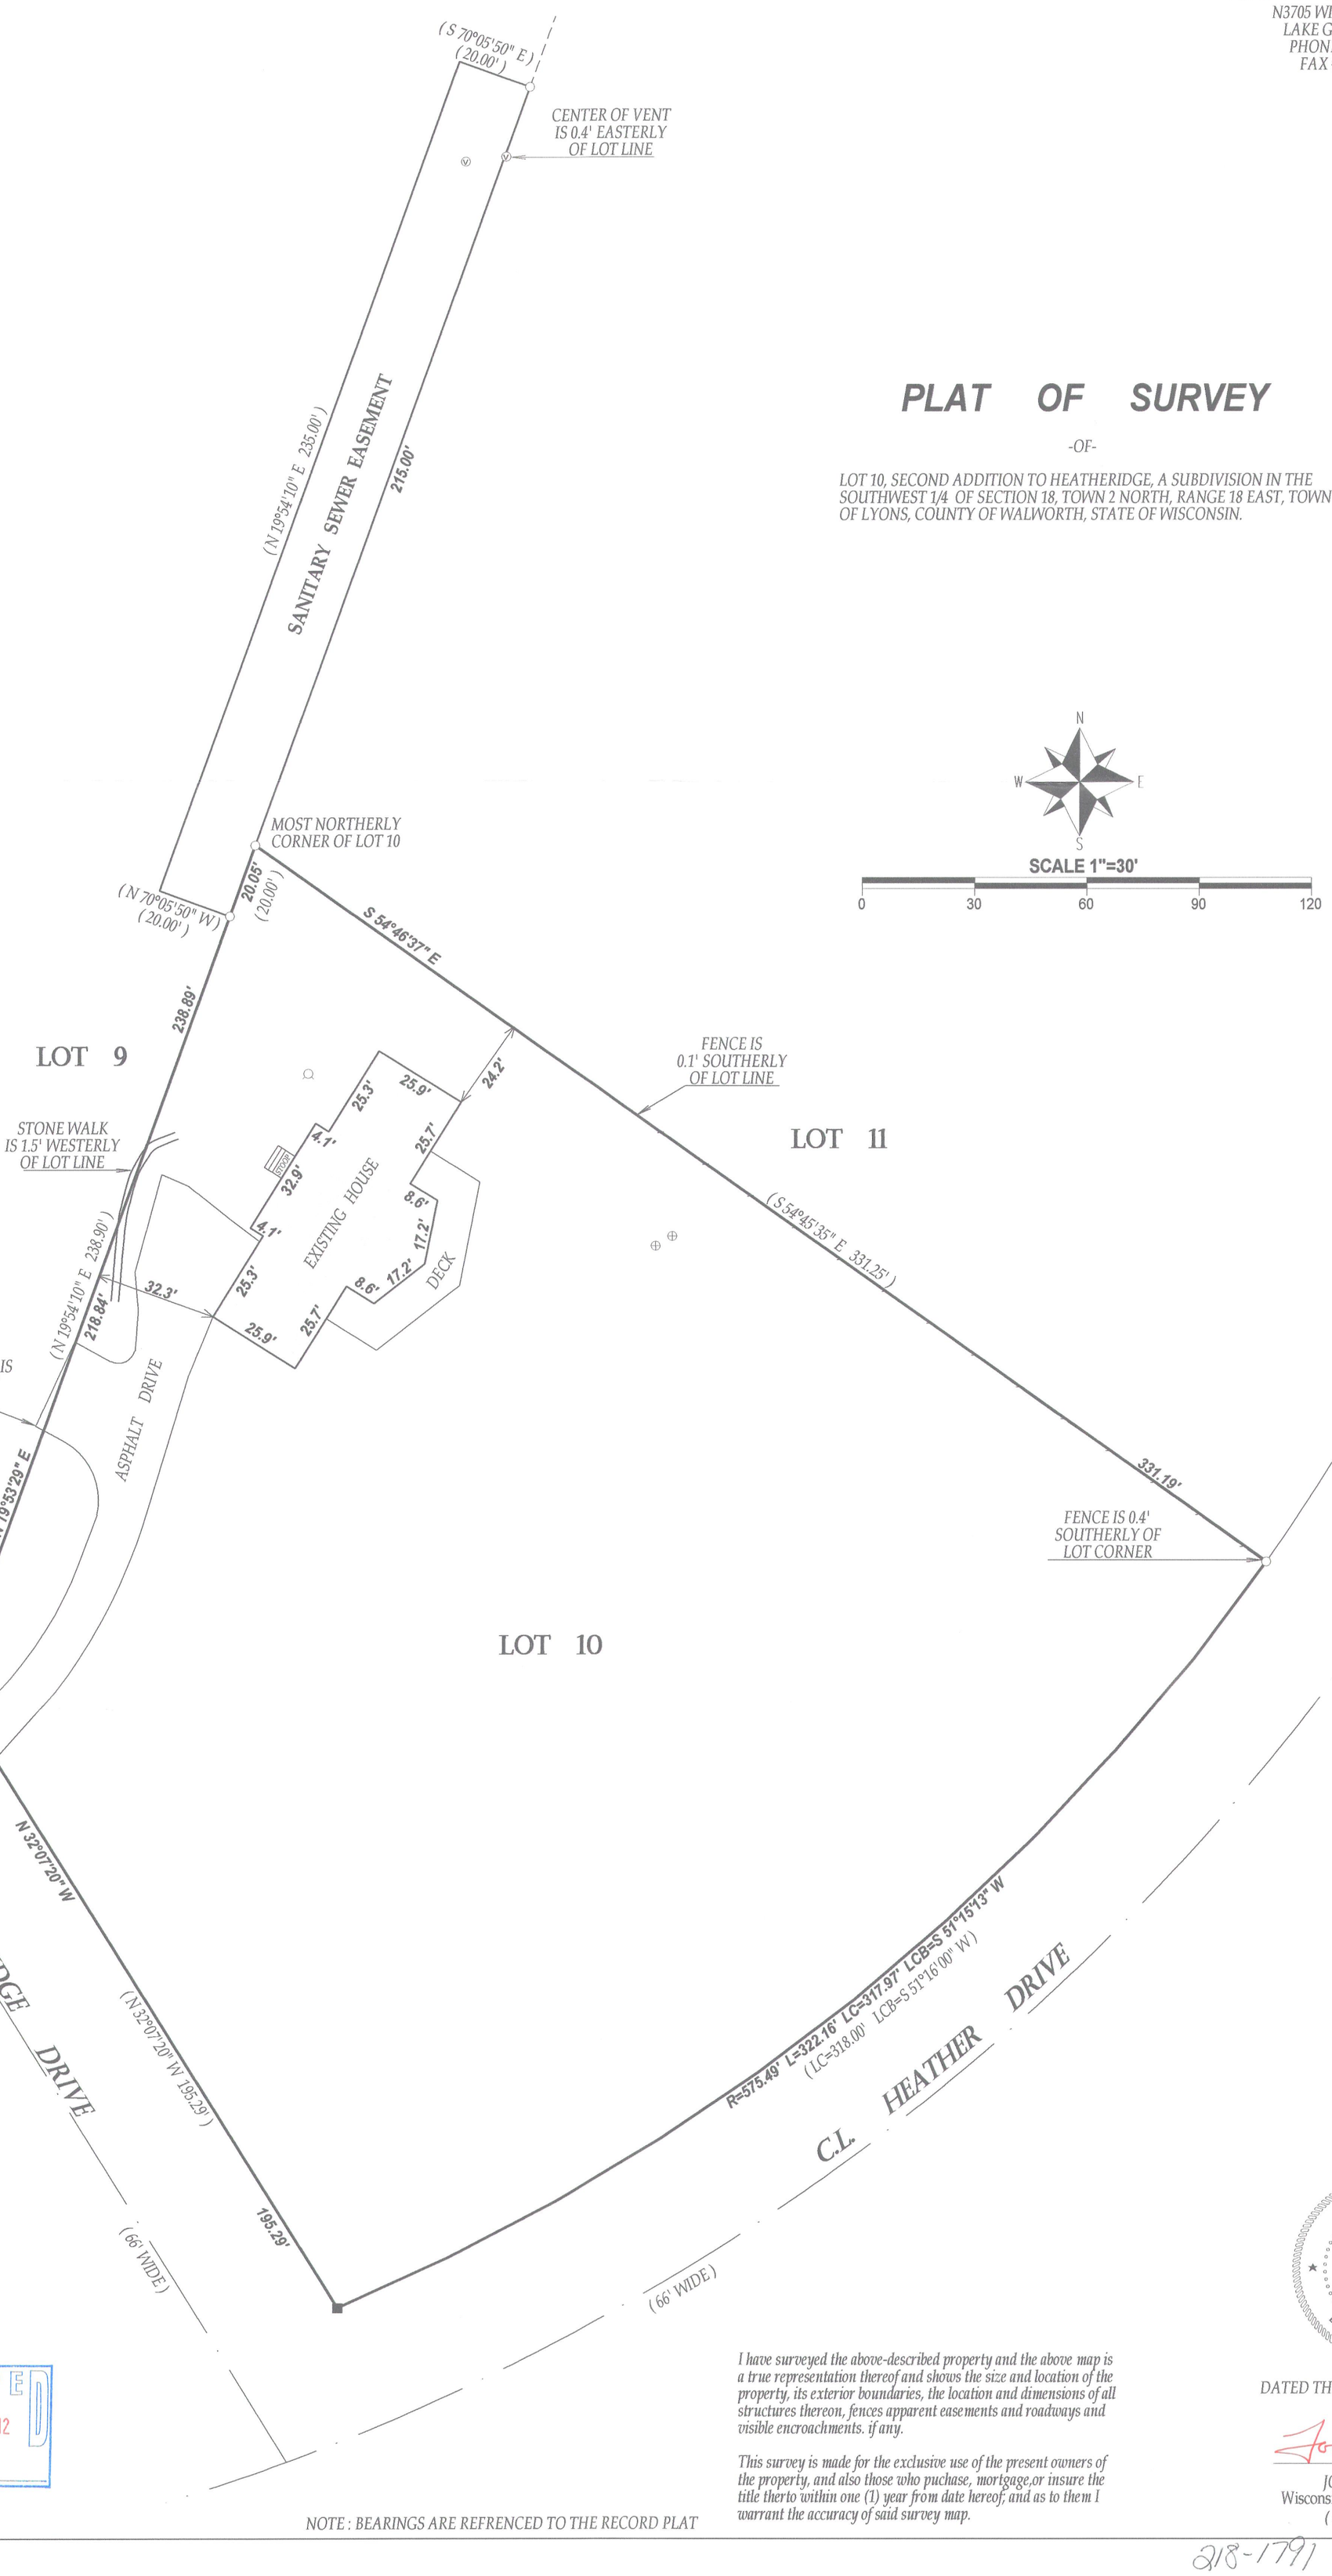

LEGEND

- ○ FOUND IRON PIPE
- ■ SET IRON BAR
- ⌾ WELL
- ⊕ CONCRETE LID
- Ⓥ VENT
- (XX) RECORDED AS

TAX ID # NDE200010

JOB # 12-039

RECEIVED
APR 18 2012
By SMF

NOTE : BEARINGS ARE REFRENCED TO THE RECORD PLAT

I have surveyed the above-described property and the above map is a true representation thereof and shows the size and location of the property, its exterior boundaries, the location and dimensions of all structures thereon, fences apparent easements and roadways and visible encroachments. if any.

This survey is made for the exclusive use of the present owners of the property, and also those who puchase, mortgage,or insure the title therto within one (1) year from date hereof; and as to them I warrant the accuracy of said survey map.

WISCONSIN
JOHN P.
KROTT
S-2258
LAKE GENEVA
WIS.
LAND SURVEYOR

DATED THIS 11th DAY OF APRIL 2012.

JOHN KROTT S - 2258
Wisconsin Registered Land Surveyor
(original if signed in red)

218-1791