


Plat of Survey

of


Lots 2 and 3 of Certified Survey Map No. 982,
recorded in Vol. 4 of Certified Survey Maps of Walworth County on
Page 247 and located in the Southwest 1/4 of Section 28, Town 2
North, Range 18 East, Town of Lyons, Walworth County, Wisconsin.

Surveyed for: Keith Hillegonds
1210 Rosedale Street
Houston, Texas. 77004


Lakeside Road
(66' Wide)

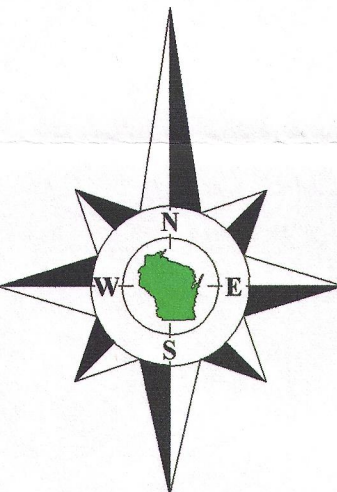

Bearings reference to Certified
Survey Map No. 982.

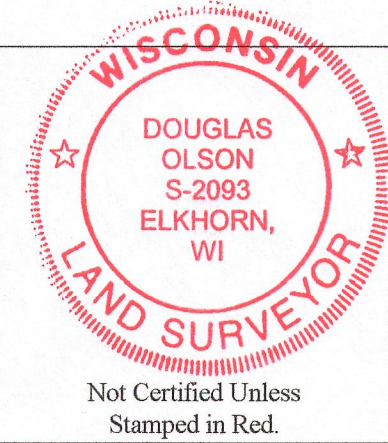

- Notes:
- 1) This survey plat is not certified unless signed and sealed in red ink.
 - 2) This survey is subject to Wisconsin lien laws. This Plat of Survey is the notice of intent to file lien. Lien waiver required.

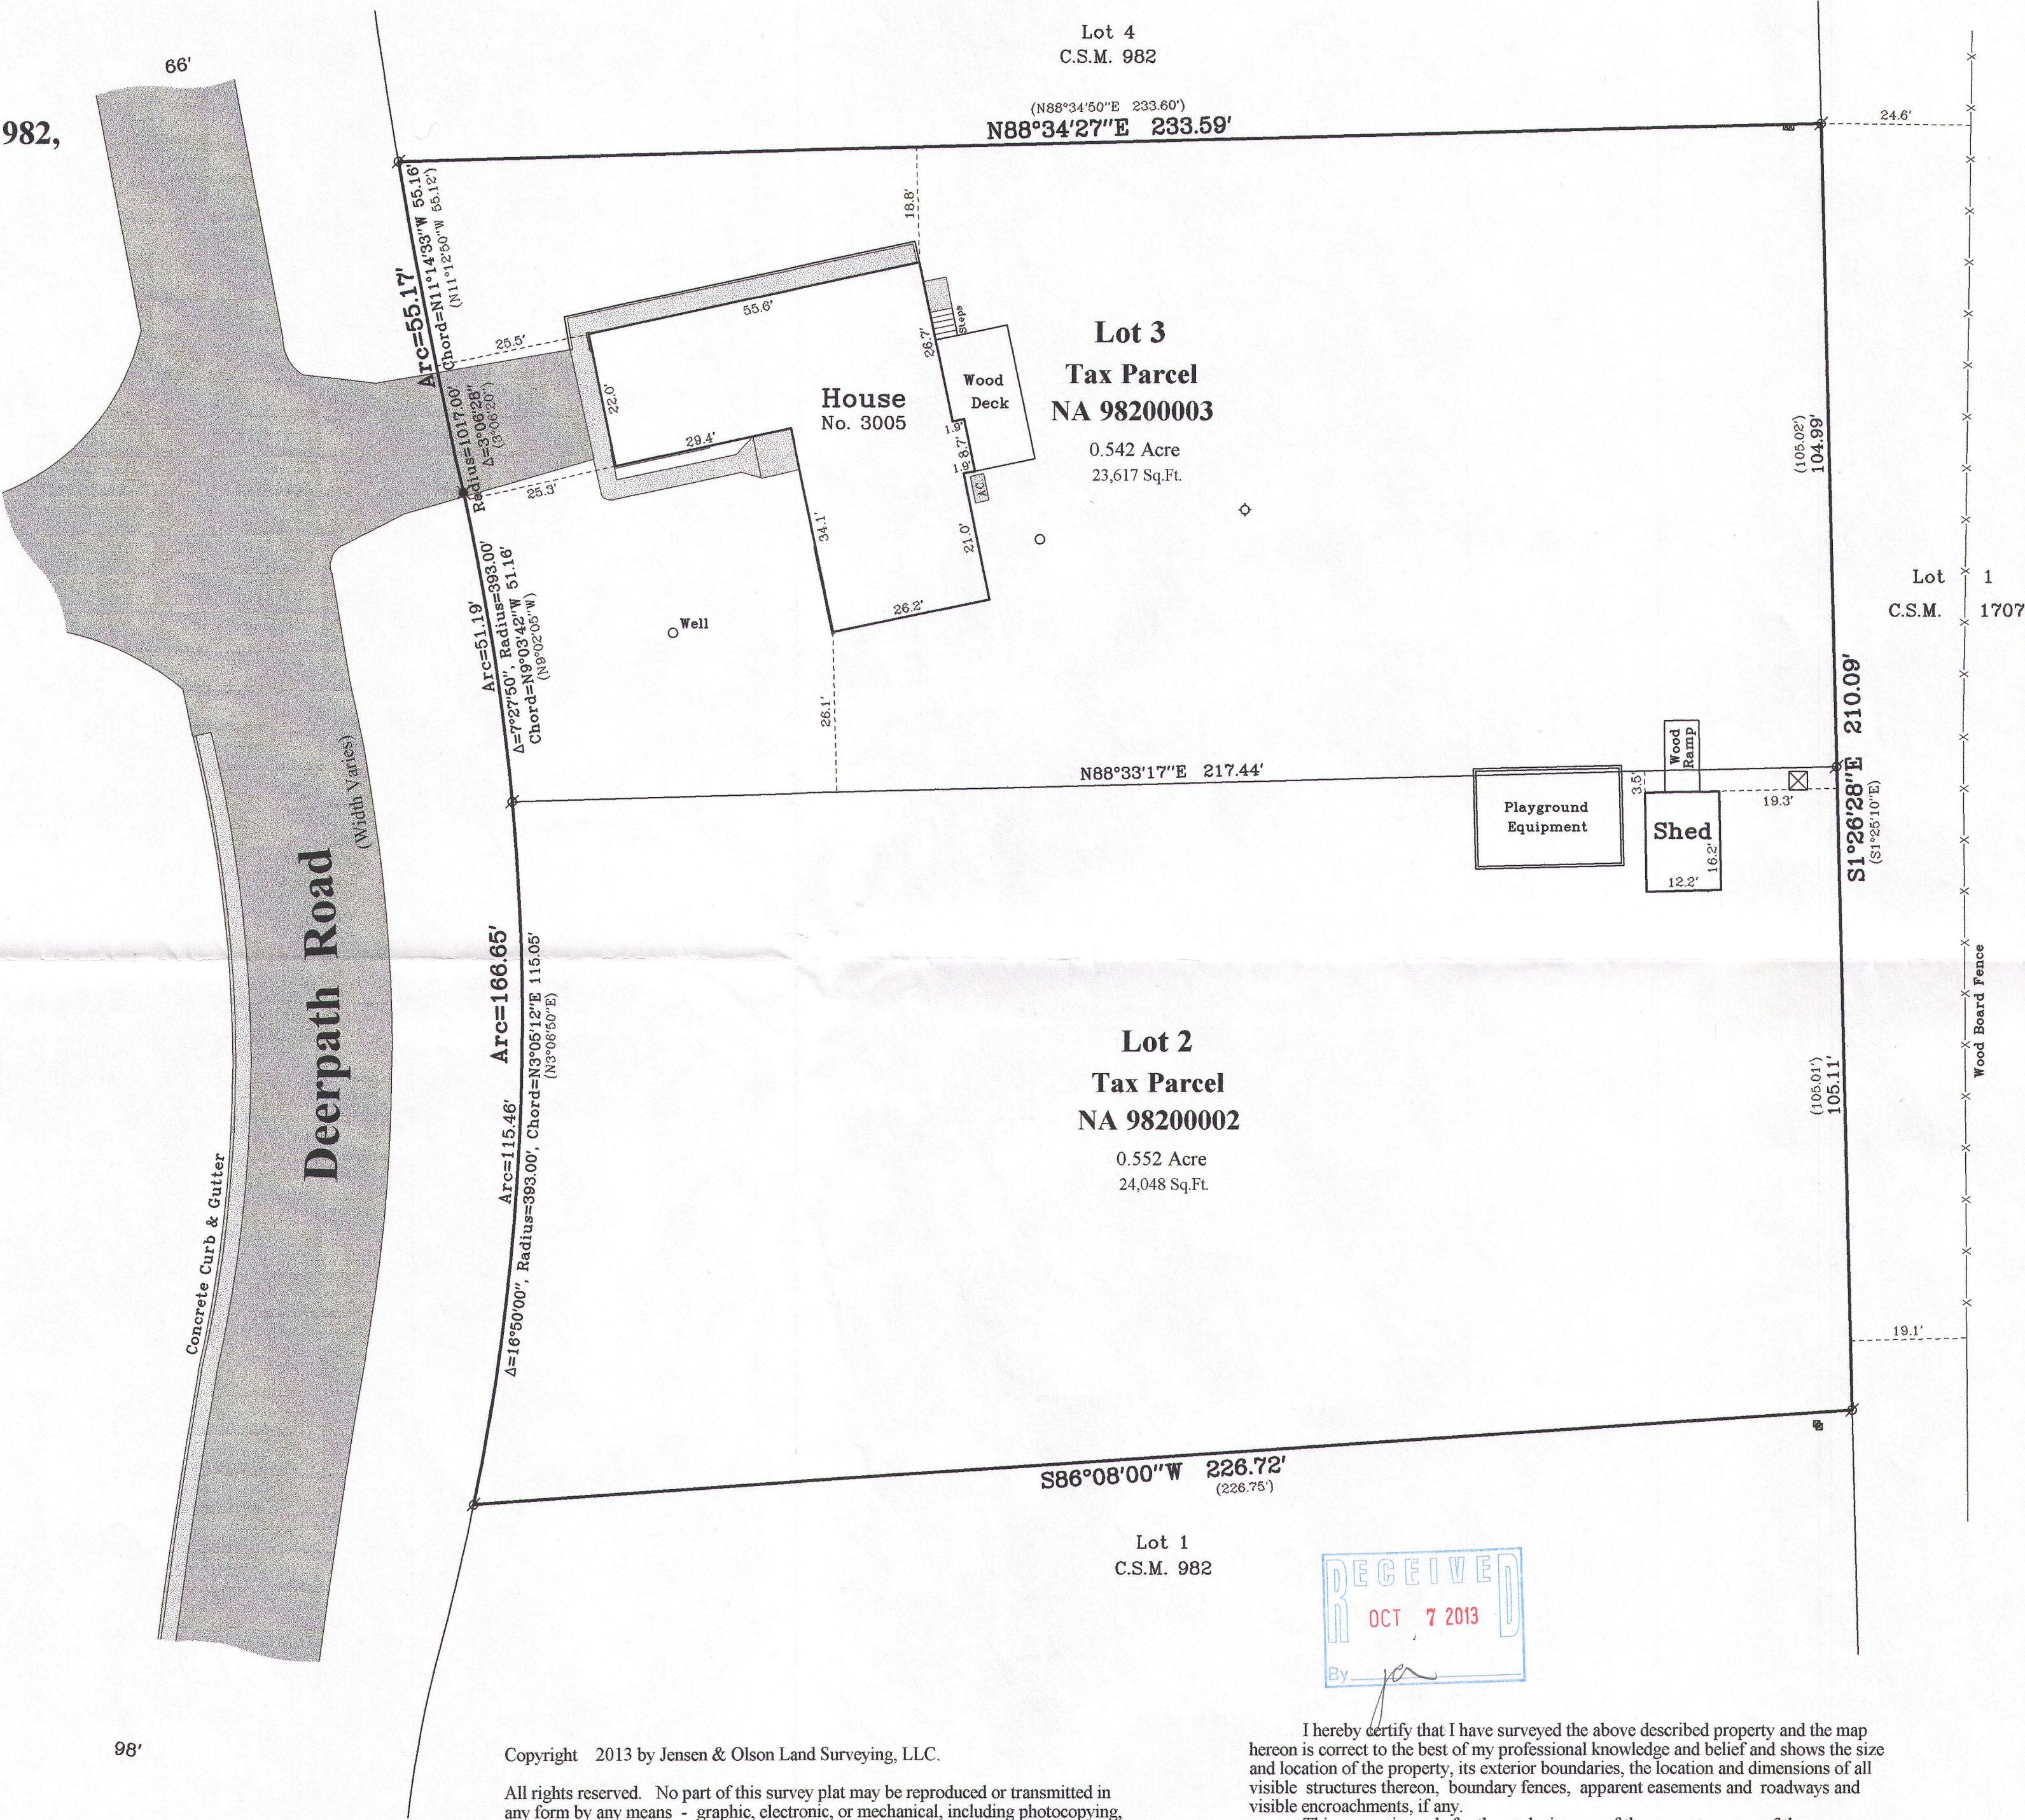


Copyright 2013 by Jensen & Olson Land Surveying, LLC.

All rights reserved. No part of this survey plat may be reproduced or transmitted in any form by any means - graphic, electronic, or mechanical, including photocopying, tracing, or information storage and retrieval systems - without permission in writing from Douglas G. Olson, Jensen & Olson Land Surveying, LLC.

I hereby certify that I have surveyed the above described property and the map hereon is correct to the best of my professional knowledge and belief and shows the size and location of the property, its exterior boundaries, the location and dimensions of all visible structures thereon, boundary fences, apparent easements and roadways and visible encroachments, if any.
This survey is made for the exclusive use of the present owners of the property, and also those who purchase, mortgage or guarantee title thereto, within one year from the date hereof.

Douglas G. Olson
Wisconsin Registered Land Surveyor - 2093

Survey Date: August 5, 2013.
Revisions:

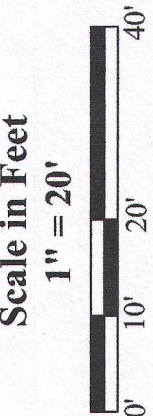

Jensen & Olson Land Surveying, LLC
45 South Wisconsin Street * P.O. Box 322 * Elkhorn, Wisconsin. 53121
Telephone: (262) 723-3434 * Facsimile: (262) 723-8044
Email: jensen.olson@elknet.net

- Legend
- Found Iron Pipe
 - Found Mag Nail
 - Recorded Information
 - Septic Vent
 - Utility Box or Pedestal
 - Asphalt Surface
 - Concrete Surface

Sheet 1 of 1 Sheets
Drawing Name: C:\18-2013085-2013085Plat.dwg
Job Reference Number
2013.085

2013.085

NA 982-3
NA 982-2
218-1842