
PREPARED FOR:
LAKE GENEVA AREA REALTY
101 BROAD ST
LAKE GENEVA, WI.

PLAT OF SURVEY

- OF -

PATHFINDER SURVEYING INC.
(formerly)
J.K. SURVEYING INC.
P.O BOX 322
LAKE GENEVA, WI. 53147
WWW.PATHFINDERSURVEYING.NET
262-248-8303

LOTS 120, 121 AND 122 LAKE GENEVA GOLG HILLS, A SUBDIVISION LOCATED IN SECTION 31, TOWN 3 NORTH, RANGE 18 EAST OF THE FOURTH PRINCIPAL MERIDIAN, TOWN OF LYONS, COUNTY OF WALWORTH AND STATE OF WISCONSIN.

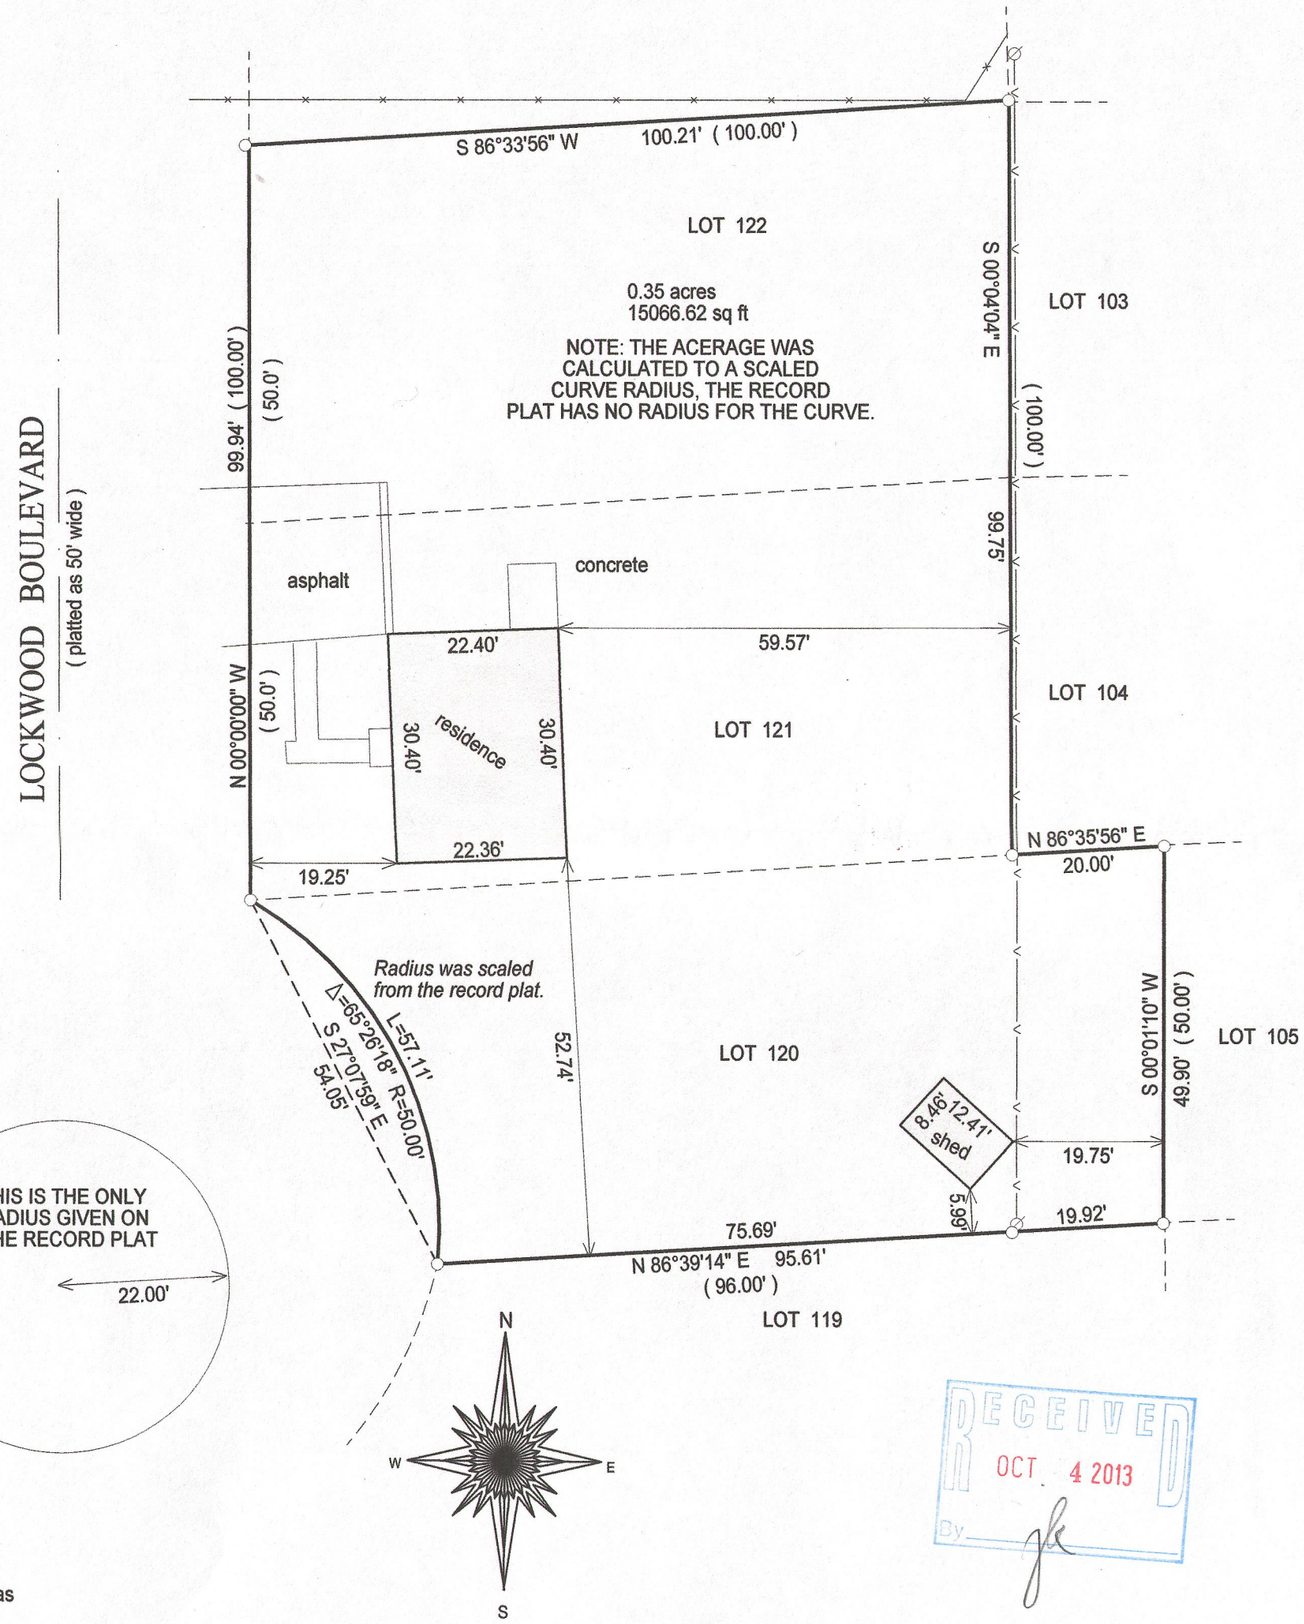

RECEIVED
OCT 4 2013
By jk

( )= recorded as
□ = found iron bar
○ = found iron pipe
● = set iron pipe
■ = set iron bar

SCALE 1" = 20'

JOB # 13-108

TAX ID # NGH 00092 & 93

20 0 20 40 60

BASIS OF BEARING OF THIS PLAT: THE EAST LINE OF LOCKWOOD BLVD. WAS ASSUMED TO BEAR NORTH.

I hereby certify that I have surveyed the above- described property and the above map is a is a true representation thereof and shows the size and location of the property, its exterior boundaries, the location and dimensions of all structures thereon, fences, apparant easements and roadways and visible encroachments if any.

This survey is made for the present owners of the property, and those who purchase, mortgage, or guarantee the title thereto, within one year from the date hereof.

DATED THIS 12th day of July, 2013.

WISCONSIN JEFFREY L. KIMPS S-2436 LAKE GENEVA. WIS. LAND SURVEYOR

JEFFREY L. KIMPS S - 2436
Wisconsin Registered Land Surveyor
(original if signed in red)

NGH —92
NGH —93

218-1844