
BOUNDARY & TOPOGRAPHIC MAPPING

LOT 29 IN TUSCANY OF LAKE GENEVA, PHASE 2
LOCATED IN THE SW 1/4 OF SECTION 34, TOWN 2 NORTH, RANGE 18 EAST, AND
THE NORTHWEST 1/4 OF SECTION 3, TOWN 1 NORTH, RANGE 18 EAST
WALWORTH COUNTY, WISCONSIN

a. The land referred to in the Commitment is described as follows:
Lot 29 in Tuscany of Lake Geneva, Phase 2, located in the Southwest 1/4 of Section 34, T2N, R18E, and the Northwest 1/4 of Section 3, T1N, R18E, Walworth County, Wisconsin.

Tax Key No. NTU2000005

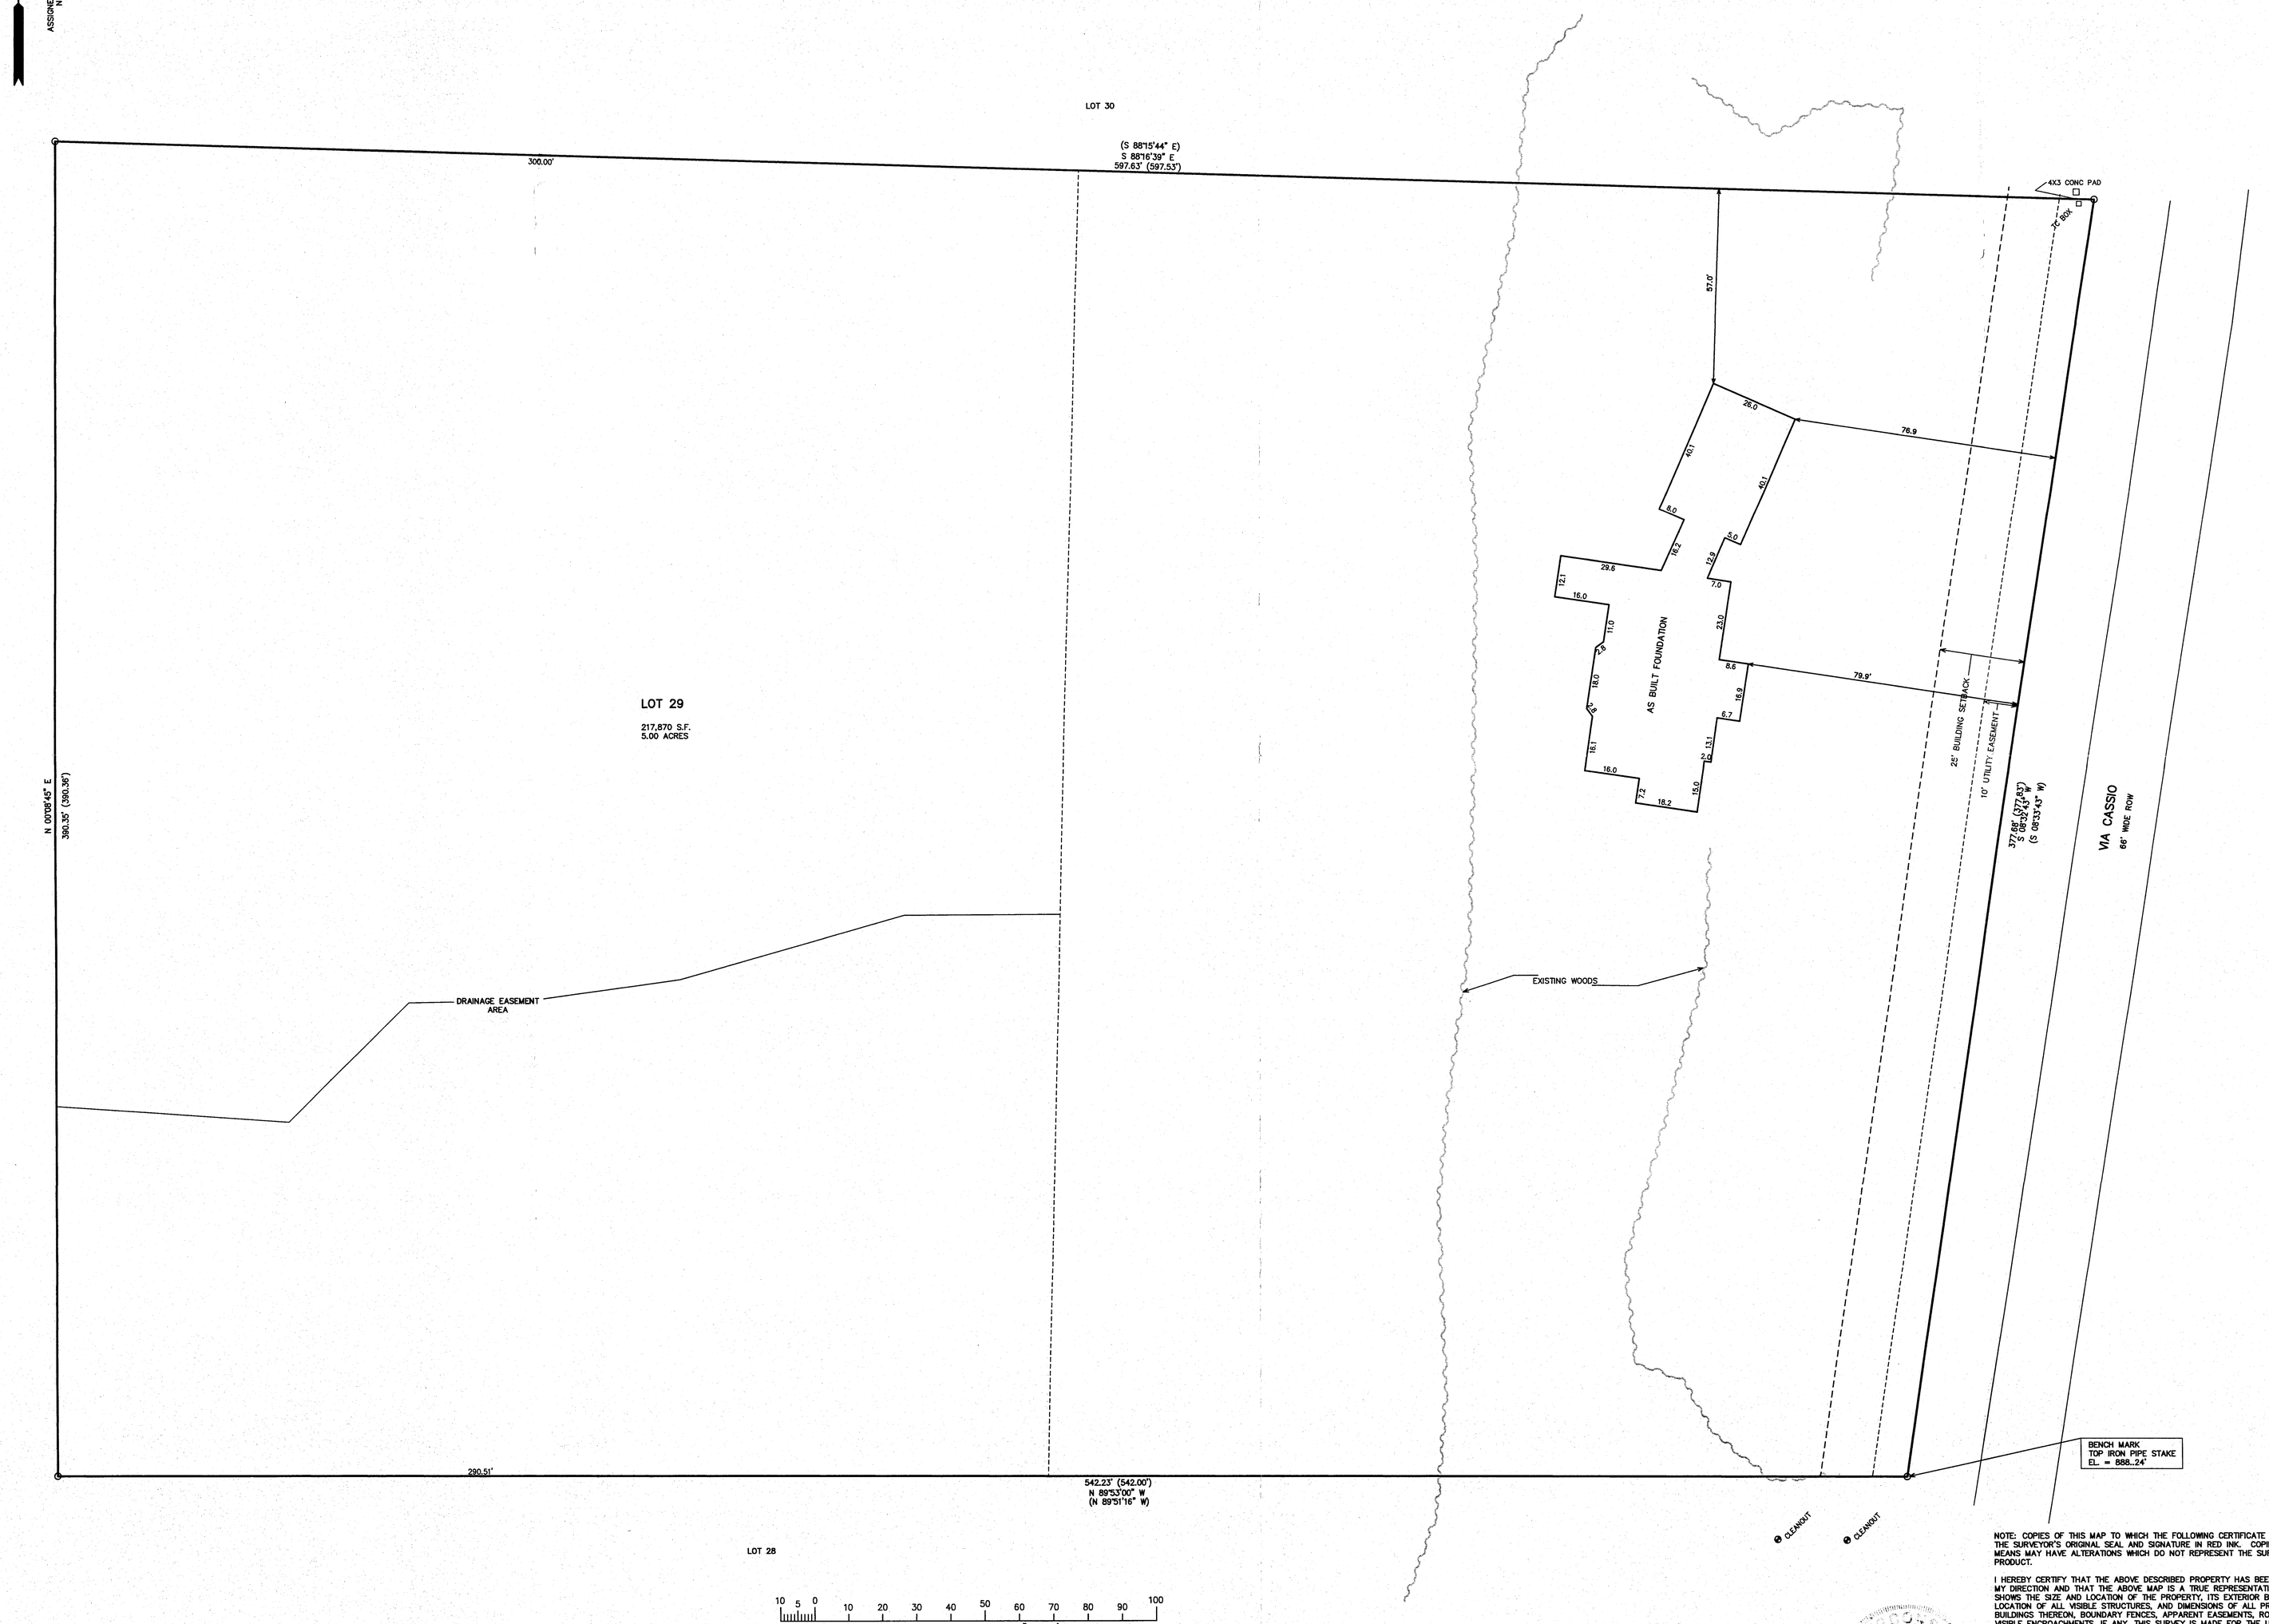

LEGEND
○ = FOUND IRON PIPE STAKE
(XXX) = RECORDED AS

NOV 27 2013

NOTE: COPIES OF THIS MAP TO WHICH THE FOLLOWING CERTIFICATE WILL APPLY SHOW THE SURVEYOR'S ORIGINAL SEAL AND SIGNATURE IN RED INK. COPIES BY ANY OTHER MEANS MAY HAVE ALTERATIONS WHICH DO NOT REPRESENT THE SURVEYOR'S WORK PRODUCT.

I HEREBY CERTIFY THAT THE ABOVE DESCRIBED PROPERTY HAS BEEN SURVEYED UNDER MY DIRECTION AND THAT THE ABOVE MAP IS A TRUE REPRESENTATION THEREOF AND SHOWS THE SIZE AND LOCATION OF THE PROPERTY, ITS EXTERIOR BOUNDARIES, THE LOCATION OF ALL VISIBLE STRUCTURES, AND DIMENSIONS OF ALL PRINCIPLE BUILDINGS THEREON, BOUNDARY FENCES, APPARENT EASEMENTS, ROADWAYS, AND VISIBLE ENCROACHMENTS, IF ANY. THIS SURVEY IS MADE FOR THE USE OF THE PRESENT OWNERS OF THE PROPERTY, AND ALSO THOSE WHO PURCHASE, MORTGAGE, OR GUARANTEE THE TITLE THERETO WITHIN ONE YEAR FROM THE DATE HEREOF.

DATED: JULY 26, 2005

PETER S. GORDON

REVISED 05-23-2013
RESURVEY & ADD TOPOGRAPHIC DETAILS

REVISED 11-06-2013
TO SHOW SIZE & LOCATION OF
AS BUILT FOUNDATION

WORK ORDERED BY:
KAREN MURRAY
352 REGATTA DRIVE
PORT WASHINGTON, WI. 53074

FARRIS, HANSEN & ASSOCIATES, INC.
ENGINEERING – ARCHITECTURE – SURVEYING
7 RIDGWAY COURT P.O. BOX 437
ELKHORN, WISCONSIN 53121
OFFICE: (262) 723-2098 FAX: (262) 723-5886

REVISIONS

PROJECT NO.
6846.13
DATE
05-14-2013
SHEET NO.
1 OF 1

NOV 27 2013

11/8/2013 X:\Projects\6846\DGN\TOPO

NTU2 -5 218-1849