Plat of Survey

of


Lot 1 of Certified Survey Map No. 4591,

recorded in Vol. 30 of Certified Survey Maps of Walworth County on Page 127 and located in the Southwest 1/4 of Section 7, Town 2 North, Range 18 East, Town of Lyons, Walworth County, Wisconsin.

Surveyed for:

Coldwell Banker, Leith & Associates

102 North Wisconsin Street
Elkhorn, Wisconsin. 53121

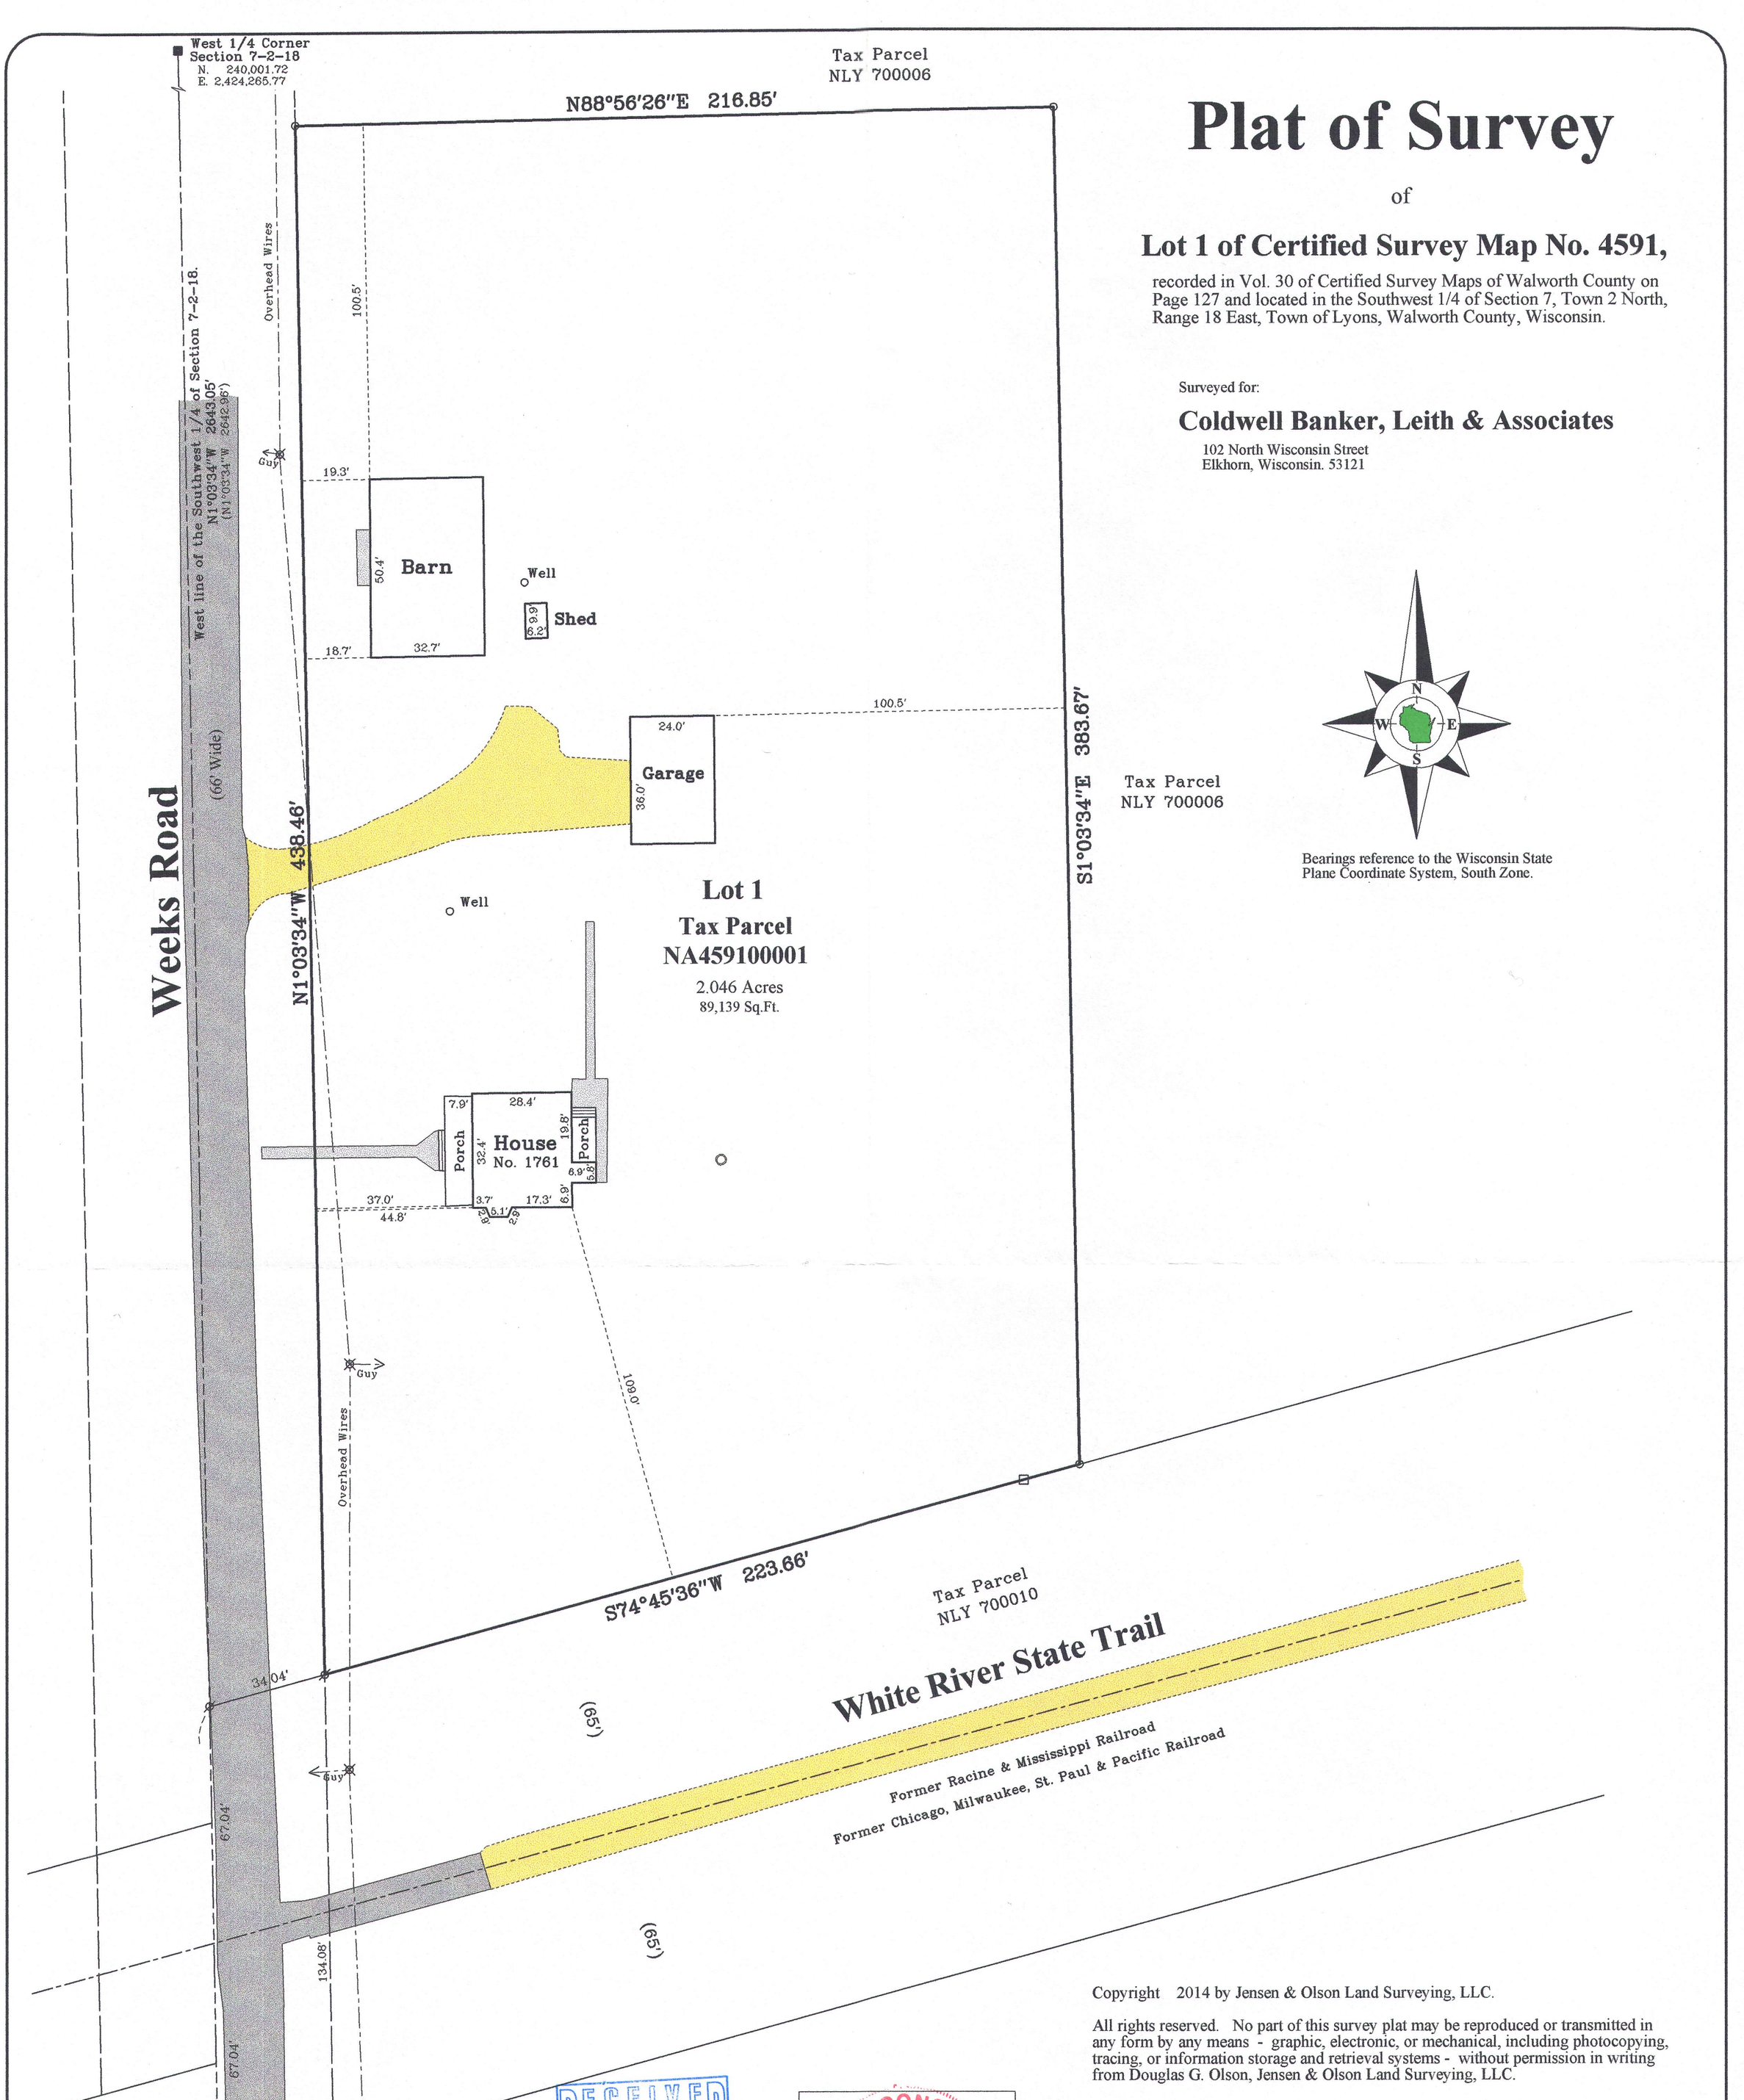

Bearings reference to the Wisconsin State Plane Coordinate System, South Zone.

Notes:

1) This survey plat is not certified unless signed and sealed in red ink.

2) This survey is subject to Wisconsin lien laws. This Plat of Survey is the notice of intent to file lien. Lien waiver required.

RECEIVED
JUN 1 2015
By

WISCONSIN
DOUGLAS OLSON
S-2093
ELKHORN, WI
LAND SURVEYOR

Not Certified Unless Stamped in Red.

Copyright 2014 by Jensen & Olson Land Surveying, LLC.

All rights reserved. No part of this survey plat may be reproduced or transmitted in any form by any means - graphic, electronic, or mechanical, including photocopying, tracing, or information storage and retrieval systems - without permission in writing from Douglas G. Olson, Jensen & Olson Land Surveying, LLC.

I hereby certify that I have surveyed the above described property and the map hereon is correct to the best of my professional knowledge and belief and shows the size and location of the property, its exterior boundaries, the location and dimensions of all visible structures thereon, boundary fences, apparent easements and roadways and visible encroachments, if any.

This survey is made for the exclusive use of the present owners of the property, and also those who purchase, mortgage or guarantee title thereto, within one year from the date hereof.

Douglas G. Olson
Wisconsin Professional Land Surveyor - 2093

2014.134

Sheet 1 of 1 Sheets

Drawing Name:

Job Reference Number
2014.134

Legend
- Found County Section Corner
- Found Iron Pipe
- Set Iron Pipe, 1" dia.
- ( ) Recorded Information
- Utility Pole
- Septic Vent
- Concrete Cover
- Asphalt Surface
- Concrete Surface
- Gravel

Jensen & Olson Land Surveying, LLC
45 South Wisconsin Street * P.O. Box 322 * Elkhorn, Wisconsin. 53121
Telephone: (262) 723-3434 * Facsimile: (262) 723-8044
Email: jensen.olson@elknet.net

Scale in Feet
1" = 30'
0' 15' 30' 60'

Survey Date: February 28, 2015.
Revisions: No. 1 – Recorded CSM

NA4591-1 218-1891