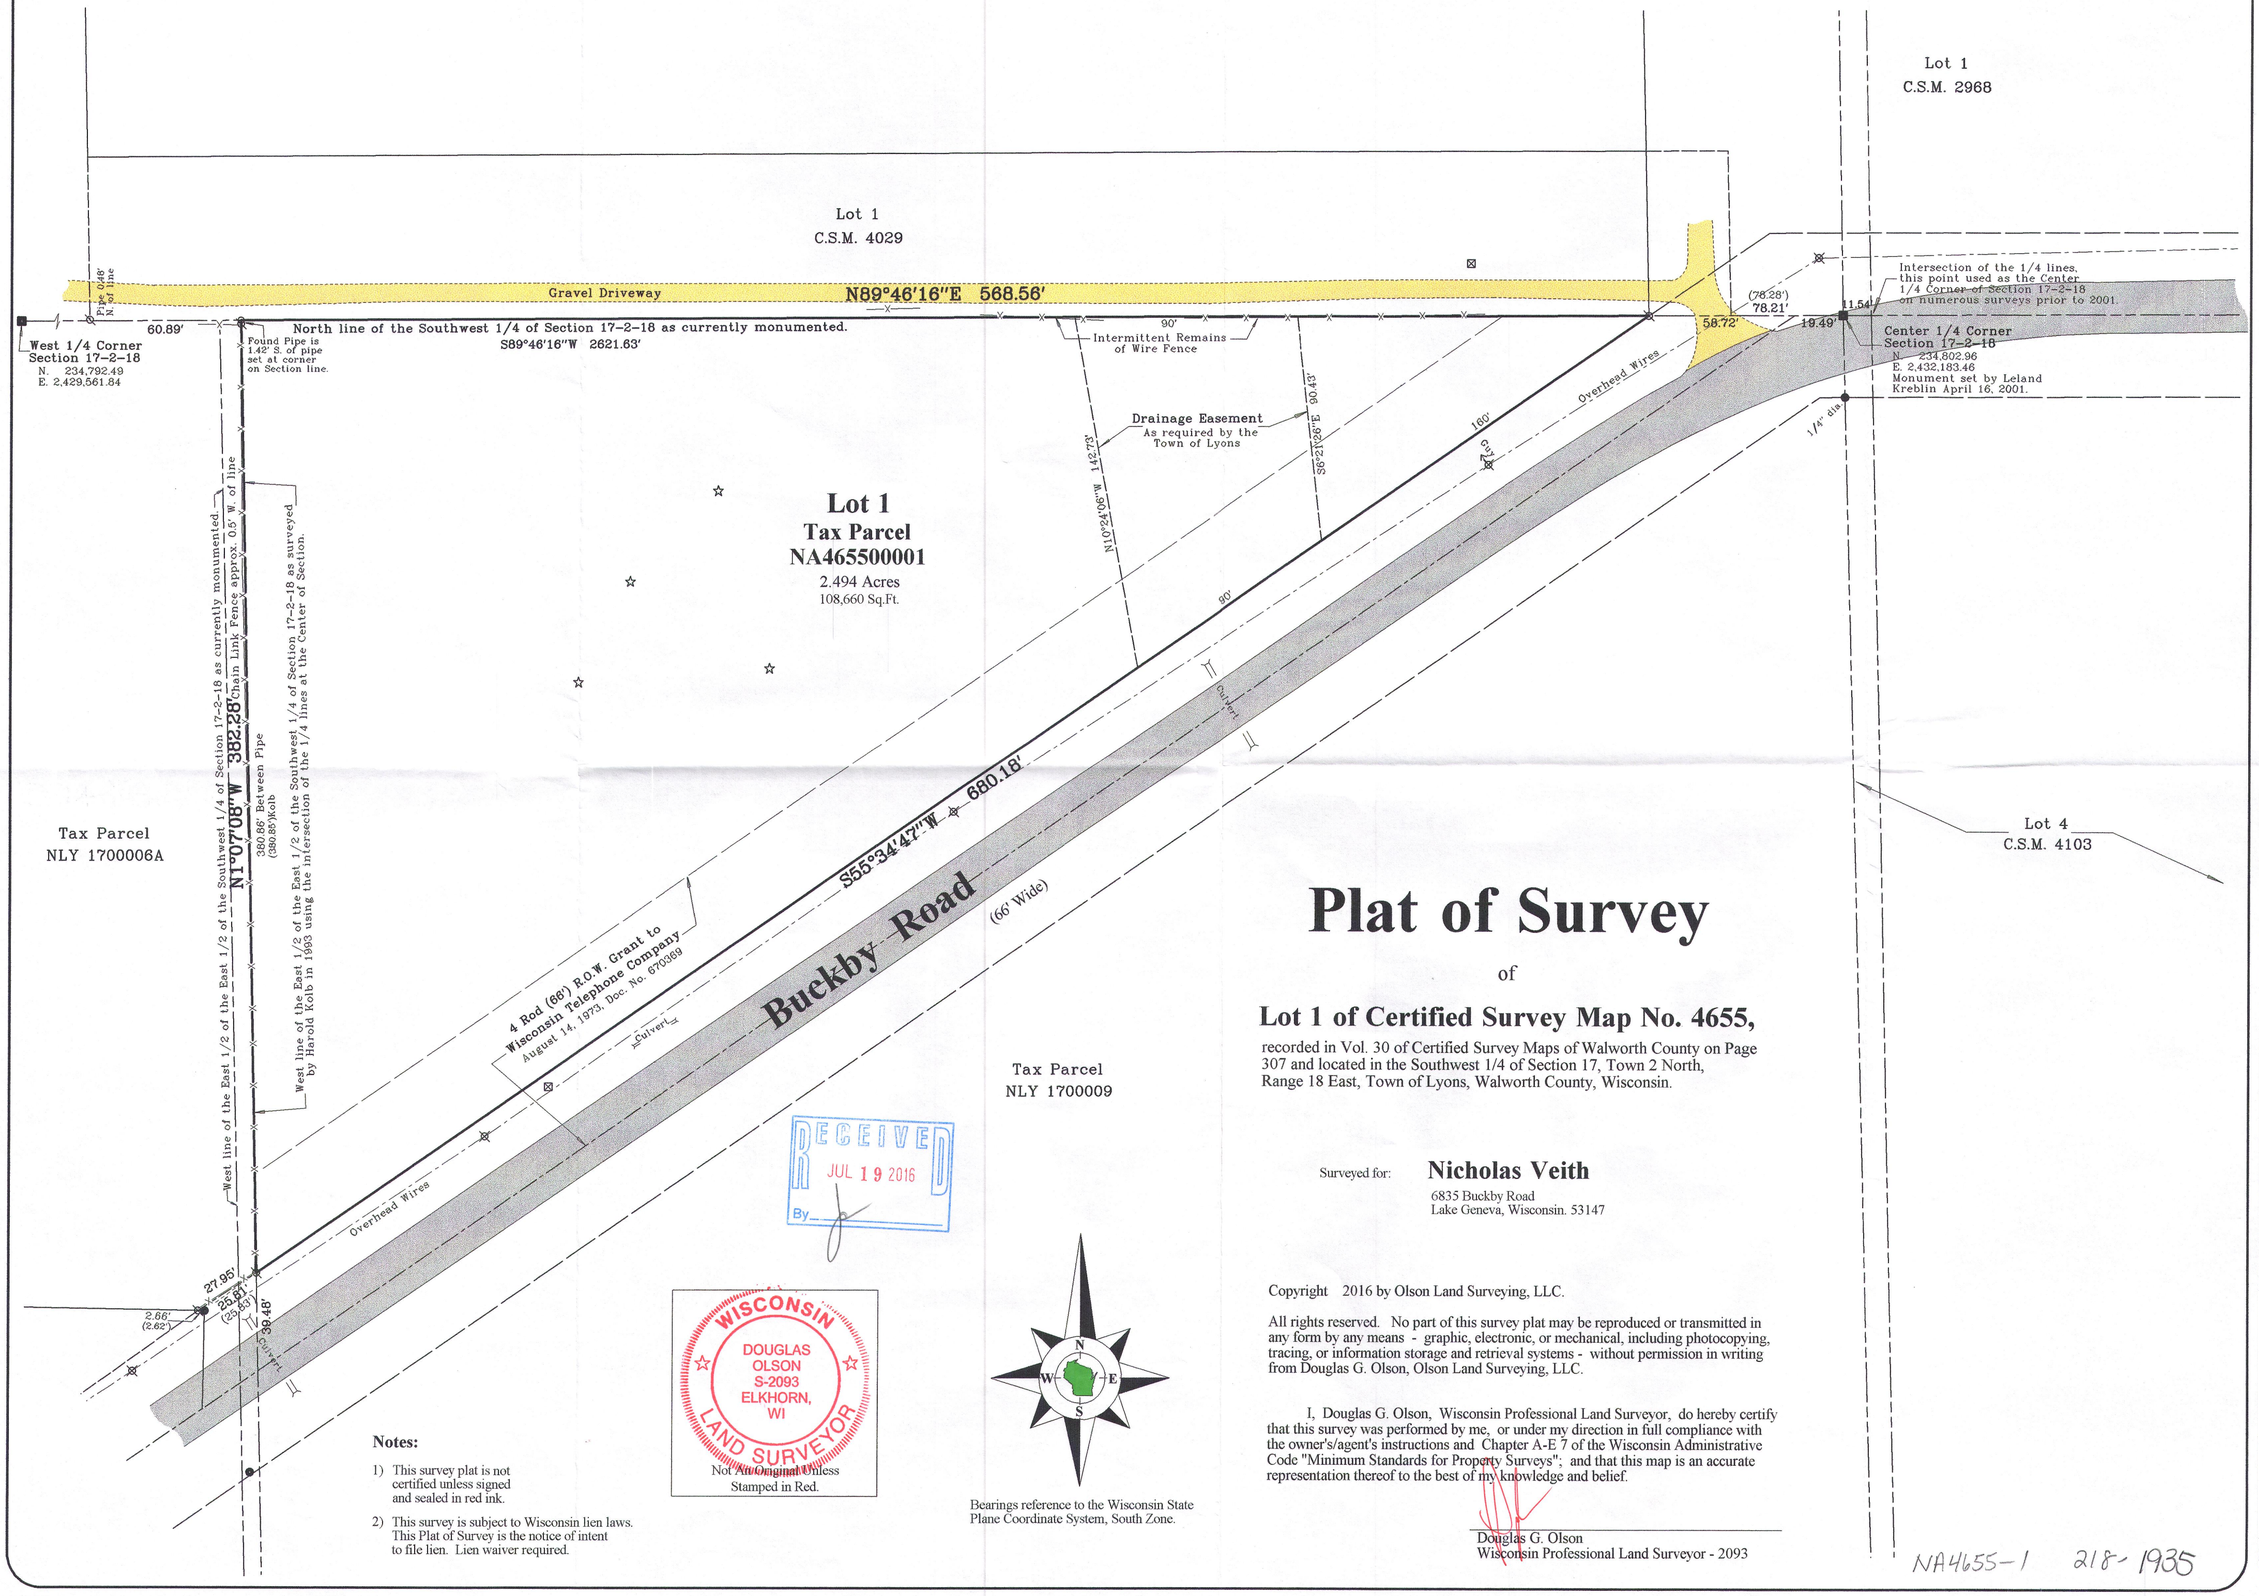


Plat of Survey

of

Lot 1 of Certified Survey Map No. 4655,

recorded in Vol. 30 of Certified Survey Maps of Walworth County on Page 307 and located in the Southwest 1/4 of Section 17, Town 2 North, Range 18 East, Town of Lyons, Walworth County, Wisconsin.

Surveyed for: **Nicholas Veith**
6835 Buckby Road
Lake Geneva, Wisconsin. 53147

Copyright 2016 by Olson Land Surveying, LLC.

All rights reserved. No part of this survey plat may be reproduced or transmitted in any form by any means - graphic, electronic, or mechanical, including photocopying, tracing, or information storage and retrieval systems - without permission in writing from Douglas G. Olson, Olson Land Surveying, LLC.

I, Douglas G. Olson, Wisconsin Professional Land Surveyor, do hereby certify that this survey was performed by me, or under my direction in full compliance with the owner's/agent's instructions and Chapter A-E 7 of the Wisconsin Administrative Code "Minimum Standards for Property Surveys"; and that this map is an accurate representation thereof to the best of my knowledge and belief.

Douglas G. Olson
Wisconsin Professional Land Surveyor - 2093

RECEIVED
JUL 19 2016
By

WISCONSIN
DOUGLAS OLSON S-2093 ELKHORN, WI
LAND SURVEYOR
Not An Original Unless Stamped in Red.

Notes:

1) This survey plat is not certified unless signed and sealed in red ink.

2) This survey is subject to Wisconsin lien laws. This Plat of Survey is the notice of intent to file lien. Lien waiver required.

Bearings reference to the Wisconsin State Plane Coordinate System, South Zone.

NA4655-1 218-1935

Survey Date: March 11, 2016.
Revisions: No. 1 - Recorded CSM

Scale in Feet
1" = 40'
0' 20' 40' 80'

Olson Land Surveying, LLC
45 South Wisconsin Street * P.O. Box 322 * Elkhorn, Wisconsin. 53121
Telephone: (262) 723-3434 * Facsimile: (262) 723-8044
Email: doug@olsonsurveying.com

Legend
- Found County Section Corner
- Found Iron Pipe, 1" dia.
- Found Iron Rod, 3/4" dia.
- Set 1/4" dia. Iron Rod
- Utility Information
- Utility Pole
- Soil Boring
- Utility Pedestal
- Asphalt Surface
- Gravel Surface

Sheet 1 of 1 Sheets
Drawing Name:
Job Reference Number
2016.003

2016.003