
PLAT OF SURVEY
–FOR–
PROPOSED REZONE
–OF–

LOT 1 OF CERTIFIED SURVEY MAP NO. 904 AND LOT 1 OF CERTIFIED SURVEY MAP NO. 971 AS RECORDED IN THE OFFICE OF THE REGISTER OF DEEDS IN AND FOR WALWORTH COUNTY WISCONSIN AND BEING PART OF THE NORTHWEST 1/4 OF THE SOUTHEAST 1/4 OF SECTION 4, TOWNSHIP 2 NORTH, RANGE 18 EAST OF THE FOURTH PRINCIPAL MERIDIAN, IN THE TOWNSHIP OF LYONS, WALWORTH COUNTY, WISCONSIN.

SURVEY FOR: SCOTT KOSTER

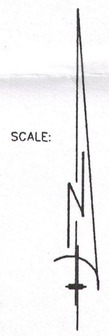

LEGEND

- FOUND WALWORTH COUNTY MONUMENT (CONC./CAP)
- FOUND IRON PIPE


BEARINGS HEREON RELATE TO THE WEST LINE OF THE SOUTHEAST 1/4 OF SECTION 4–2–18, ASSUMED BEARING NORTH 01°32'00" WEST.

GRAPHIC SCALE

40 20 0 40

"I hereby certify that I have surveyed the above described property and that the above map is a correct representation thereof and shows the size and location of the property, its exterior boundaries, the location of all visible structures and dimensions of all principal buildings thereon, boundary fences, apparent easements, roadways and encroachments, if any."

"This survey is made for the use of the present owners of the property, and those who purchase, mortgage, or guarantee the title thereto within one year from date hereof."

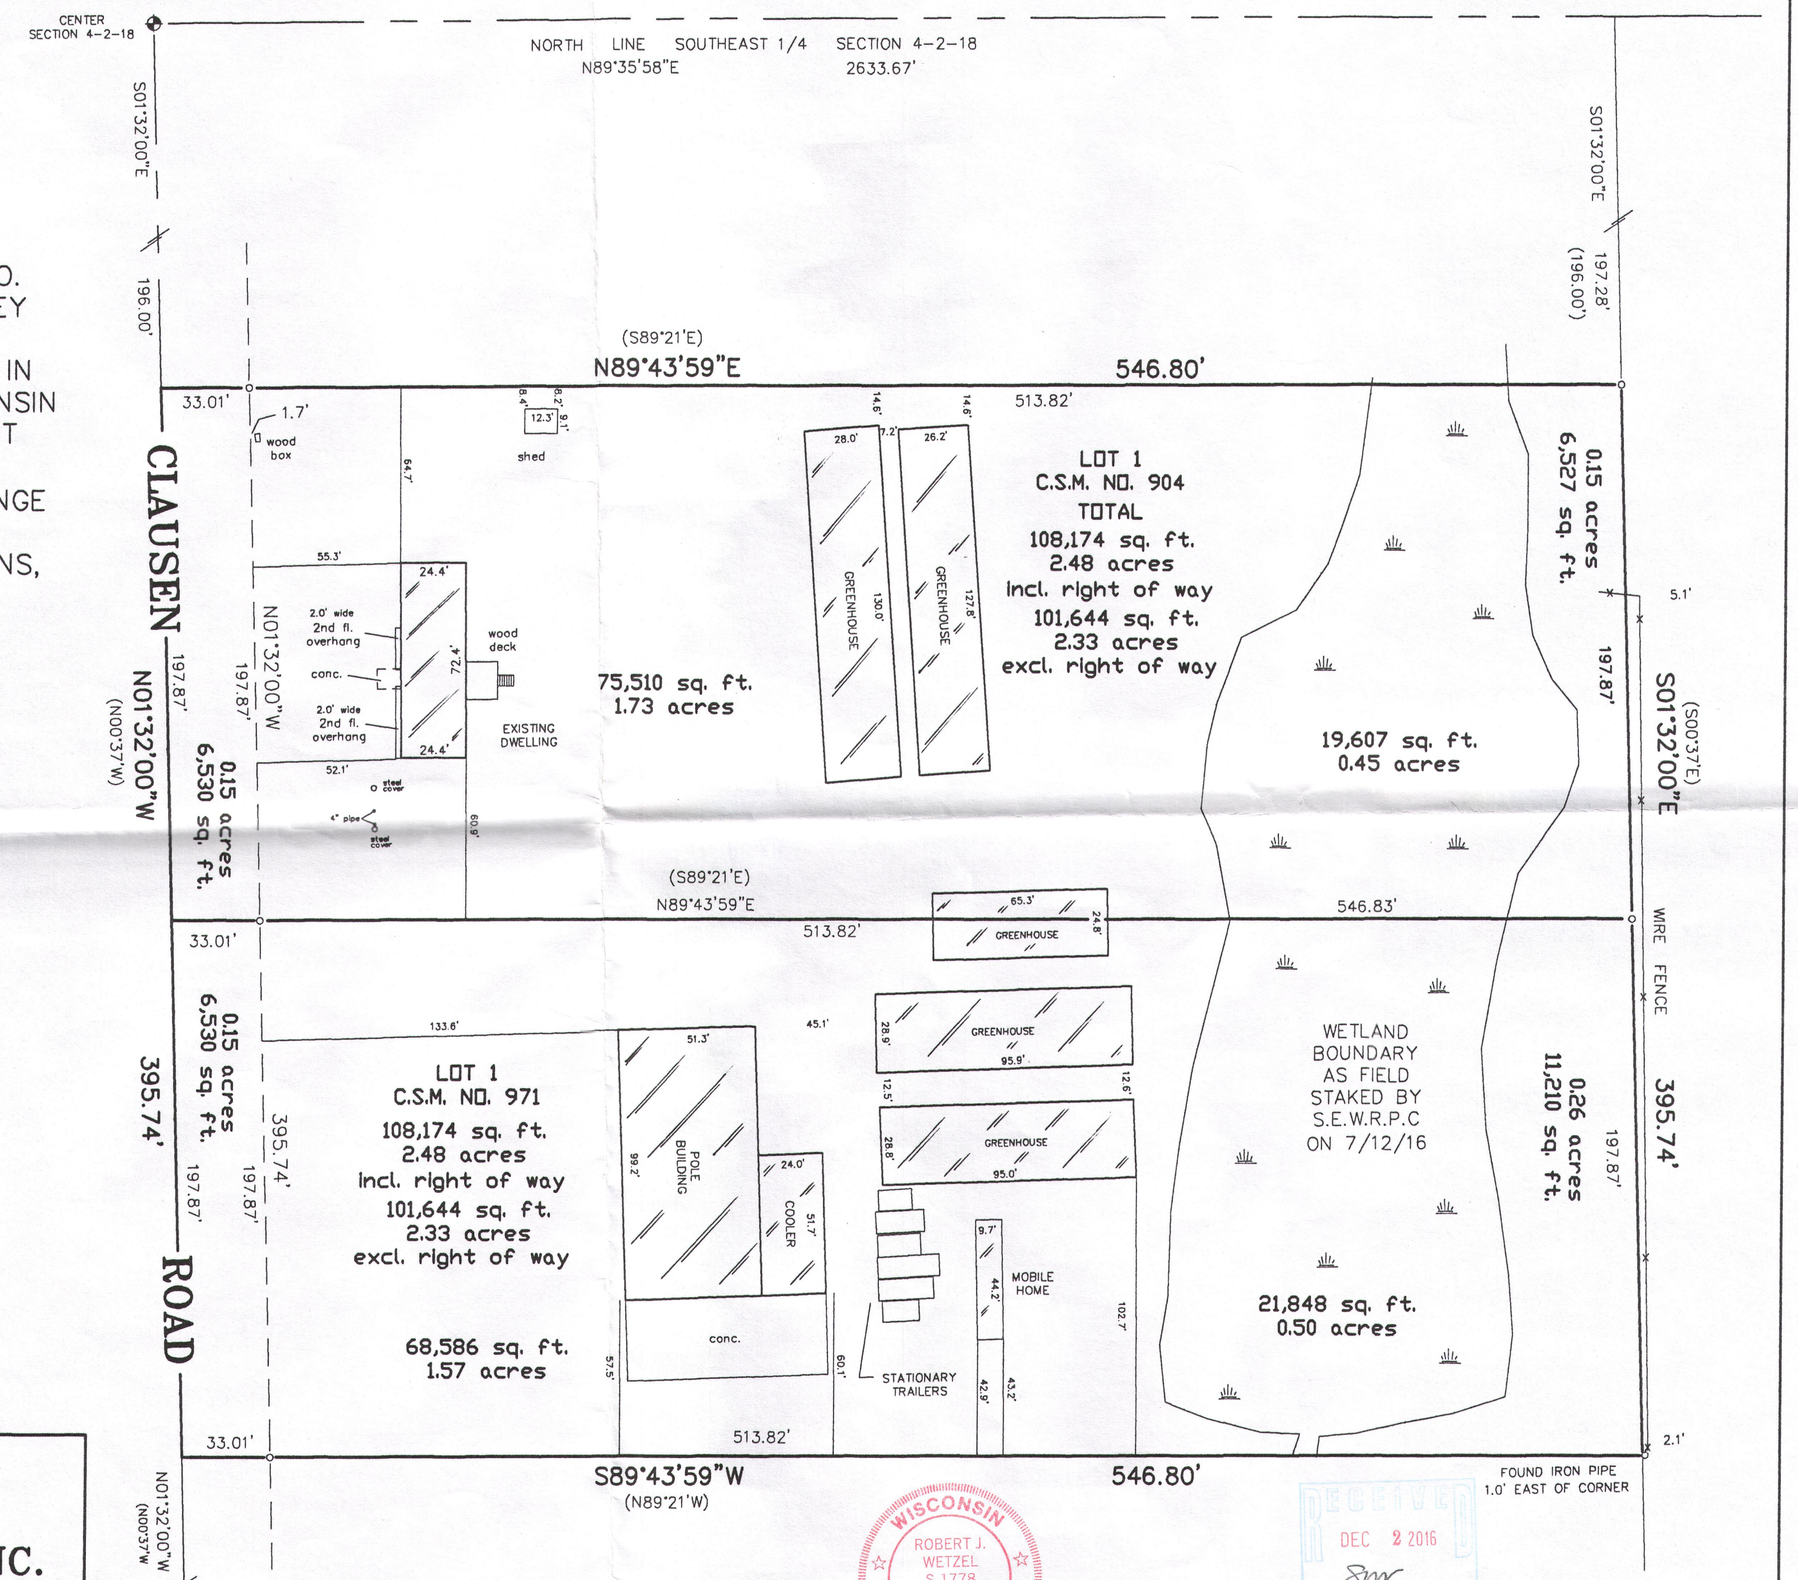

B.W. SURVEYING, INC.

412 N. PINE STREET
BURLINGTON, WI 53105
(262)–767–0225

NA904-1 NA971-1

WISCONSIN
ROBERT J. WETZEL
S-1778
BURLINGTON, WI
LAND SURVEYOR

THIS IS NOT AN ORIGINAL PRINT UNLESS THIS SEAL IS RED.

ROBERT J. WETZEL S-1778

218-9776

RECEIVED
DEC 2 2016
By SMK

DRAWN BY:	bw	DATE:	AUGUST 22, 2016
CHECKED BY:	rw/dw	DRAWING NO.:	9184d1
JOB NO.:	9184	SHEET	1 OF 1