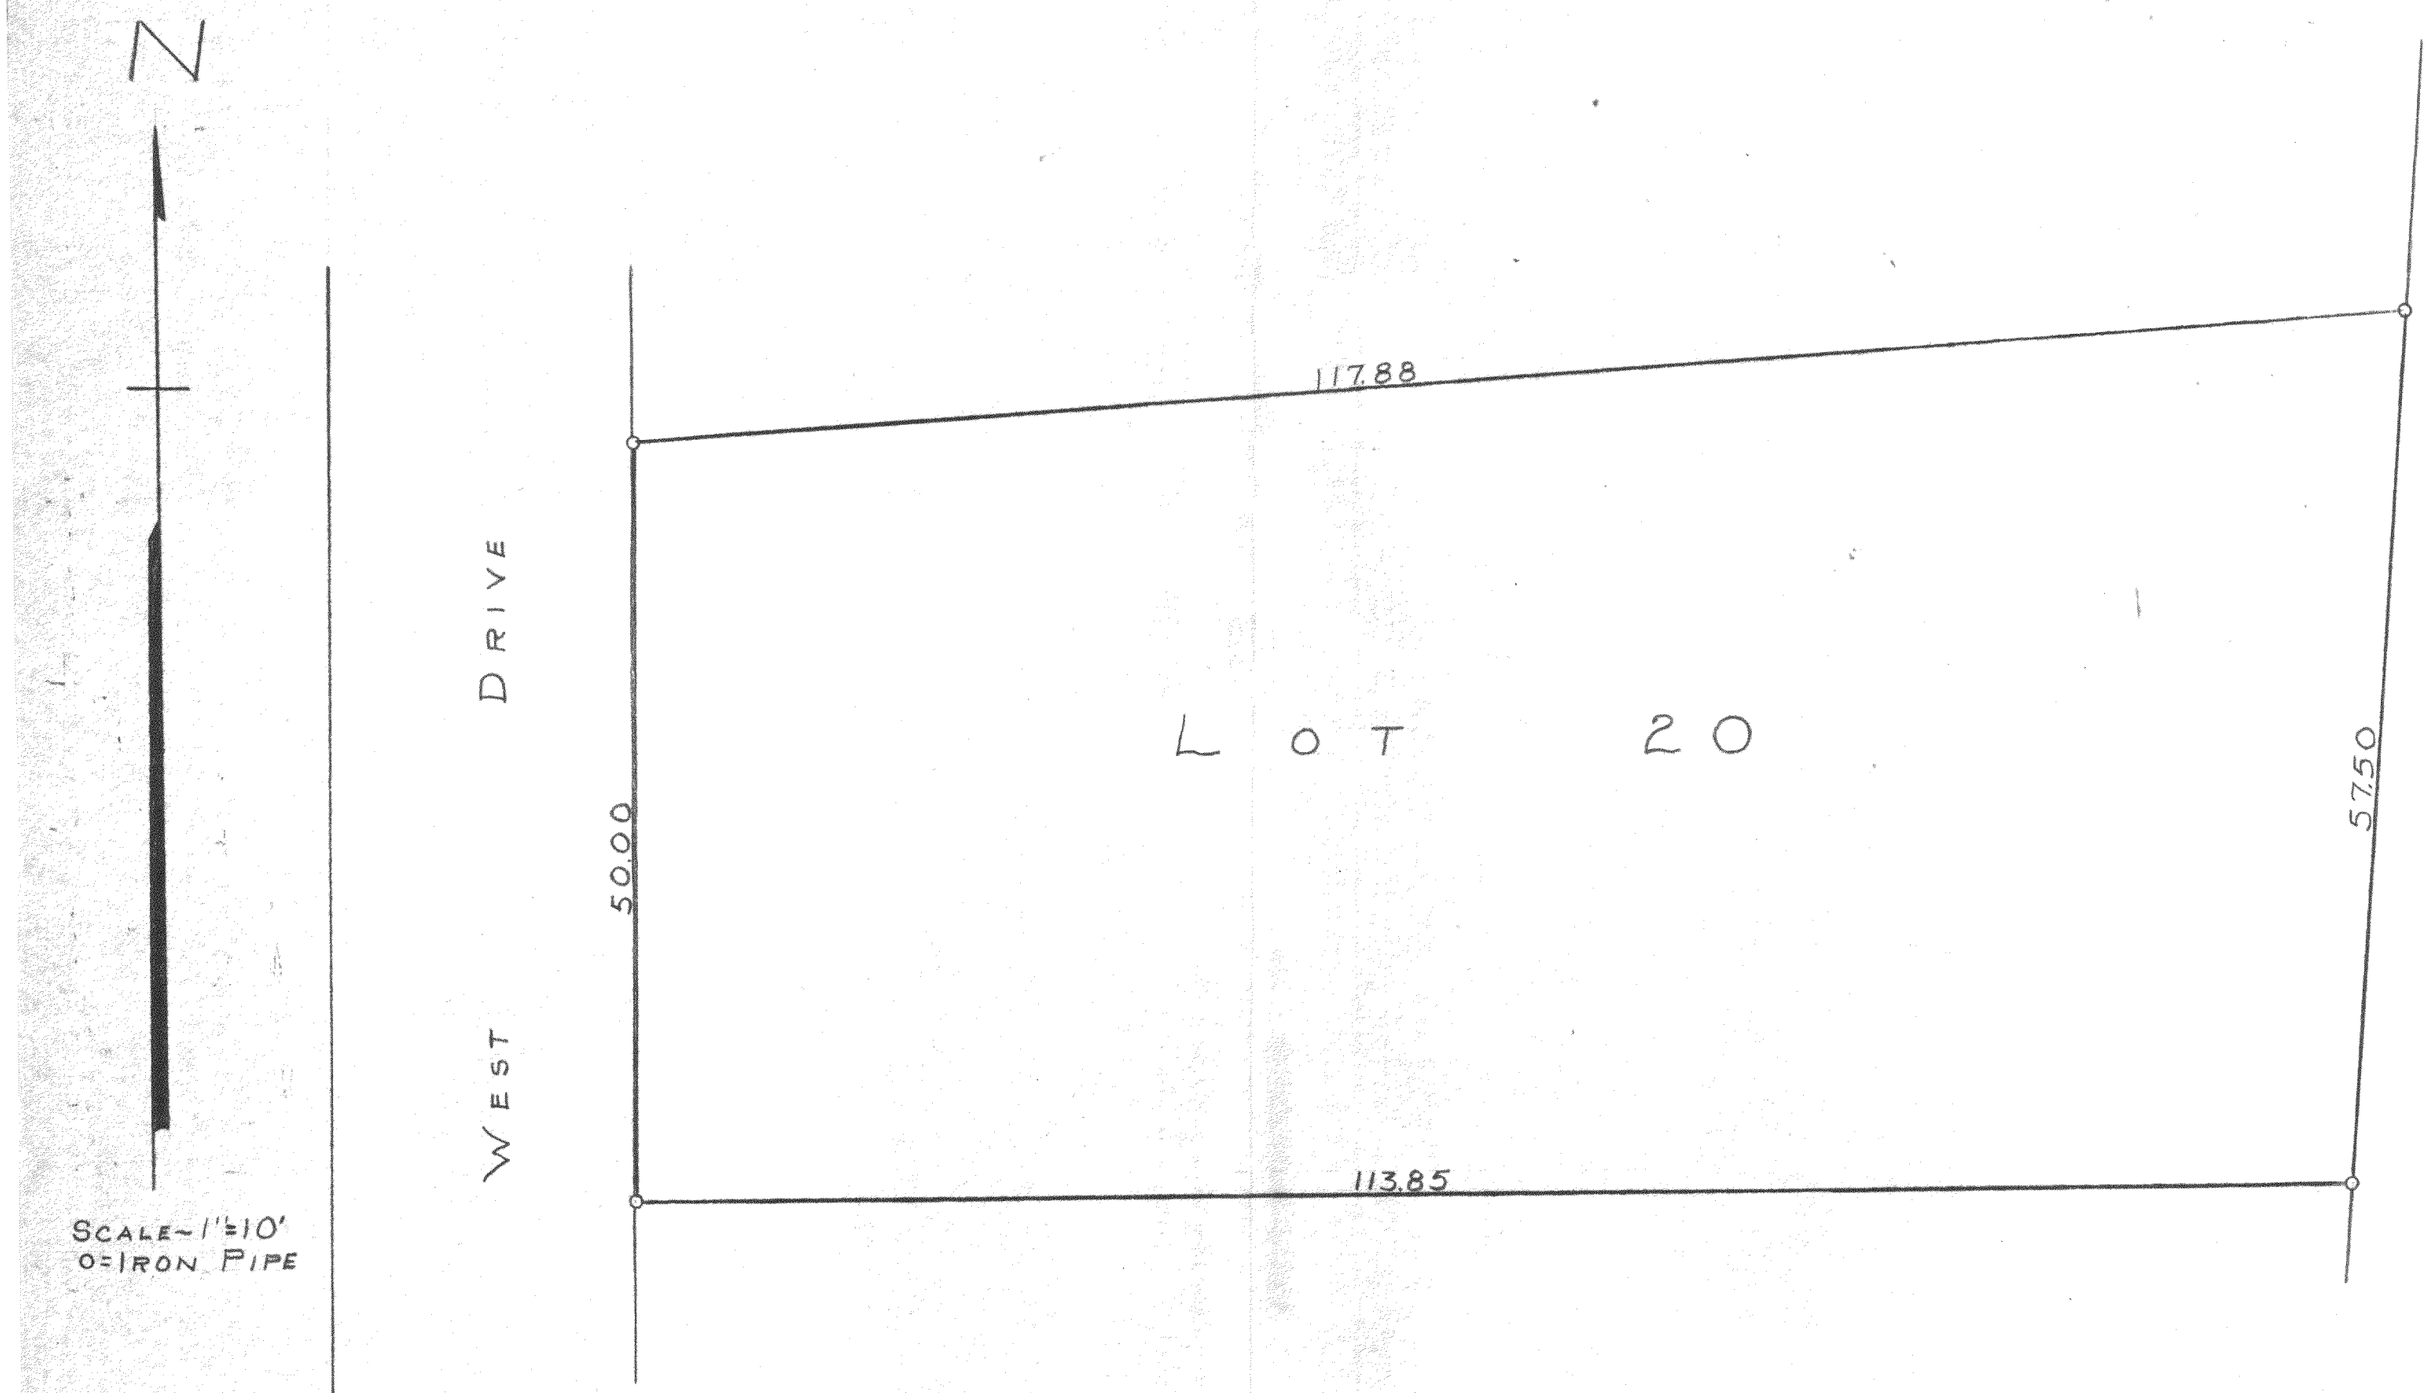


PLAT OF SURVEY OF LOT 20, LAKE GENEVA GOLF HILLS Add,
LOCATED IN SECTION 31, T 2N R 18E OF WALWORTH COUNTY, WIS.
SEPT. 3, 1954

George T. Dunham
GEORGE T. DUNHAM, SURVEYOR
DELAVAN, WISCONSIN

218-2