
PLAT OF SURVEY

LOT 1 OF CERTIFIED SURVEY MAP NO. 917, RECORDED AS DOCUMENT NO. 45266, BEING PART OF THE SW 1/4 OF THE NW 1/4 OF SECTION 31, TOWNSHIP 2 NORTH, RANGE 18 EAST, OF THE 4TH P.M., TOWN OF LYONS, WALWORTH COUNTY, WISCONSIN.

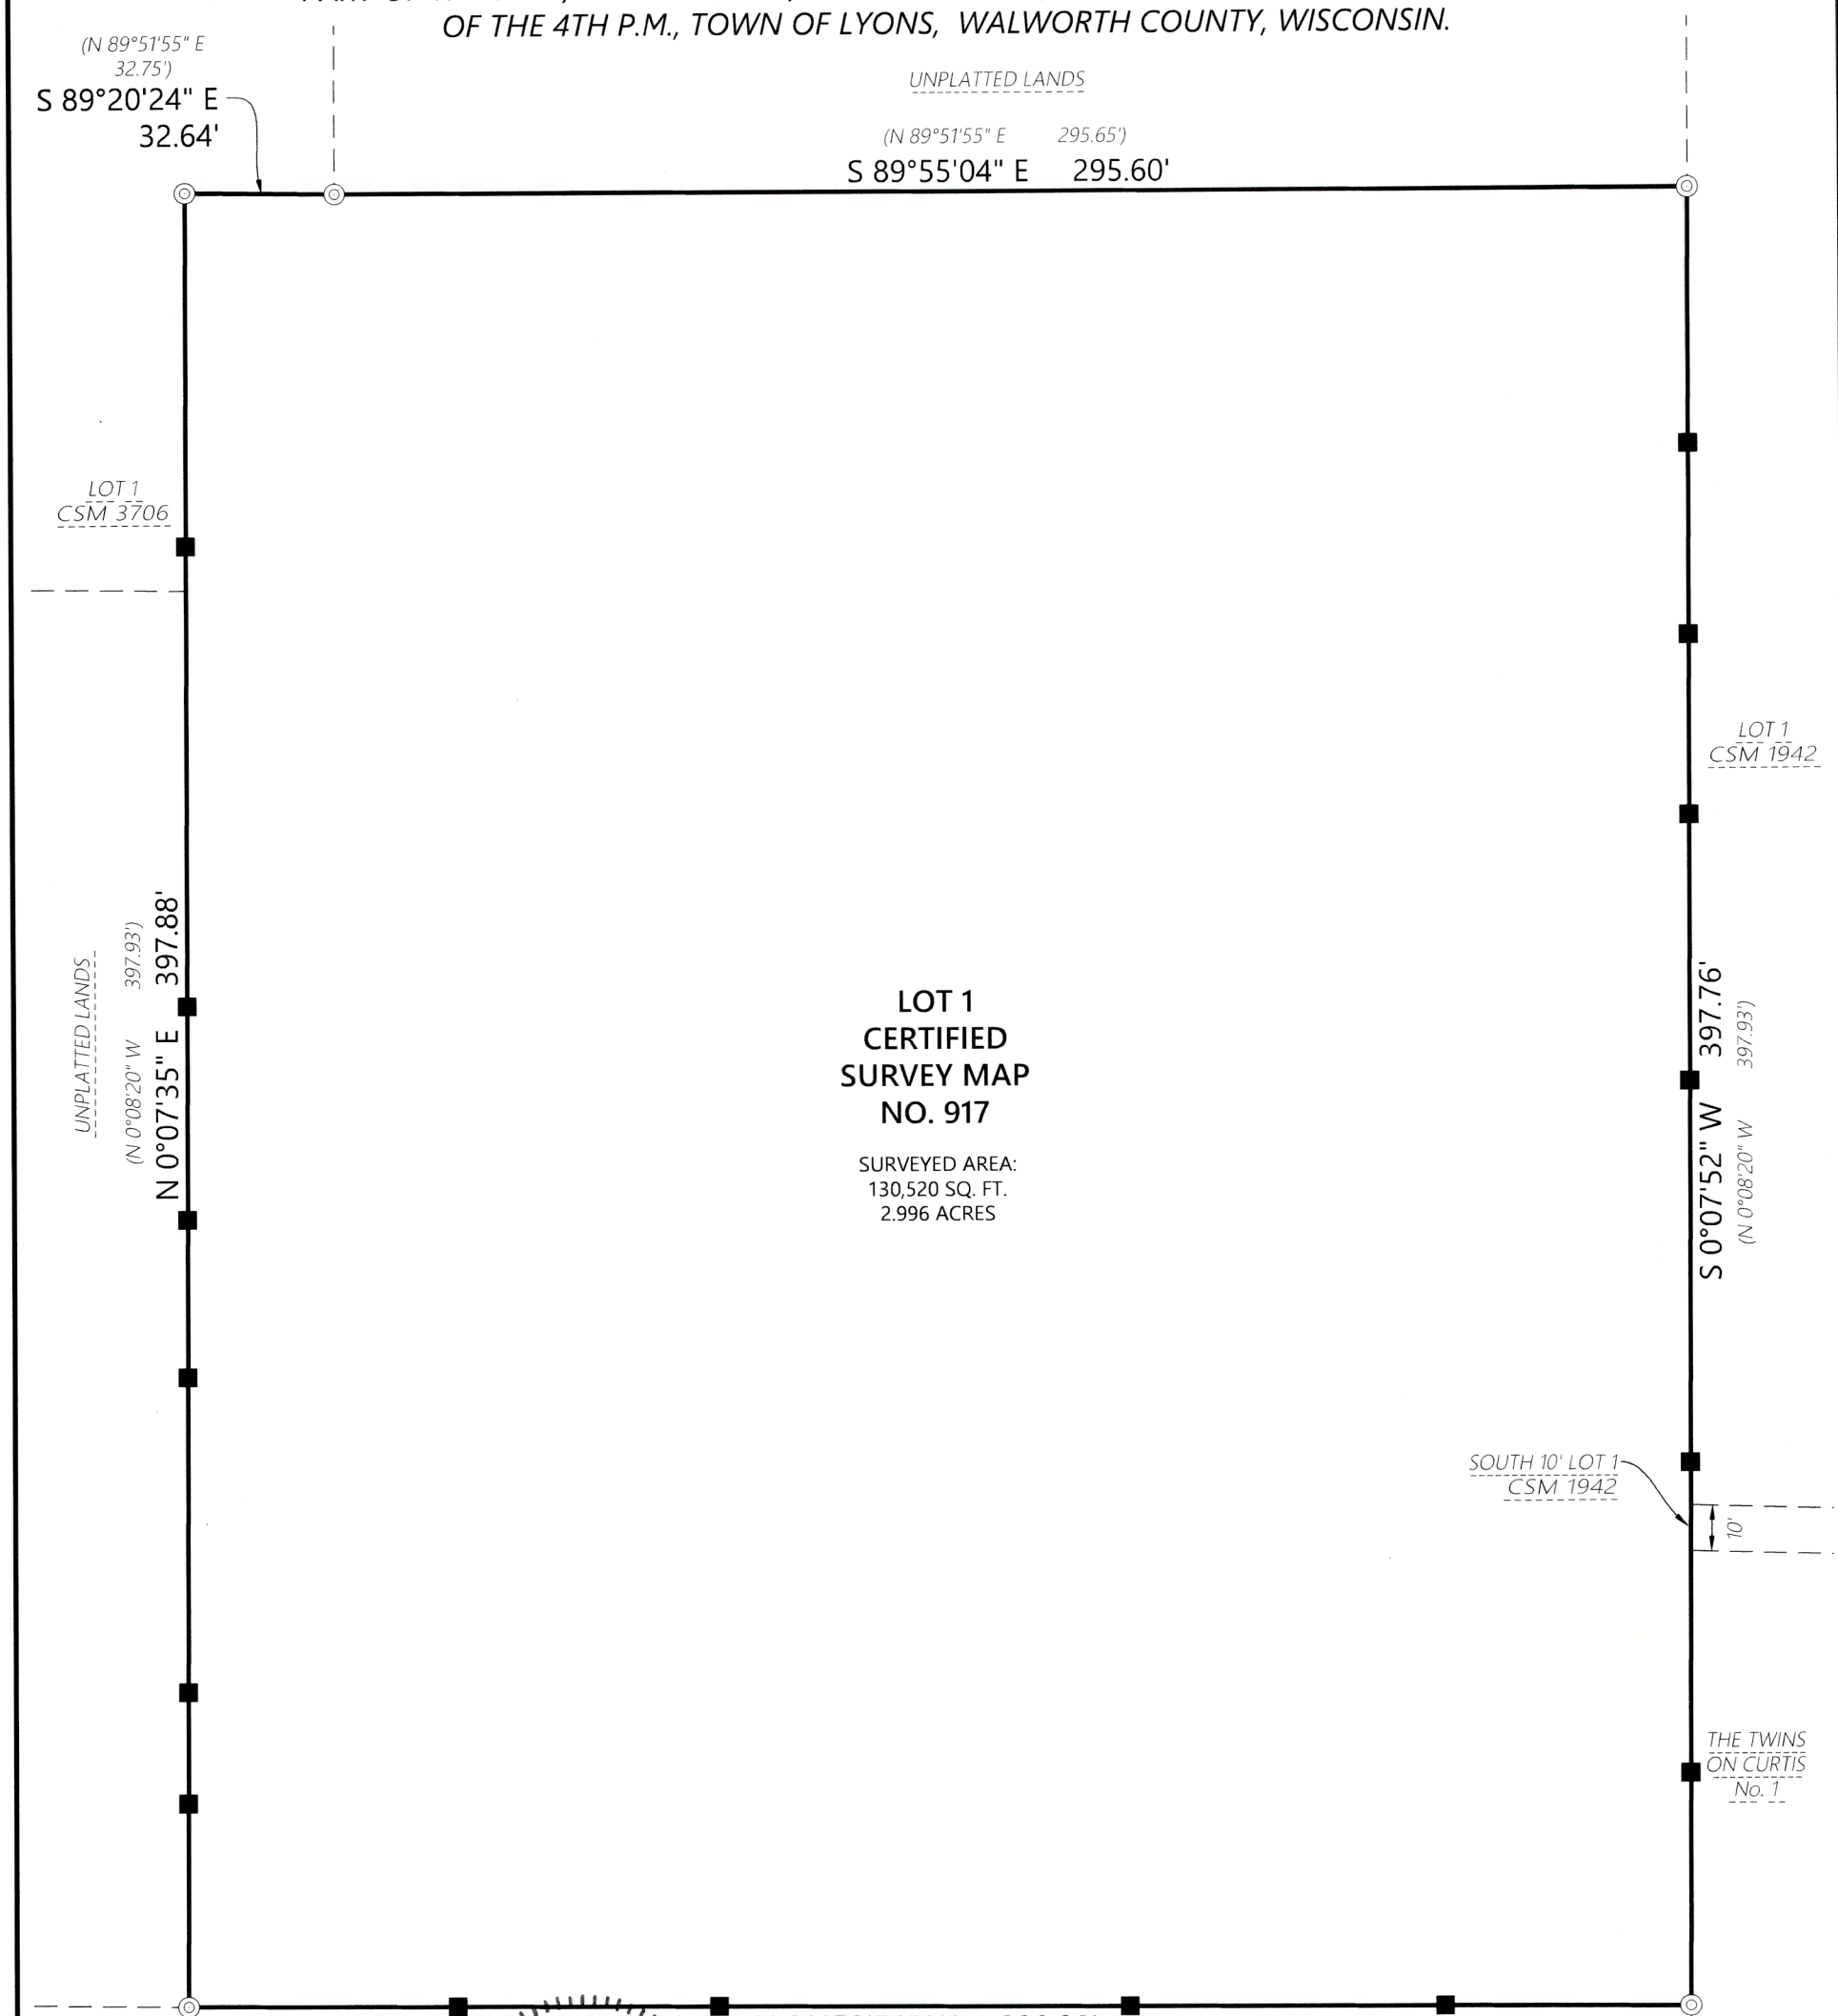

WISCONSIN
KRISTIN J. BELONGIA S-2943 ELKHORN WIS.
LAND SURVEYOR

Kristin J. Belongia

Kristin J. Belongia, P.L.S.
Wisconsin Professional Land Surveyor S-2943

State of Wisconsin } ss
County of Walworth }

If the surveyor's signature is not red in color, the plan is a copy that should be assumed to contain unauthorized alterations.
The certification contained on this document shall not apply to any copies.

I hereby certify that I have supervised the survey of the property described above and to the best my knowledge and belief, the plat drawn hereon complies with Chapter A-E 7 of the State of Wisconsin Administrative Code, Minimum Standards for Property Surveys and correctly represents said survey and its location.
Given under my hand and seal this 12th day of June, 2023 at Beloit, Wisconsin.
Last day of field work June 6th, 2023

LEGEND

◎	1" Iron Pipe Found
■	Wooden Lath Set on Line
(XXX.XX)	Record Information
———	Existing Boundary Line
— — — —	Existing Adjacent Property

DISTANCE UNITS BASED ON THE UNITED STATES SURVEY FOOT

BEARINGS BASED ON THE WISCONSIN COORDINATE REFERENCE SYSTEM, WALWORTH ZONE.
THE SOUTH LINE OF LOT 1 OF CSM 917 BEARING N 89°52'51" W

RECEIVED FEB 13 2024 RWS

Scale: 1" = 40'
0 20 40 80

ORDER NO: 34673 FIELD CREW: BMR / JJO DRAWN BY: BMR SHEET 1 OF 1	*FOR THE EXCLUSIVE USE OF:* Frank Guske P.O. Box 46 Pell Lake, Wi 53157	***PLAT OF SURVEY***	**Batterman** engineers surveyors planners 2857 Bartells Drive Beloit, Wisconsin 53511 608.365.4464 1040 N Wisconsin Street Elkhorn, Wisconsin 53121 262.379.2250

File Name: J:\34600-34699\34673 - Frank Guske\SURVEY\RHB DRAWING FILES

NA 917-1

218-2222