
PERMIT PLAT OF BRIDLEWOOD ESTATES - AS-BUILT
LOT 17 OF NBRE 00017

A CONDOMINIUM LOCATED IN THE NW 1/4 IN THE SW 1/4 OF SECTION 28,
AND THE NE 1/4 OF THE SE 1/4 OF SECTION 29, TOWN 2 NORTH,
RANGE 18 EAST OF THE FOURTH PRINCIPAL MERIDIAN
TOWN OF LYONS, WALWORTH COUNTY, WISCONSIN

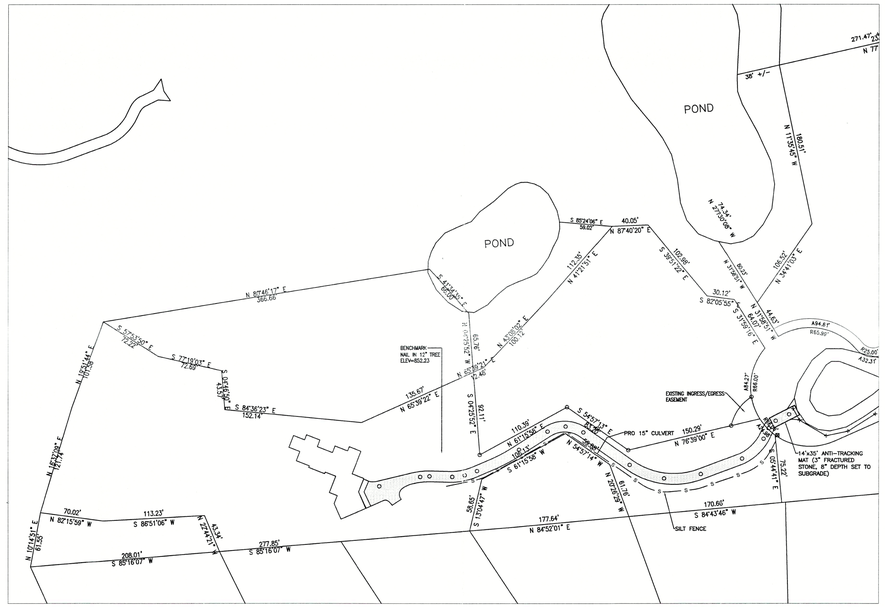


POND
POND
N. 87°46'17" E
366.00'
N. 87°40'20" E
40.05'
N. 87°40'20" E
271.47'
N. 77°
36' +/-
R=64.00'
R=65.00'
494.8'
420.00'
432.31'
BENCHMARK
NAIL IN 12" TREE
ELEV=852.33
N. 25°42'49" W
S. 72°16'03" E
72.82'
S. 84°36'23" E
102.14'
N. 60°39'22" E
136.65'
