
KOLB LAND CONSULTING, INC.

LAND SURVEYING · SUBDIVIDING · LAND PLANNING

LAKE GENEVA, WISCONSIN 53147 WHITEWATER, WISCONSIN 53190

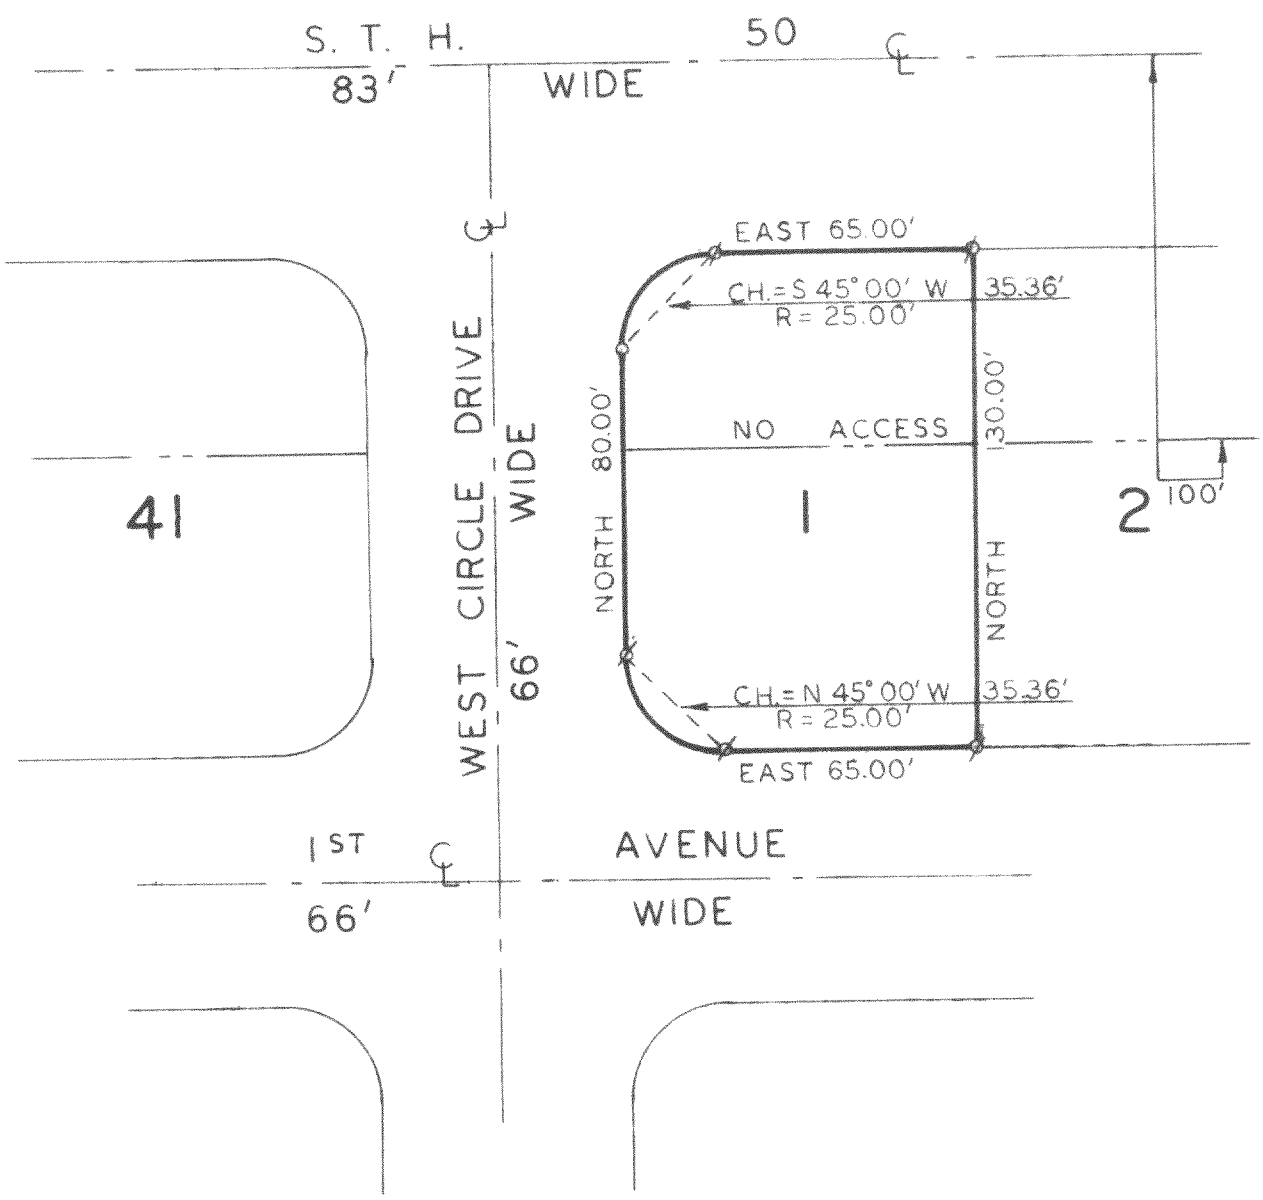

PLAT OF SURVEY OF

LOT 1, CLEAR VIEW ESTATES,
LOCATED IN THE NORTHEAST 1/4
OF SECTION 33, TOWN 2 NORTH,
RANGE 18 EAST, WALWORTH COUNTY,
WISCONSIN.

OWNER: ART WERNER
1804 PRAIRIE
NORTHBROOK, IL 60062

N

SCALE: 1"= 50'

Ø - IRON PIPE FOUND
o - IRON PIPE PLACED

I, HAROLD H. KOLB, DO HEREBY CERTIFY THAT I HAVE SURVEYED THE PROPERTY HEREON DESCRIBED ACCORDING TO THE OFFICIAL RECORDS, AND THAT THE PLAT HEREON IS A CORRECT REPRESENTATION OF THE PROPERTY LINES TO THE BEST OF MY KNOWLEDGE AND BELIEF.

Harold H. Kolb

HAROLD H. KOLB
WISCONSIN REGISTERED LAND SURVEYOR, S- 187

DATE Mar. 17, 1980

218-288V