SURVEYING ASSOCIATES

MEMBER ACSM WSLS


2819 SOUTH 43rd STREET
MILWAUKEE, WISCONSIN 53219


FREDERICK W. SHIBILSKI RLS
(414) 321-5851

MORTGAGE INSPECTION
-of-

LOTS 12 & 13, BLOCK 4 of the Original Plat of Springfield, Lyons Township, Walworth County, Wiscosin.

Survey For: Banco Mortgage Co.
Owner: Roger Wolff
Survey Location: 7182 Hwy 36

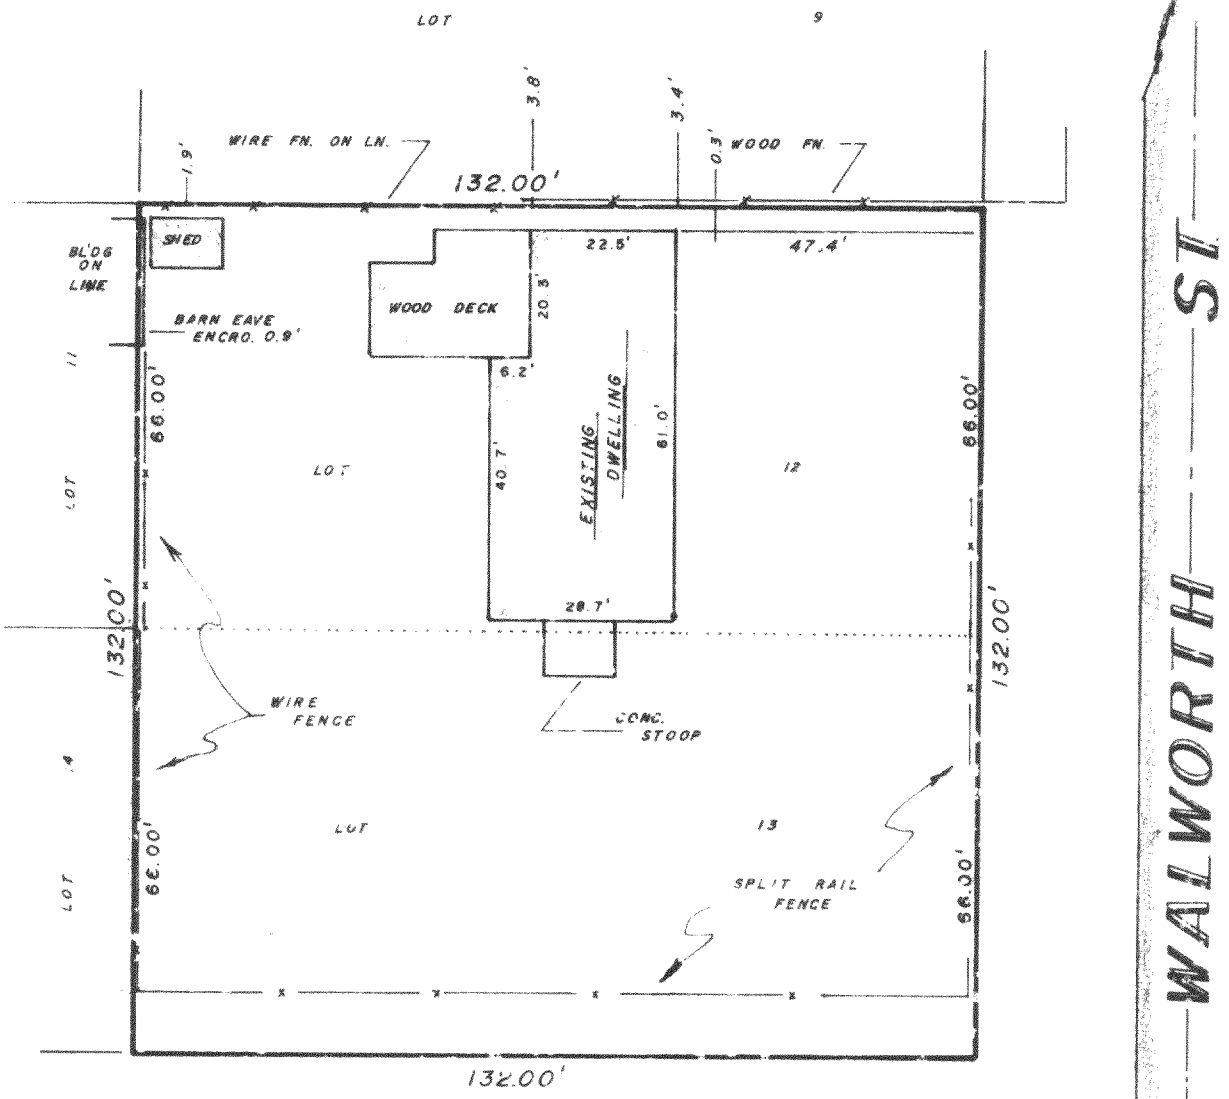

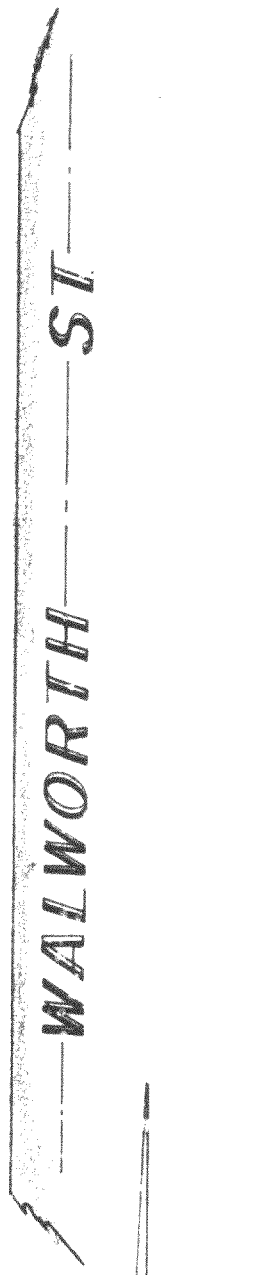

S. T. H. "36"

"I hereby certify that I have surveyed the above described property and that the above map is a true representation thereof and shows the size and location of the property, its exterior boundaries, the location of all visible structures and dimensions of all principal buildings thereon, boundary fences, apparent easements, roadways and visible encroachments, if any.

"This survey is made for the use of the present owners of the property, and also those who purchase, mortgage, or guarantee the title thereto within one year from date hereof."

WISCONSIN FREDERICK W. SHIBILSKI S-1154 MILWAUKEE, WIS. LAND SURVEYOR

YES ■ : MONUMENTATION HAS BEEN WAIVED IN ACCORDANCE WITH A-E 5.01(b) OF THE WISCONSIN ADMINISTRATIVE CODE.

SCALE : 1 " = 30 '

WISCONSIN REGISTERED LAND SURVEYOR

REV 4/12/82
APRIL 7, 1982
DATE

FIELD WORK BY BW DJK DRAWN BY DJK

8203124
JOB NUMBER

218-294-2