
KOLB LAND CONSULTING, INC.

LAND SURVEYING · SUBDIVIDING · LAND PLANNING

LAKE GENEVA, WISCONSIN 53147

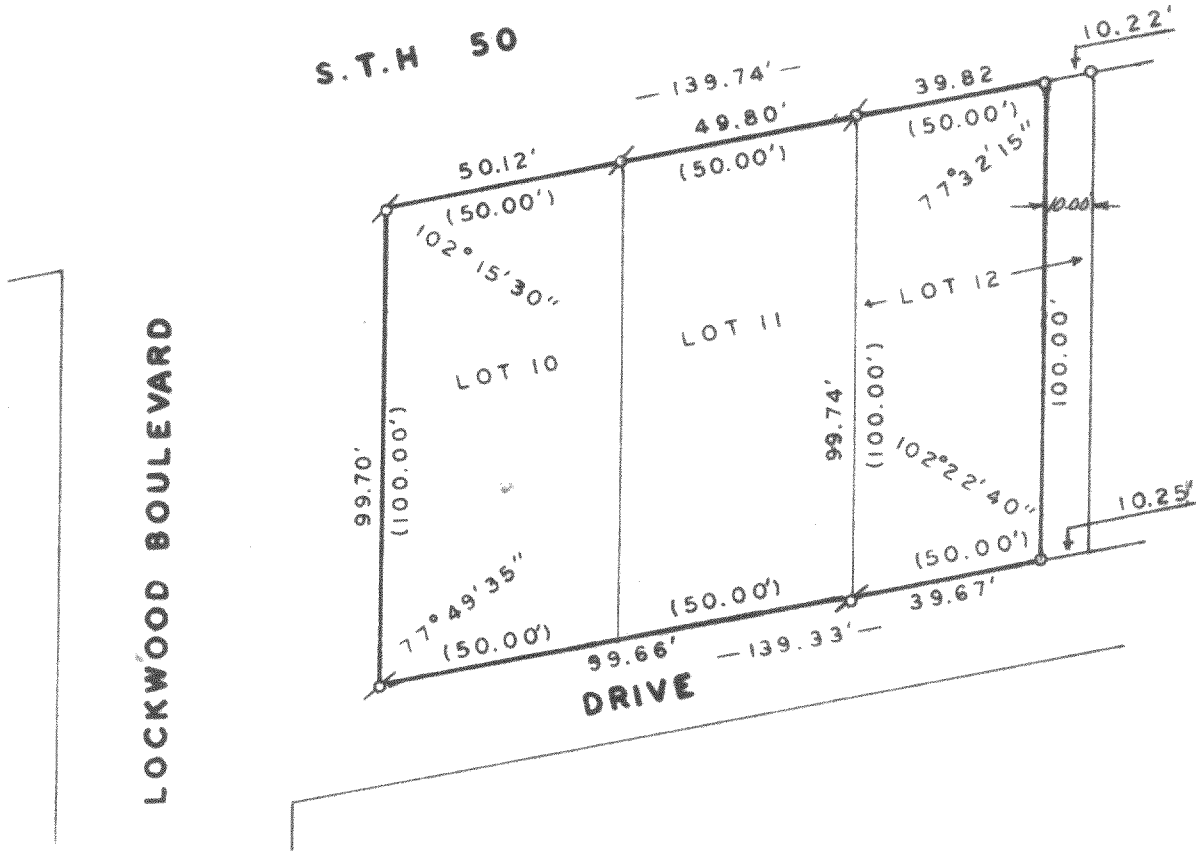

PLAT OF SURVEY OF

LOTS 10, 11 AND 12, EXCEPT THE EAST 10 FEET OF LOT 12, GOLF HILLS SUBDIVISION, TOWN 2 NORTH, RANGE 18 EAST, WALWORTH COUNTY, WISCONSIN.

ORDERED BY: CATHERINE SHEPPARD
3125 LOCKWOOD BLVD.
LAKE GENEVA, WI

SCALE: 1"=40'

LEGEND

- ⌀ IRON PIPE FOUND
- o IRON PIPE SET
- (T) AS RECORDED

I, HAROLD H. KOLB, DO CERTIFY THAT I HAVE SURVEYED THE PROPERTY HEREON DESCRIBED ACCORDING TO THE OFFICIAL RECORDS, AND THAT THE PLAT HEREON IS A CORRECT REPRESENTATION OF THE LOT LINES TO THE BEST OF MY KNOWLEDGE AND BELIEF.

Harold H. Kolb

HAROLD H. KOLB
WISCONSIN REGISTERED LAND SURVEYOR, S-187
DATE JUNE 22, 1984

NGH-8

218-327