
RECEIVED
JUL 30 1985
W. L.

WALWORTH COUNTY
SURVEYING & MAPPING
LAKE GENEVA, WISCONSIN

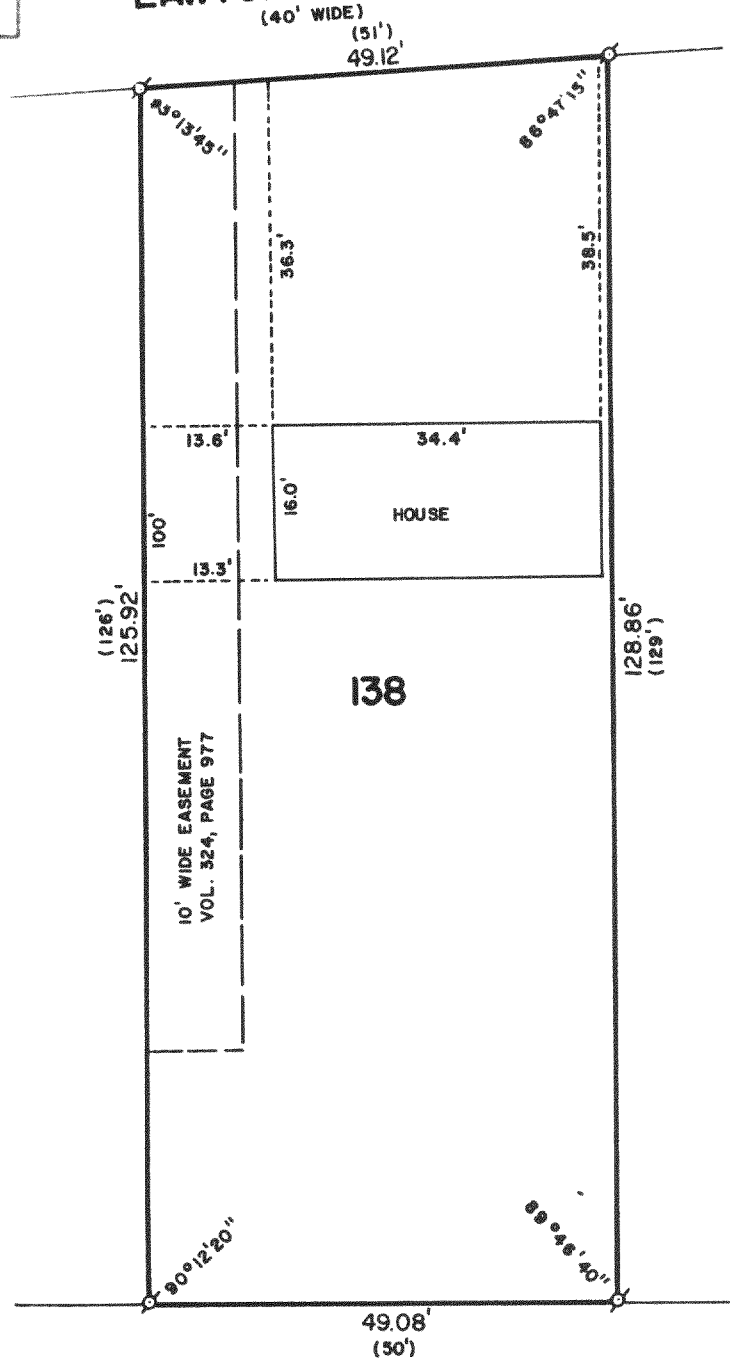

PLAT OF SURVEY OF

LOT 138 OF LAKE GENEVA GOLF HILLS SUBDIVISION, T 2 N, R 18 E, WALWORTH COUNTY, WISCONSIN.

ORDERED BY: STOTLER REALTY
3131 LOCKWOOD BOULEVARD
LAKE GENEVA, WISCONSIN 53147

ROBERT M. BAERENWALD
Lake Geneva, WI.
S-1508

SCALE: 1"=20'

ø-IRON PIPE FOUND
()-RECORDED AS

I, ROBERT M. BAERENWALD, DO HEREBY CERTIFY THAT I HAVE SURVEYED THE PROPERTY HEREON DESCRIBED ACCORDING TO THE OFFICIAL RECORDS AND THAT THE PLAT HEREON IS A CORRECT REPRESENTATION OF THE PROPERTY LINES TO THE BEST OF MY KNOWLEDGE AND BELIEF.

Robert M. Baerenwald
ROBERT M. BAERENWALD
WISCONSIN REGISTERED LAND SURVEYOR, S-1508

January 19, 1985
DATE JOB NO. 0194

218-343-B