PLAT OF SURVEY
OF

LOT 2 OF WALWORTH COUNTY CERTIFIED SURVEY MAP NO. 1195, LANDS LOCATED IN THE SOUTHWEST 1/4 OF SECTION 10, T. 2 N., R. 18 E. OF THE 4TH P.M., TOWNSHIP OF LYONS, COUNTY OF WALWORTH , STATE OF WISCONSIN.

FOR: TOM REGNER

SCALE 1" = 40'

ϕ = IRON PIPE STAKE FOUND.

PROPOSED DWELLING STAKED ON SITE

E = ELEVATION ON SEA LEVEL DATUM

BEARING DATUM IS THAT OF
CSM NO. 1195

I have surveyed the above-described property, and the map hereon is a true representation thereof and shows the size and location of the property, its exterior boundaries, the location and dimensions of all visible structures thereon, fences, apparent easements and roadways and visible encroachments if any.

This survey is made for the exclusive use of the present owners of the property, and also those who purchase, mortgage or guarantee the title thereto, within one year from date hereof.

Dated at Burlington, this 14th. day of May, 1985

John F. Degen

John F. Degen, Land Surveyor S 242

WISCONSIN
JOHN F. DEGEN
BURLINGTON, WIS.
LAND SURVEYOR

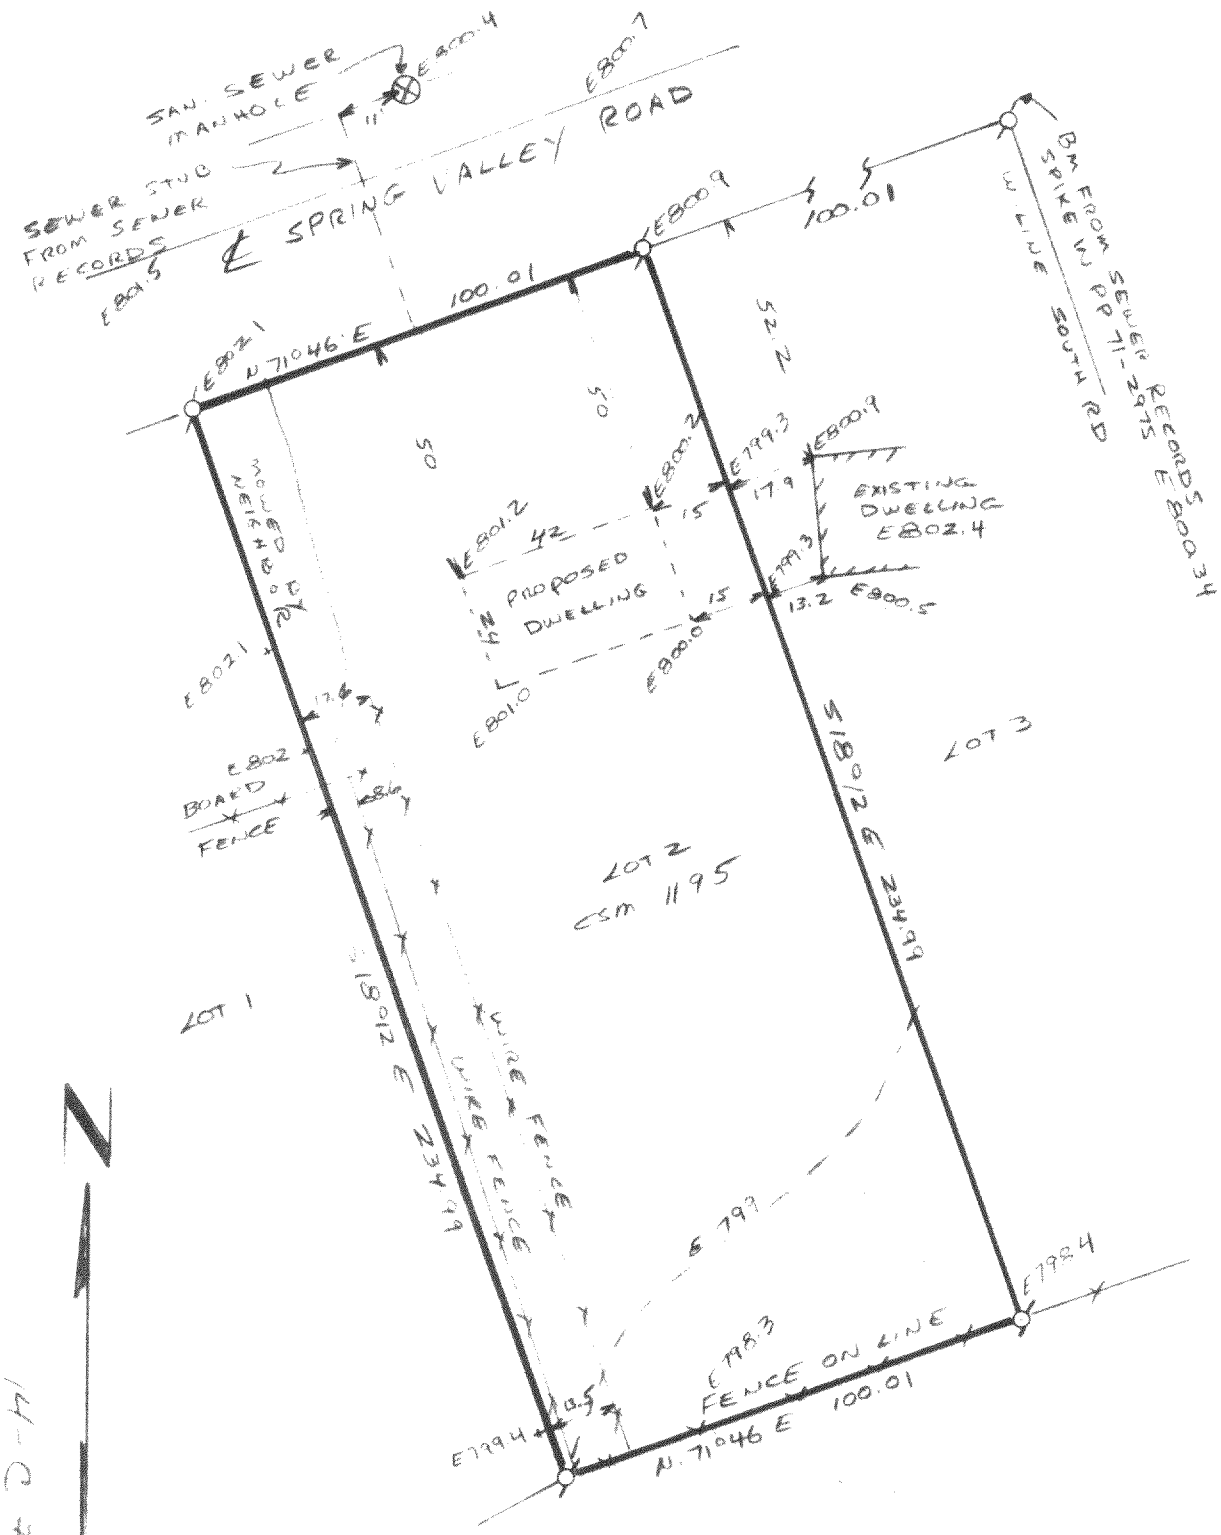

218-349