KOLB LAND CONSULTING, INC.

LAND SURVEYING · SUBDIVIDING · LAND PLANNING


929 WILLIAMS STREET LAKE GENEVA, WISCONSIN 53147 414-248-3697

ORDERED BY: KEEFE REAL ESTATE
704 MAIN
LAKE GENEVA, WI. 53147

SCALE: 1" = 40'

LEGEND

- ⌀ - IRON PIPE FOUND
- o - 1" X 24" IRON PIPE SET
- △ - UTILITY POLE
- ——— - OVERHEAD UTILITY LINE
- S - SHED
- SW- SIDE WALK
- G - GARAGE

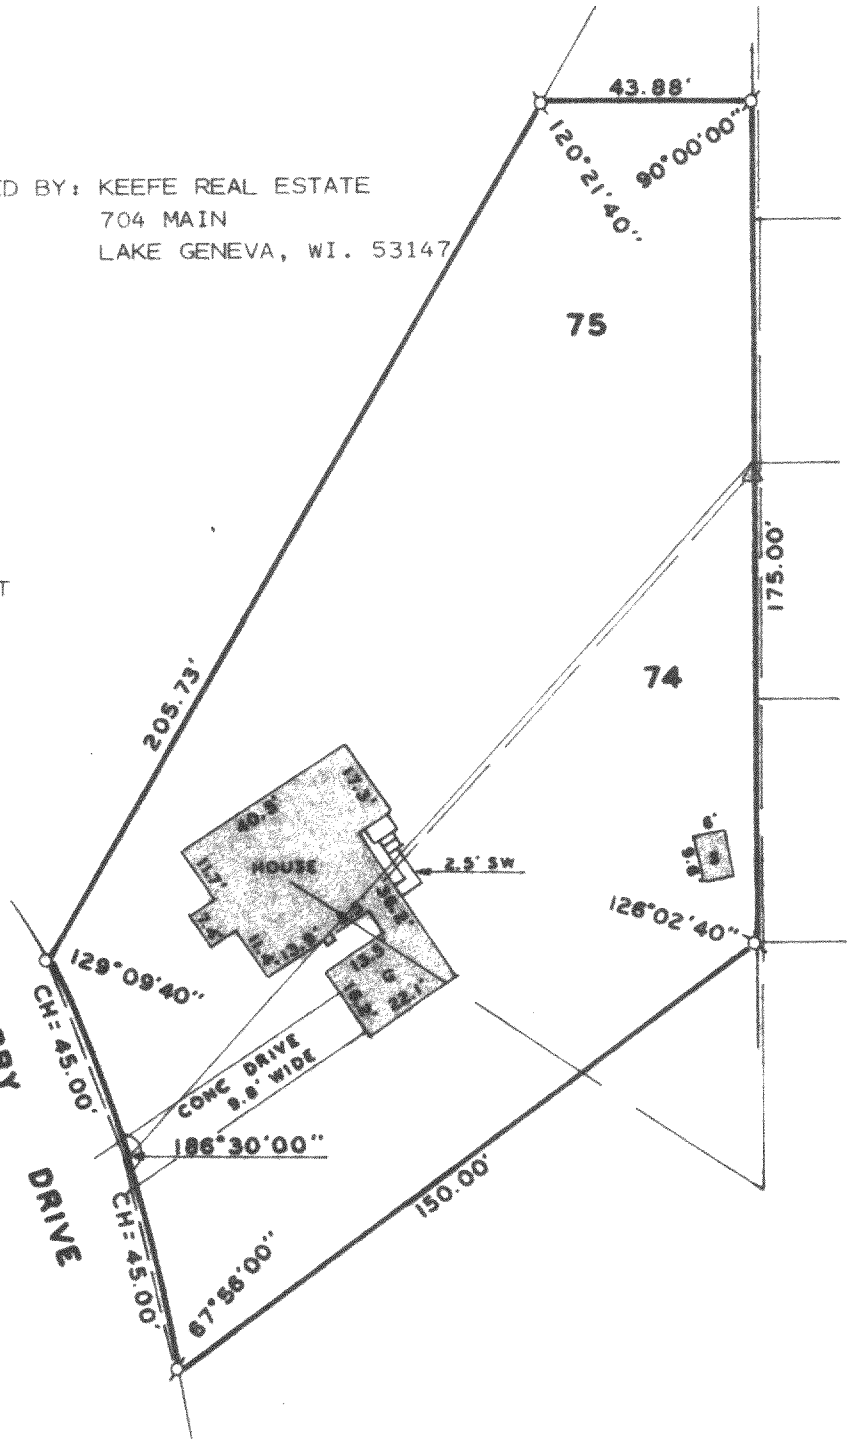

PLAT OF SURVEY OF

LOT 74 AND 75 OF LAKE GENEVA GOLF HILLS ADDITION, T2N, R18E, WALWORTH COUNTY, WISCONSIN.

RECEIVED
NOV 13 1986

WISCONSIN
HAROLD H KOLB
S187
LAKE GENEVA
WIS
LAND SURVEYOR

I HEREBY CERTIFY THAT I HAVE SURVEYED THE ABOVE DESCRIBED PROPERTY AND THAT THE ABOVE MAP IS A TRUE REPRESENTATION THEREOF AND SHOWS THE SIZE AND LOCATION OF THE PROPERTY, ITS EXTERIOR BOUNDARIES, THE LOCATION OF ALL VISIBLE STRUCTURES AND DIMENSIONS OF ALL PRINCIPAL BUILDINGS THEREON, BOUNDARY FENCES, APPARENT EASEMENTS, ROADWAYS AND VISIBLE ENCROACHMENTS, IF ANY, TO THE BEST OF MY KNOWLEDGE AND BELIEF.
THIS SURVEY IS MADE FOR THE USE OF THE PRESENT OWNERS OF THE PROPERTY AND ALSO THOSE WHO PURCHASE, MORTGAGE, OR GUARANTEE THE TITLE THERETO WITHIN ONE (1) YEAR FROM DATE HEREOF.

Harold H. Kolb

HAROLD H. KOLB

WISCONSIN REGISTERED LAND SURVEYOR, S- 187

DATE SEPTEMBER 30, 1986

REVISED _____

REVISED _____

2-18-102

NGN-37

218-380K