PLAT OF SURVEY OF

LOT 4, RUEDEBUSCH PINES SUBDIVISION, LOCATED IN THE SE 1/4 OF NE 1/4 AND IN THE SW 1/4 OF THE NE 1/4 OF SECTION 12, T. 2 N., R. 18 E. OF THE 4TH P.M., TOWNSHIP OF LYONS, COUNTY OF WALWORTH, STATE OF WISCONSIN.

FOR: JEFF AND MARY PETERSON

o = IRON STAKE


SCALE 1" = 100'

BEARING DATUM IS THAT OF RECORDED PLAT.

X = SOIL BORING

□ = UTILITY JUNCTION BOX

RECEIVED
JUN 11 1987

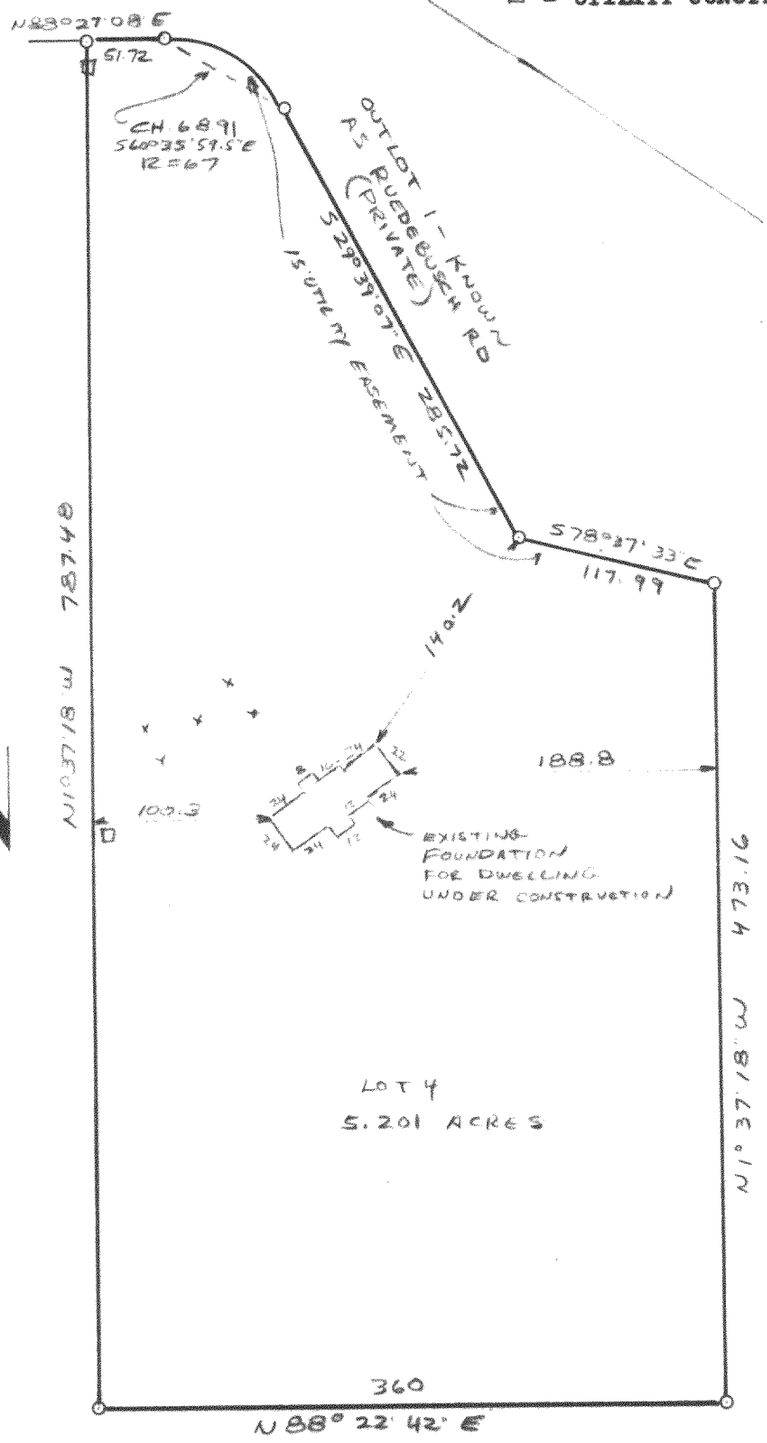

I have surveyed the above-described property, and the map hereon is a true representation thereof and shows the size and location of the property, its exterior boundaries, the location and dimensions of all visible structures thereon, fences, apparent easements and roadways and visible encroachments, if any.

This survey is made for the exclusive use of the present owners of the property, and also those who purchase, mortgage, or guarantee the title thereto, within one year from date hereof.

Dated at Burlington, this 17th day of March 1987

John F. Degen

John F. Degen, Land Surveyor S 242

5-7-87 FOUNDATION LOCATION.

NRP-4

PLAT OF SURVEY OF

LOT 4, RUEDEBUSCH PINES SUBDIVISION, LOCATED IN THE SE 1/4 OF NE 1/4 AND IN THE SW 1/4 OF THE NE 1/4 OF SECTION 12, T. 2 N., R. 18 E. OF THE 4TH P.M., TOWNSHIP OF LYONS, COUNTY OF WALWORTH, STATE OF WISCONSIN.

FOR: JEFF AND MARY PETERSON

o = INCH STAKE


SCALE 1" = 100'

BEARING DATUM IS THAT OF RECORDED PLAT.

X = SOIL BORING

□ = UTILITY JUNCTION BOX

RECEIVED
MAY 4 1987

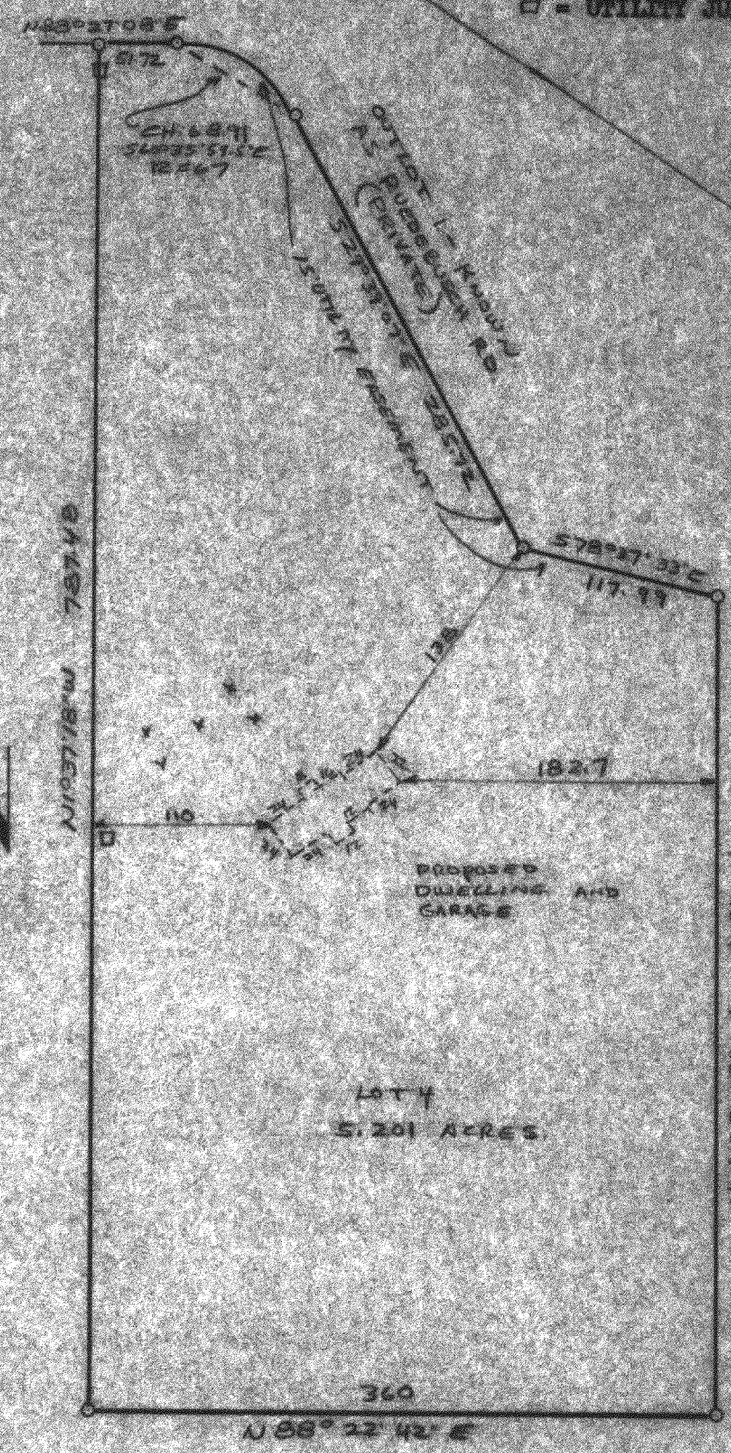

I have surveyed the above-described property, and the map hereon is a true representation thereof and shows the size and location of the property, its exterior boundaries, the location and dimensions of all visible structures thereon, fences, apparent easements and roadways and visible encroachments, if any.

This survey is made for the exclusive use of the present owners of the property, and also those who purchase, mortgage, or guarantee the title thereto, within one year from date hereof.

Dated at Burlington, this 17th day of MARCH, 1987

John F. Degen

John F. Degen, Land Surveyor S 242

NRP-4

218-394