
WALWORTH COUNTY
SURVEYING & MAPPING
LAKE GENEVA, WISCONSIN

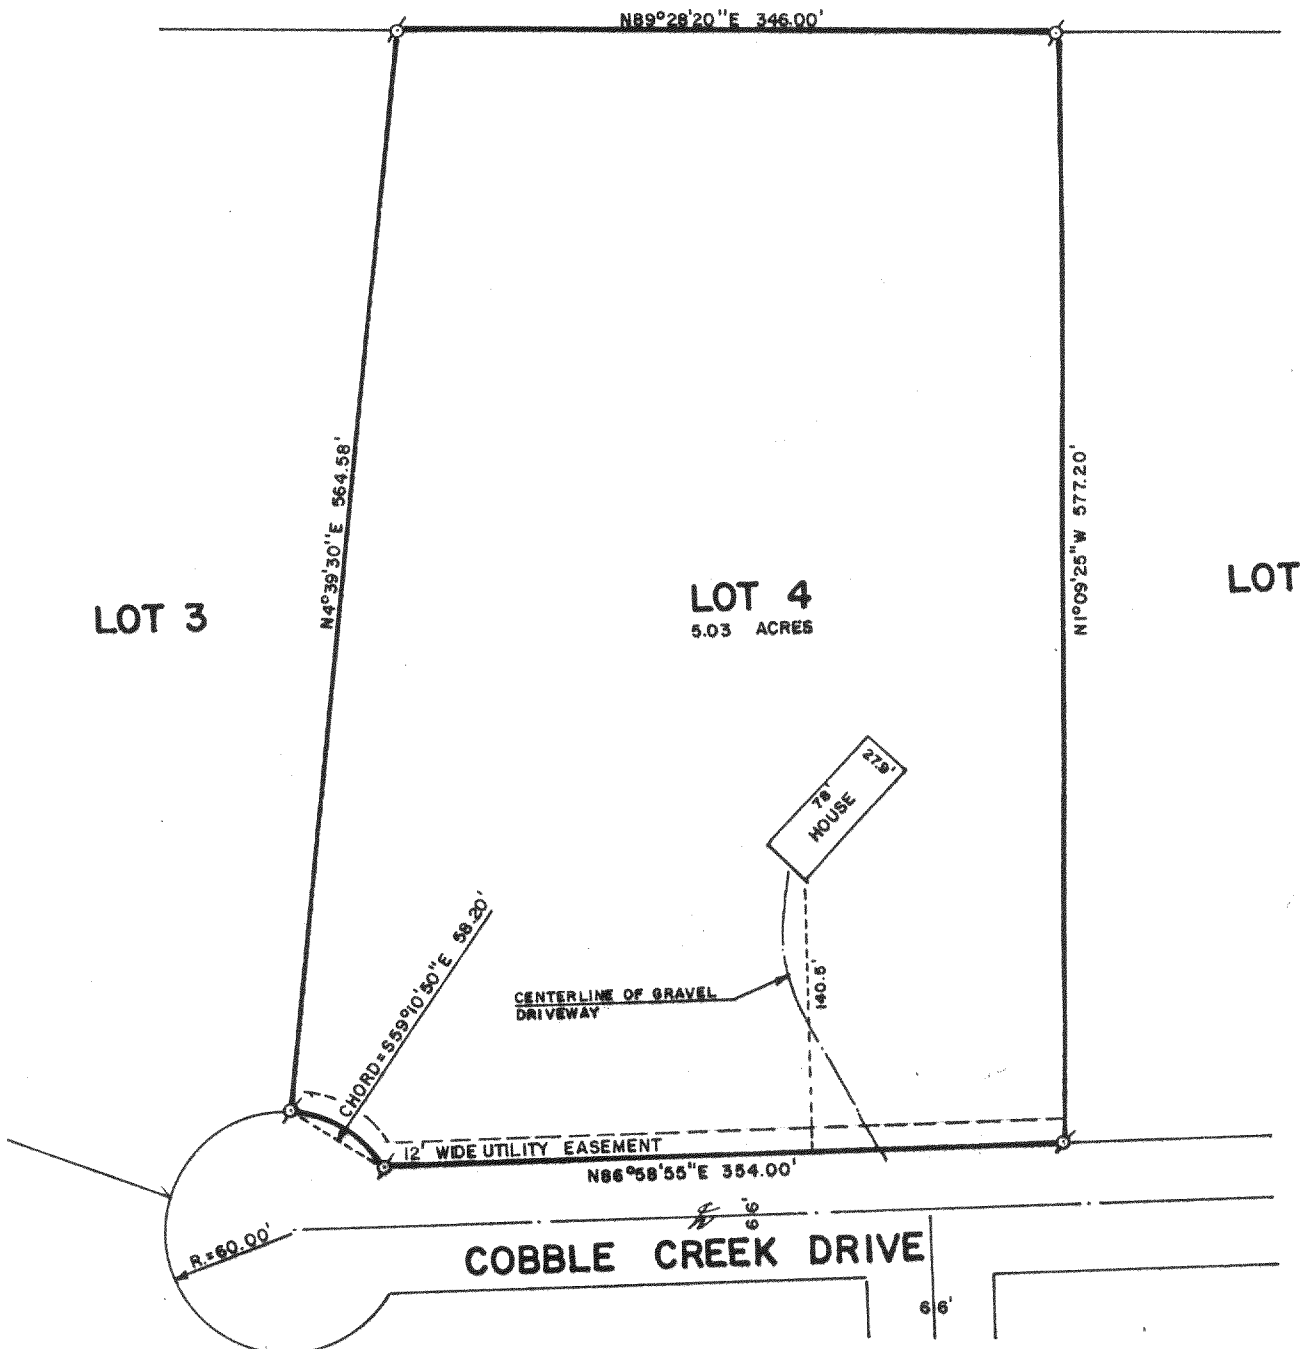

RECEIVED
JUN 19 1987

PLAT OF SURVEY OF

LOT 4 OF MEADOW HILL FARMS, LOCATED IN SECTION 32, T 2 N, R 18 E, WALWORTH COUNTY, WISCONSIN.

ORDERED BY: JOHN SARNOWSKI
RT. 3, P. O. BOX 1060
LAKE GENEVA, WISCONSIN 53147

SCALE: 1"=100'

ø -IRON PIPE FOUND

I, ROBERT M. BAERENWALD, DO HEREBY CERTIFY THAT I HAVE SURVEYED THE PROPERTY HEREON DESCRIBED ACCORDING TO THE OFFICIAL RECORDS AND THAT THE PLAT HEREON IS A CORRECT REPRESENTATION OF THE PROPERTY LINES TO THE BEST OF MY KNOWLEDGE AND BELIEF.

Robert M. Baerenwald
ROBERT M. BAERENWALD
WISCONSIN REGISTERED LAND SURVEYOR, S-1508

May 2, 1987
DATE JOB NO. 0994

NOTE: THIS IS NOT A CERTIFIED COPY UNLESS SEALED.

nmH-4

218-399