

PROJECT 3545 DATED SEPT 25TH 1991
FILE NAME: C44/PL03545 SCALE 1 INCH = 20 FEET
PLOT COORDINATE WINDOW 500 - 900 N & 180 - 440 E

PROJECT NO 3545 DATED SEPT 25TH 1991
BUILDING SHAPE STAKED 09/24/91

PROJECT 3545 DATED SEPT 25TH 1991
FILE NAME: C44/PL03545 SCALE 1 INCH = 10 FEET
PLOT COORDINATE WINDOW 500 - 850 N & 265 - 375 E

61 TO 62 S 79 - 50 - 21 W 20.33 FT
62 TO 63 N 10 - 9 - 55 W 8 FT
63 TO 64 S 79 - 50 - 15 W 37.67 FT
64 TO 65 N 10 - 9 - 39 W 12 FT
65 TO 66 S 79 - 50 - 26 W 8 FT
66 TO 67 N 10 - 9 - 44 W 16 FT
67 TO 68 N 79 - 50 - 20 E 48 FT
68 TO 69 S 10 - 9 - 37 E 10 FT
69 TO 70 N 79 - 50 - 15 E 18 FT
70 TO 61 S 10 - 9 - 40 E 26 FT

AREA 1734.00 SF .0079822155 ACRES

REF STAKES SET 09/24/91

61 TO 55 N 79 - 50 - 3 E 10 FT
62 TO 54 S 79 - 50 - 19 W 55.67 FT
67 TO 57 S 79 - 50 - 3 W 10 FT
68 TO 56 N 79 - 50 - 18 E 28 FT
56 TO 55 S 10 - 9 - 40 E 36 FT
54 TO 57 N 10 - 9 - 40 W 36 FT

PROJECT NO 3545 DATED SEPT 25TH 1991
OFFSETS FROM WEST PROPERTY LINE TO BUILDING STAKED 9/24/91

34 TO 5 346 - 25 - 30 263.65 FT FP 1.75D

54 STA 0 + 48.59 OFF 9.13 RT SW BLDBX

64 STA 0 + 55.5 OFF 27.58 RT BLD COR

56 STA 0 + 67.96 OFF 20.31 RT BLDB COR

67 STA 0 + 83.93 OFF 21.25 RT BLDB COR

57 STA 0 + 84.53 OFF 11.28 RT NW BLDBX

OFFSETS FROM EAST PROPERTY LINE TO BUILDING STAKED 09/24/91

35 TO 12 351 - 16 - 53 280.12 FT FP 1.25D

61 STA 0 + 48.68 OFF 14.99 LT GAR COR

55 STA 0 + 48.74 OFF 5 LT SE BLDBX

70 STA 0 + 74.68 OFF 15.64 LT GAR COR

36 STA 0 + 84.93 OFF 5.9 LT NE BLDBX

DISTANCE FROM CENTER OF STREET CURVE TO BUILDING STAKED 09/24/91


379 TO 61 351 - 42 - 43 1051.366 FT GAR COR 748.47

399 TO 62 350 - 36 - 14 1050.998 FT GAR COR 748.00

399 TO 64 348 - 33 - 37 1059.168 FT BLD COR 756.17


FINAL COORDINATE LIST 3545092591F1N
POINT DESCRIBED NORTH EAST

5 FP 1.75D	797.211	232.743/
7 FP 1.25D	760.921	121.366/
8 SET NAIL	775.701	236.869/
9 FP 1.25D	760.055	118.479/
10 SN	600.123	346.893/
11 FP 1.75D	697.576	367.743/
12 FP 1.25D	834.742	346.659/
13 FP 210 D	515.070	202.309/
14 FP 210 D	540.926	294.626/
15 FP 210 D	557.859	299.100/
50 EP NORTH	520.262	300.305/
51 EP NORTH	528.037	343.905/
52 EP NORTH	535.949	393.441/
53 TO 50X	537.375	382.606/
54 SW BLDBX	590.301	272.325/
55 SE BLDBX	605.874	375.747/
56 NW BLDBX	640.209	370.396/
57 NW BLDBX	625.724	295.745/
61 GAR COR	603.709	366.704/
62 GAR COR	600.122	346.890/
63 BLD COR	607.997	345.478/
64 BLD COR	601.351	306.402/
65 BLD COR	613.163	306.285/
66 BLDB COR	611.732	298.411/
67 BLDB COR	627.501	295.588/
68 BLDB COR	635.969	272.835/
69 BLDB COR	626.126	344.599/
70 GAR COR	629.302	362.317/
71 GAR COR	625.714	342.303/

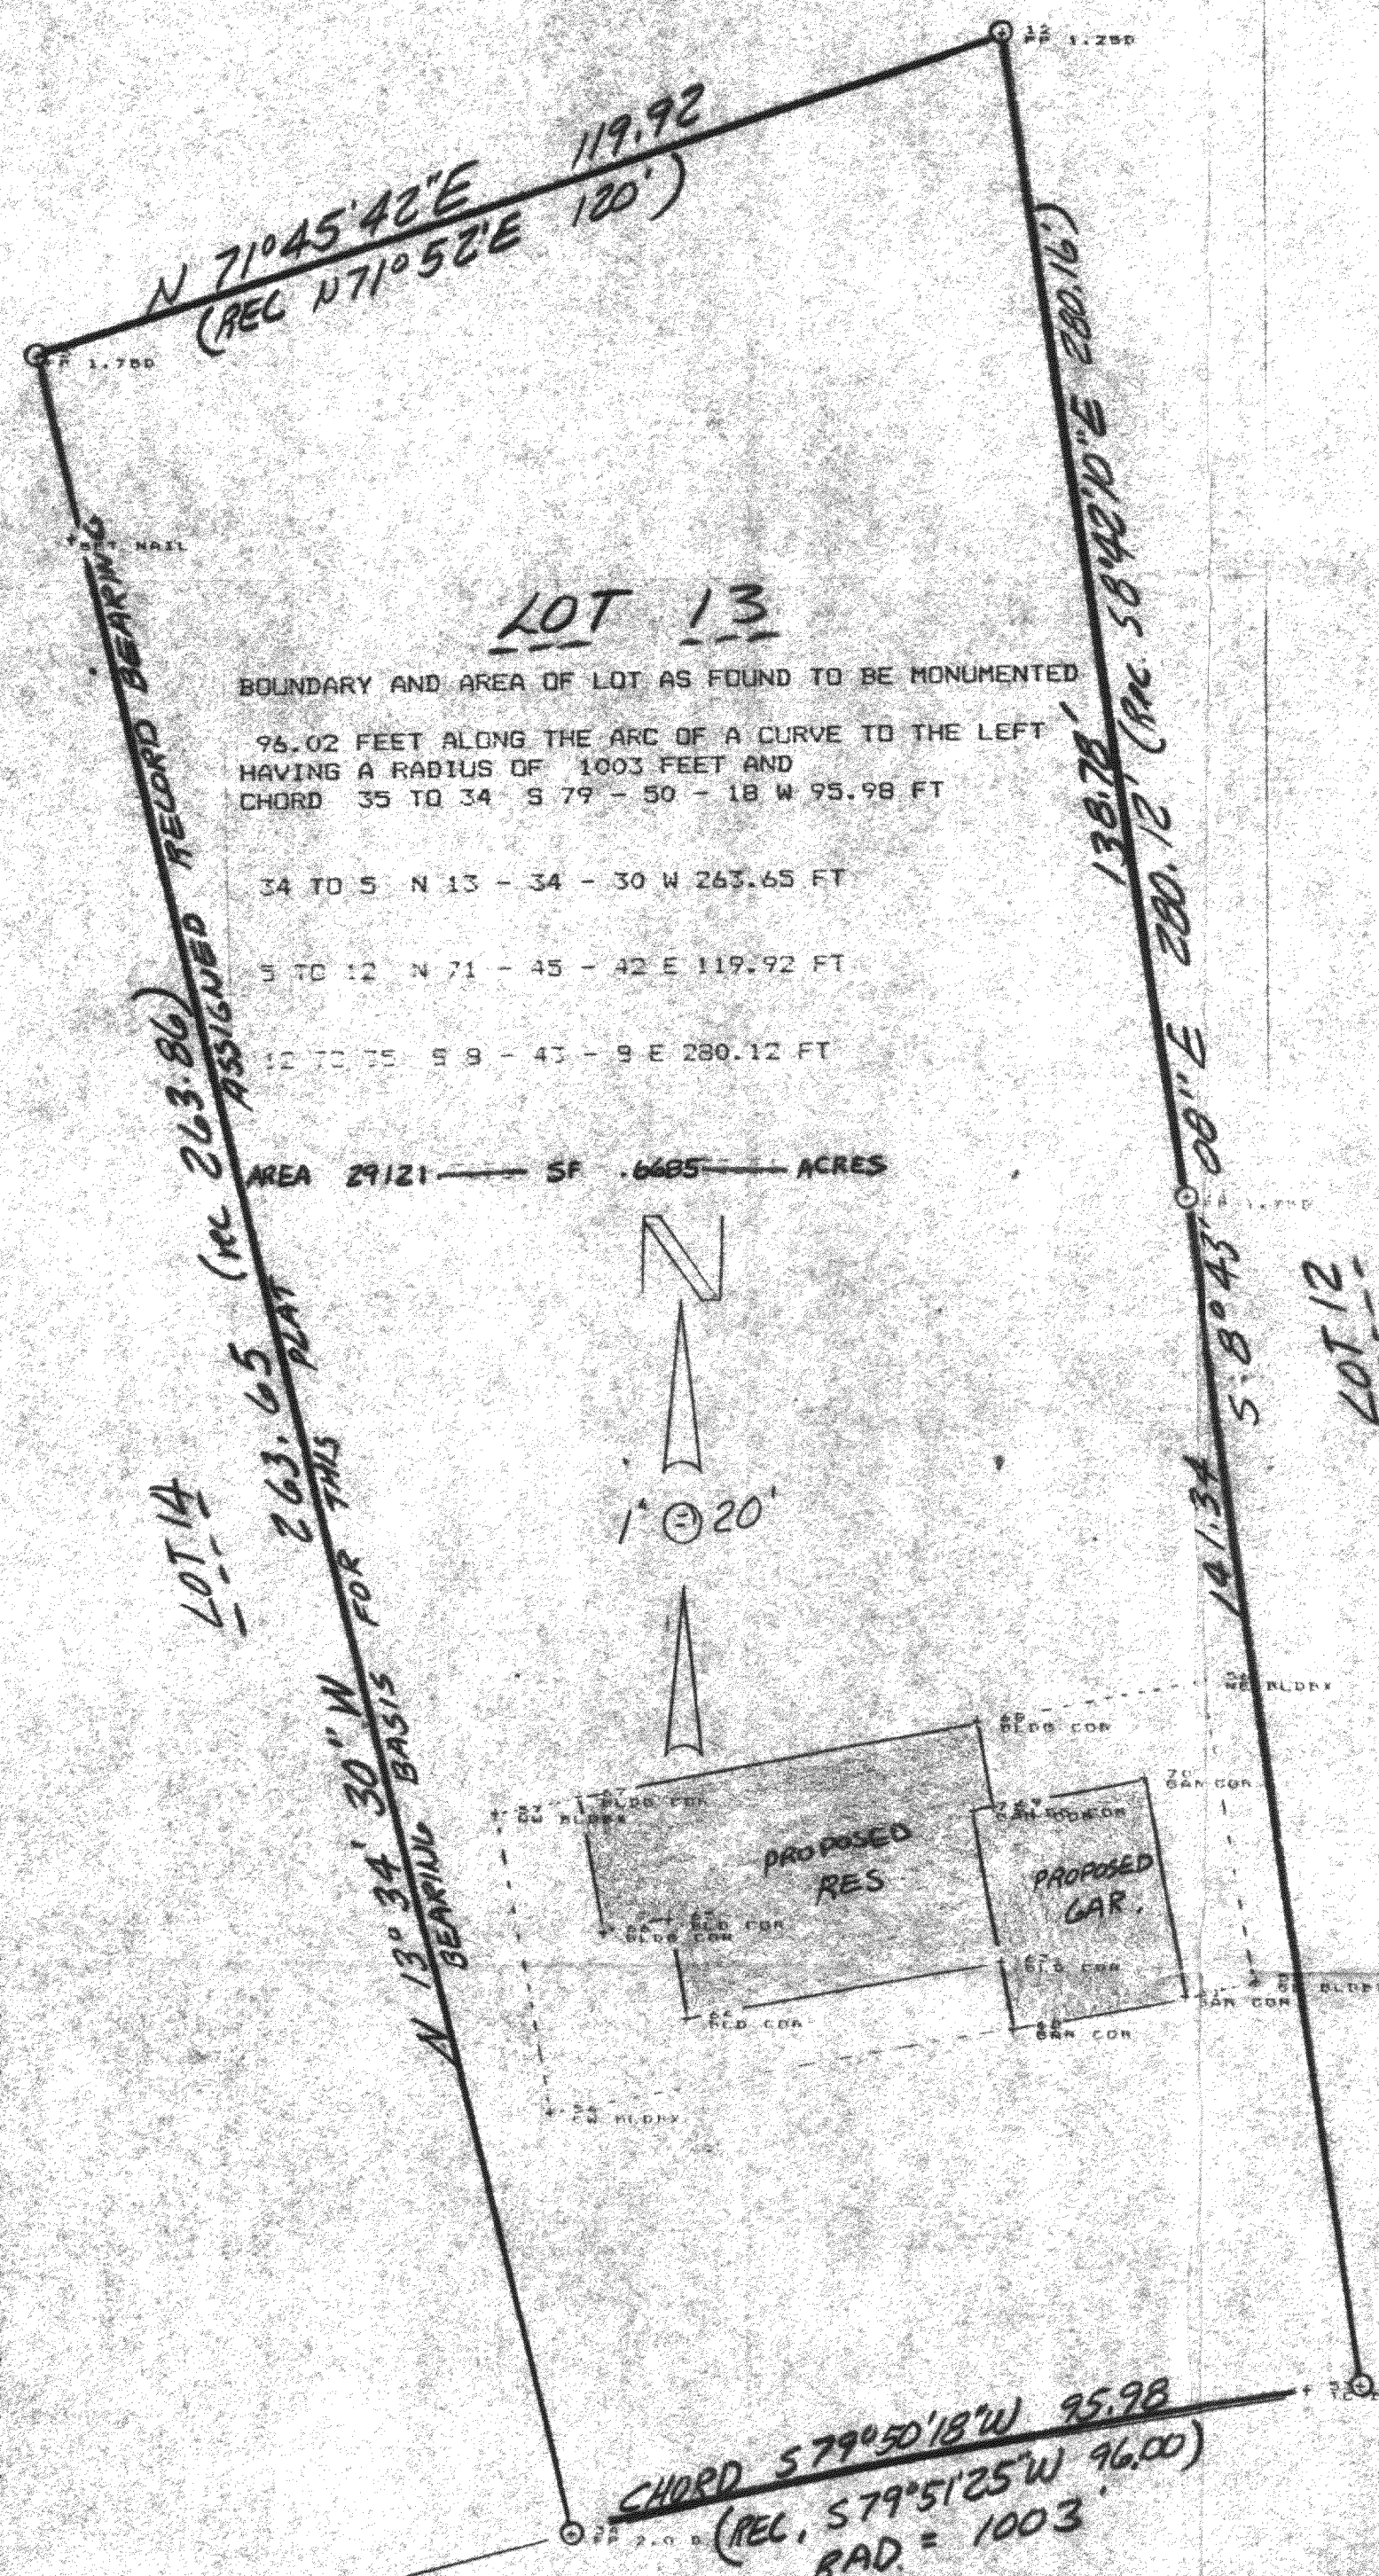

FLAT OF SURVEY OF LOT 13 OF GENEVA TERRITORY
FIRST ADDITION LOCATED IN THE SOUTHEAST 1/4 OF
SECTION 29, TOWN 2 NORTH, RANGE 18 EAST,
WALWORTH COUNTY, WISCONSIN

WORK ORDERED BY: THELEN TOTAL CONSTRUCTION

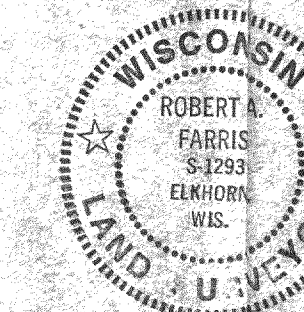

COPIES OF THIS MAP TO WHICH THE FOLLOWING CERTIFICATE WILL APPLY ARE BLUE LINE PRINTS SHOWING SURVEYOR'S ORIGINAL SEAL AND SIGNATURE IN BLACK INK. COPIES BY ANY OTHER MEANS MAY HAVE ALTERATIONS WHICH DO NOT REPRESENT THE SURVEYOR'S WORK PRODUCT.

HEREBY CERTIFY THAT THE ABOVE DESCRIBED PROPERTY HAS BEEN SURVEYED UNDER MY DIRECTION AND THAT THE ABOVE MAP IS A TRUE REPRESENTATION THEREOF AND SHOWS THE SIZE AND LOCATION OF THE PROPERTY AND ITS EXTERIOR BOUNDARIES. THIS SURVEY IS MADE FOR THE USE OF THE PRESENT OWNERS OF THE PROPERTY, AND ALSO THOSE WHO PURCHASE, MORTGAGE, OR GUARANTEE THE TITLE THEREIN WITHIN ONE YEAR FROM THE DATE HEREOF.

Robert Farris
9/25/91

FLAT OF SURVEY OF LOT 13 OF GENEVA TERRITORY
FIRST ADDITION LOCATED IN THE SOUTHEAST 1/4 OF
SECTION 29, TOWN 2 NORTH, RANGE 18 EAST,
WALWORTH COUNTY, WISCONSIN

FARRIS, HANSEN & ASSOCIATES, INC.
Engineering, Architecture, Surveying
7 Ridgway Court P.O. Box 437
ELKHORN, WISCONSIN 53121
Office: (414) 723-2098
Fax: (414) 723-5886

REVISIONS

PROJECT NO
3545
DATE
9/25/91
SHEET NO
1 of 1