MASTERCRAFT BUILDERS, INC.
Larry & Barb Czuchara

PLAT OF SURVEY


LOCATION: 2615 Echo Lane, Lyons, Wisconsin

LEGAL DESCRIPTION: Lot 13 in KNOB HILL SUBDIVISION, located in Town 2 North, Range 18 East, in the Town of Lyons, Walworth County, Wisconsin.

October 1, 1993

Survey No. 82844

RECEIVED
OCT 29 1993

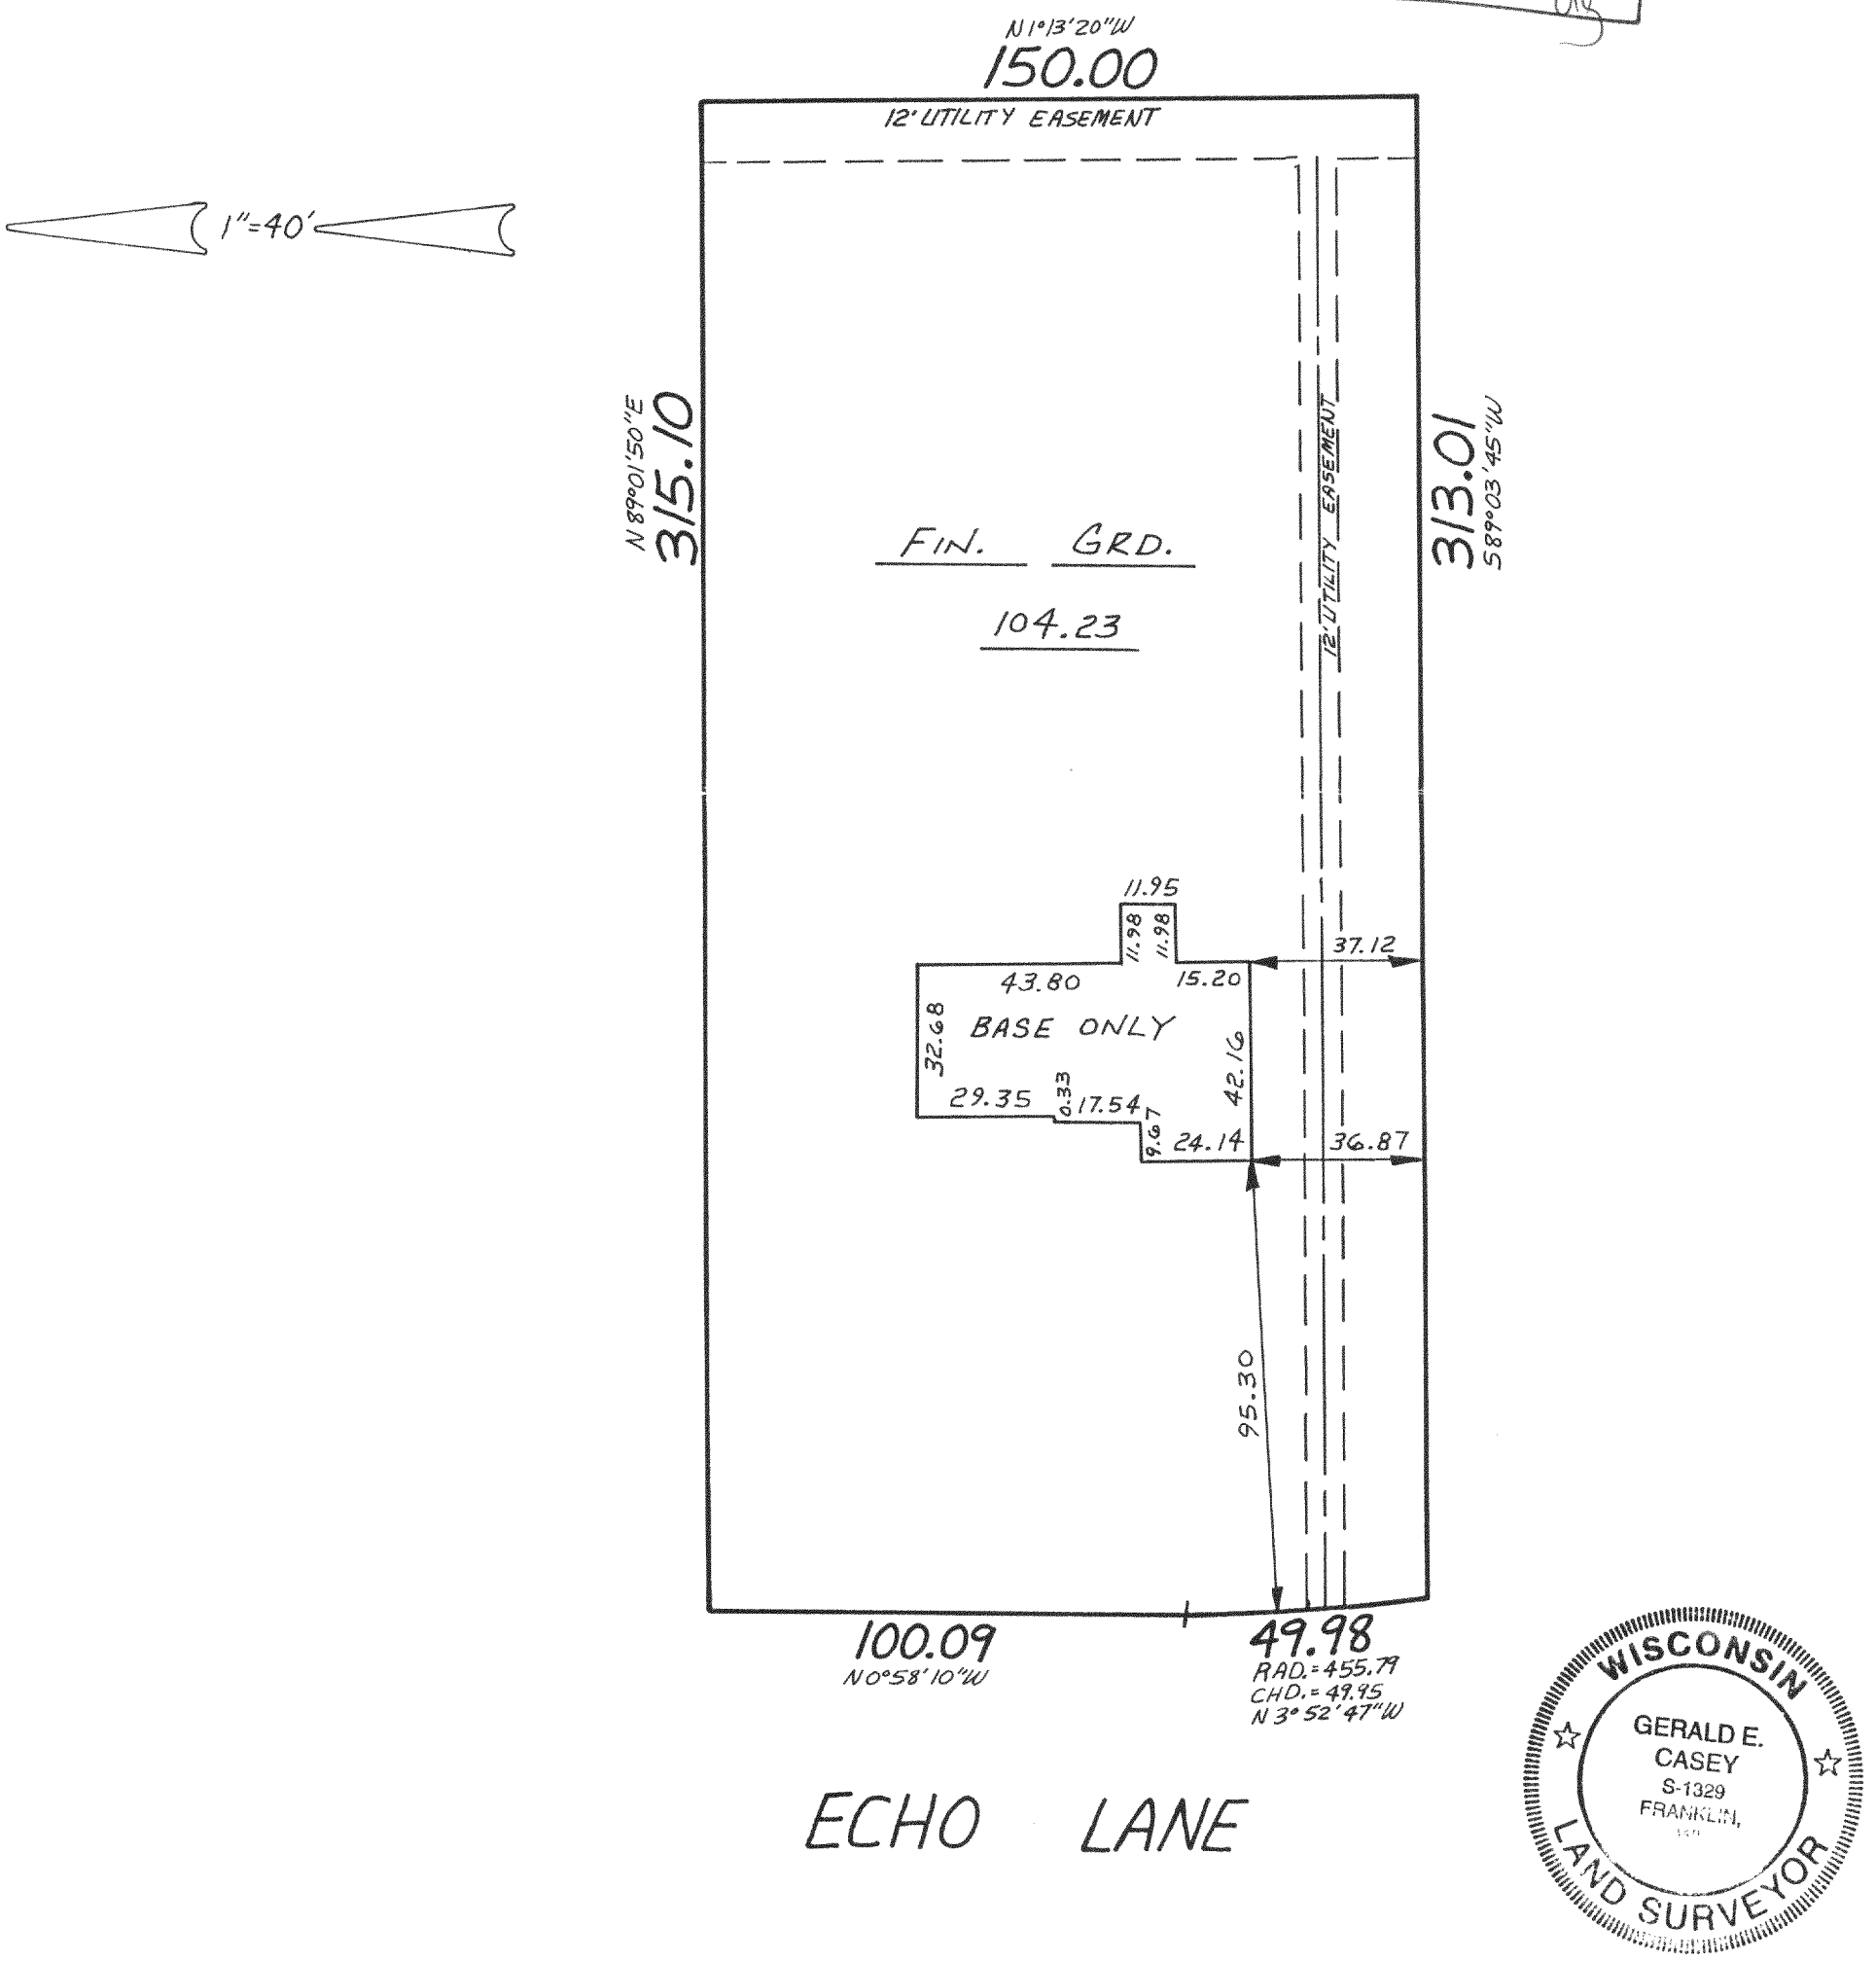

WISCONSIN
GERALD E. CASEY
S-1329
FRANKLIN,
LAND SURVEYOR

METROPOLITAN SURVEY SERVICE, INC.
REGISTERED LAND SURVEYORS
9415 W. FOREST HOME AVE., SUITE 202, HALES CORNERS, WI 53130
PH. 529-5380 FAX 529-9787

I HEREBY CERTIFY THAT I HAVE SURVEYED THE ABOVE DESCRIBED PROPERTY AND THAT THE ABOVE MAP IS A TRUE REPRESENTATION THEREOF AND SHOWS THE SIZE AND LOCATION OF THE PROPERTY, ITS EXTERIOR BOUNDARIES, THE LOCATION OF ALL VISIBLE STRUCTURES AND DIMENSIONS OF ALL PRINCIPAL BUILDINGS THEREON, BOUNDARY FENCES, APPARENT EASEMENTS AND ROADWAYS AND VISIBLE ENCROACHMENTS, IF ANY.

THIS SURVEY IS MADE FOR THE EXCLUSIVE USE OF THE PRESENT OWNERS OF THE PROPERTY, AND ALSO THOSE WHO PURCHASE, MORTGAGE, OR GUARANTEE THE TITLE THERETO WITHIN ONE (1) YEAR FROM DATE HEREOF.

SIGNED

218-710

NE-13