
#20-67

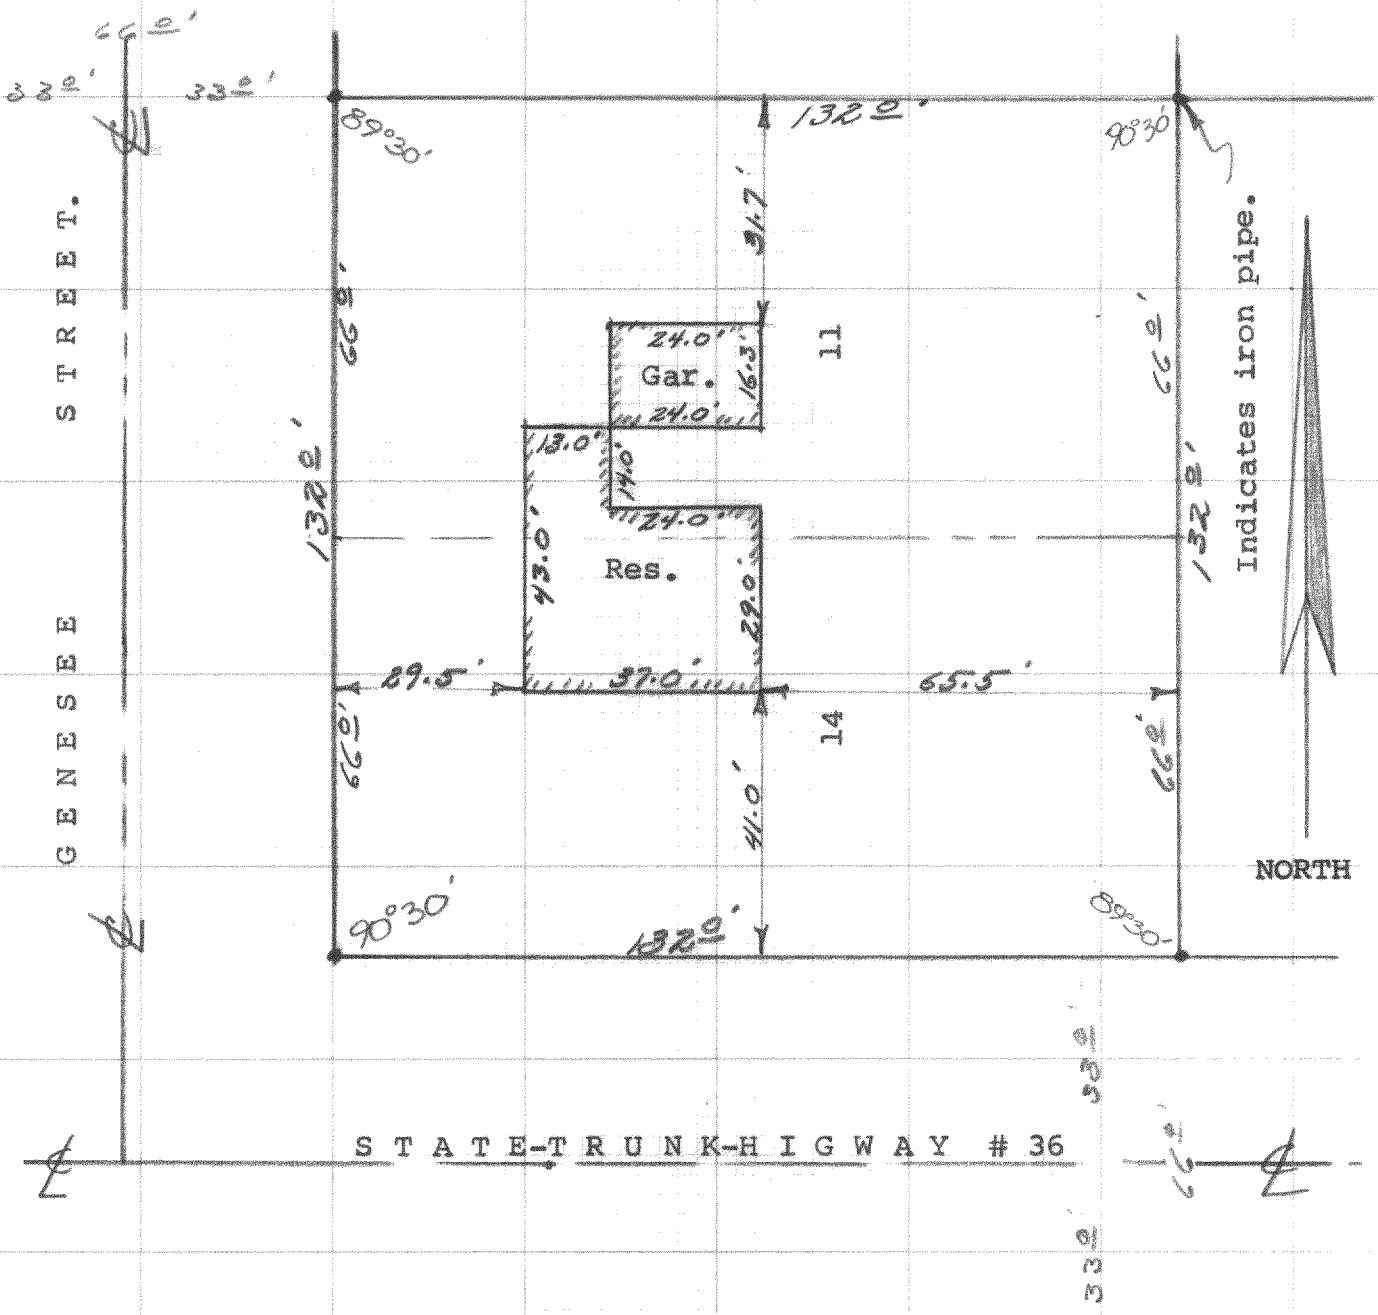

Description: Lot 11 and Lot 14 Block 1 of the Original Plat of Springfield; in the Village of Springfield; Walworth County Wisconsin.

Certificate: I hereby certify that I have surveyed the above mentioned property and that the hereon portrayed is an accurate survey and a true representation thereof and correctly shows the exterior boundary lines and the location of the buildings and the other improvements thereof.

Dated March 4th 1967.

WISCONSIN JAMES F. BIAGI MILWAUKEE WIS. LAND SURVEYOR

James F. Biagi RLS 272
Elkhorn; Wisconsin.

218-75B