
50-9

218-80

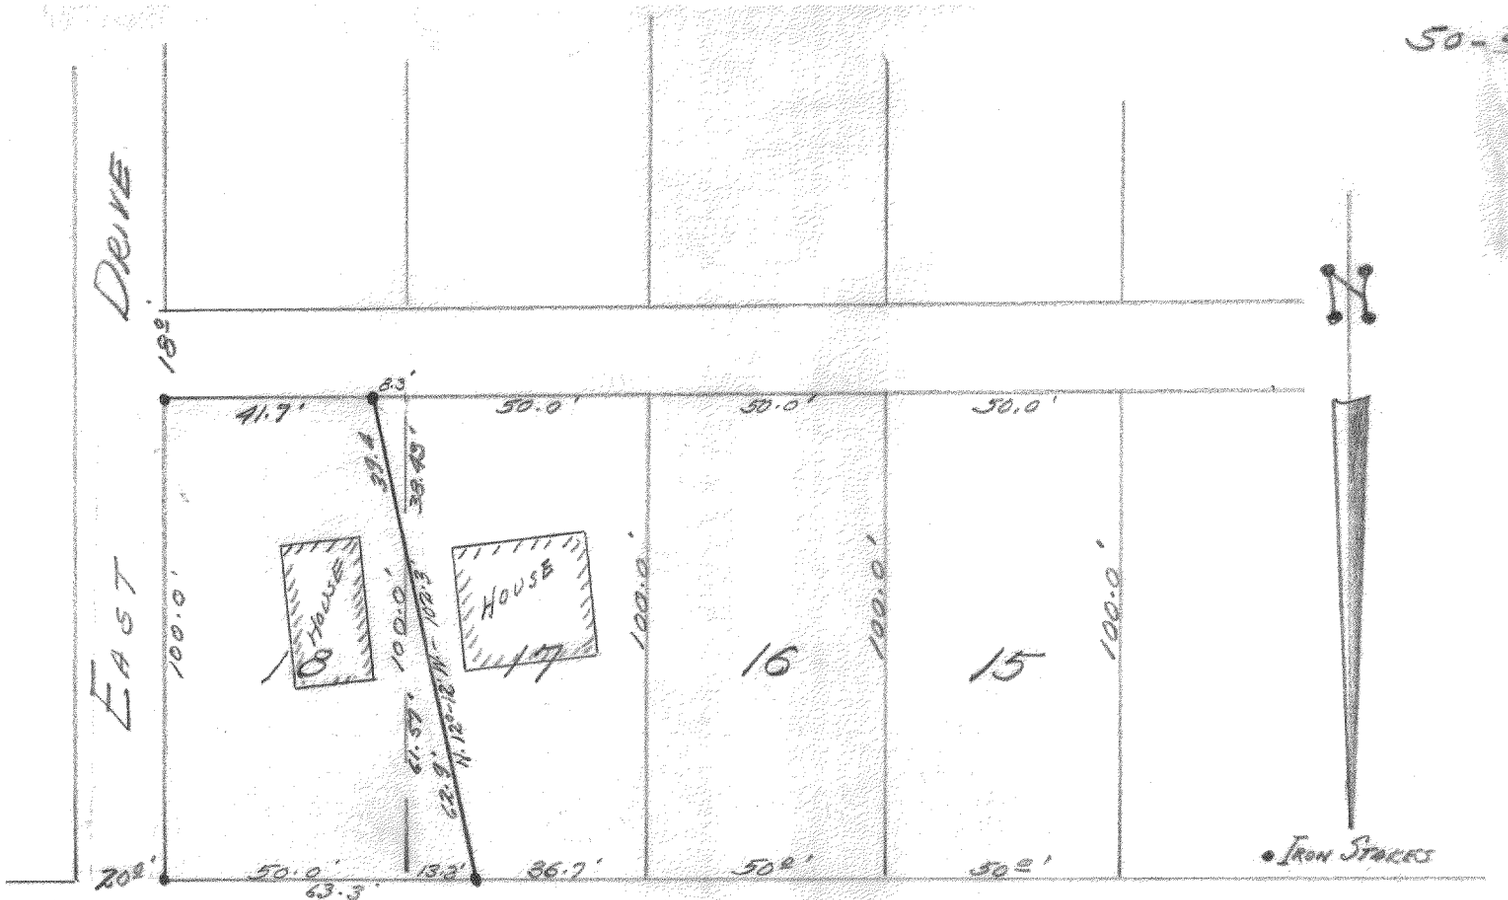

STATE TRUNK HIGHWAY #50

DESCRIPTION:

Commencing at an iron stake at the southeast corner of Lot 18 of Lake Geneva Golf Hills Subdivision of a portion of Section 31, Township 2 north, Range 18 east of the 4th Principal Meridian, thence West 41.7 feet along the south line of said lot to an iron stake, thence N. 12°- 12' W., 102.3 feet to a point in the north line of Lot 17 of said subdivision, that is 13.3 feet west of the northeast corner of said lot 17, thence East 63.3 feet along the north lines of said lots 18 and 17, to an iron stake at the north east corner of said lot 18, thence South 100.0 feet along the east line of said lot 18 to the place of beginning.

CERTIFICATE:

I, hereby certify that I have on this the 24th day of March 1950, surveyed the above described property according to the official records on file in the office of the Recorder of Deeds inand for Walworth County, Wisconsin, and find that the measurements and bearings of the boundary lines of said property as taken at the site on this day substantially agree with those in said official record and that no encroachments exist.
SIGNED AND SEALED ON THIS THE 27TH DAY OF MARCH 1950.

Joseph M. Biagi.

Joseph M. Biagi. Professional Engineer.
Elkhorn Wisconsin.

218-80B