
61-17

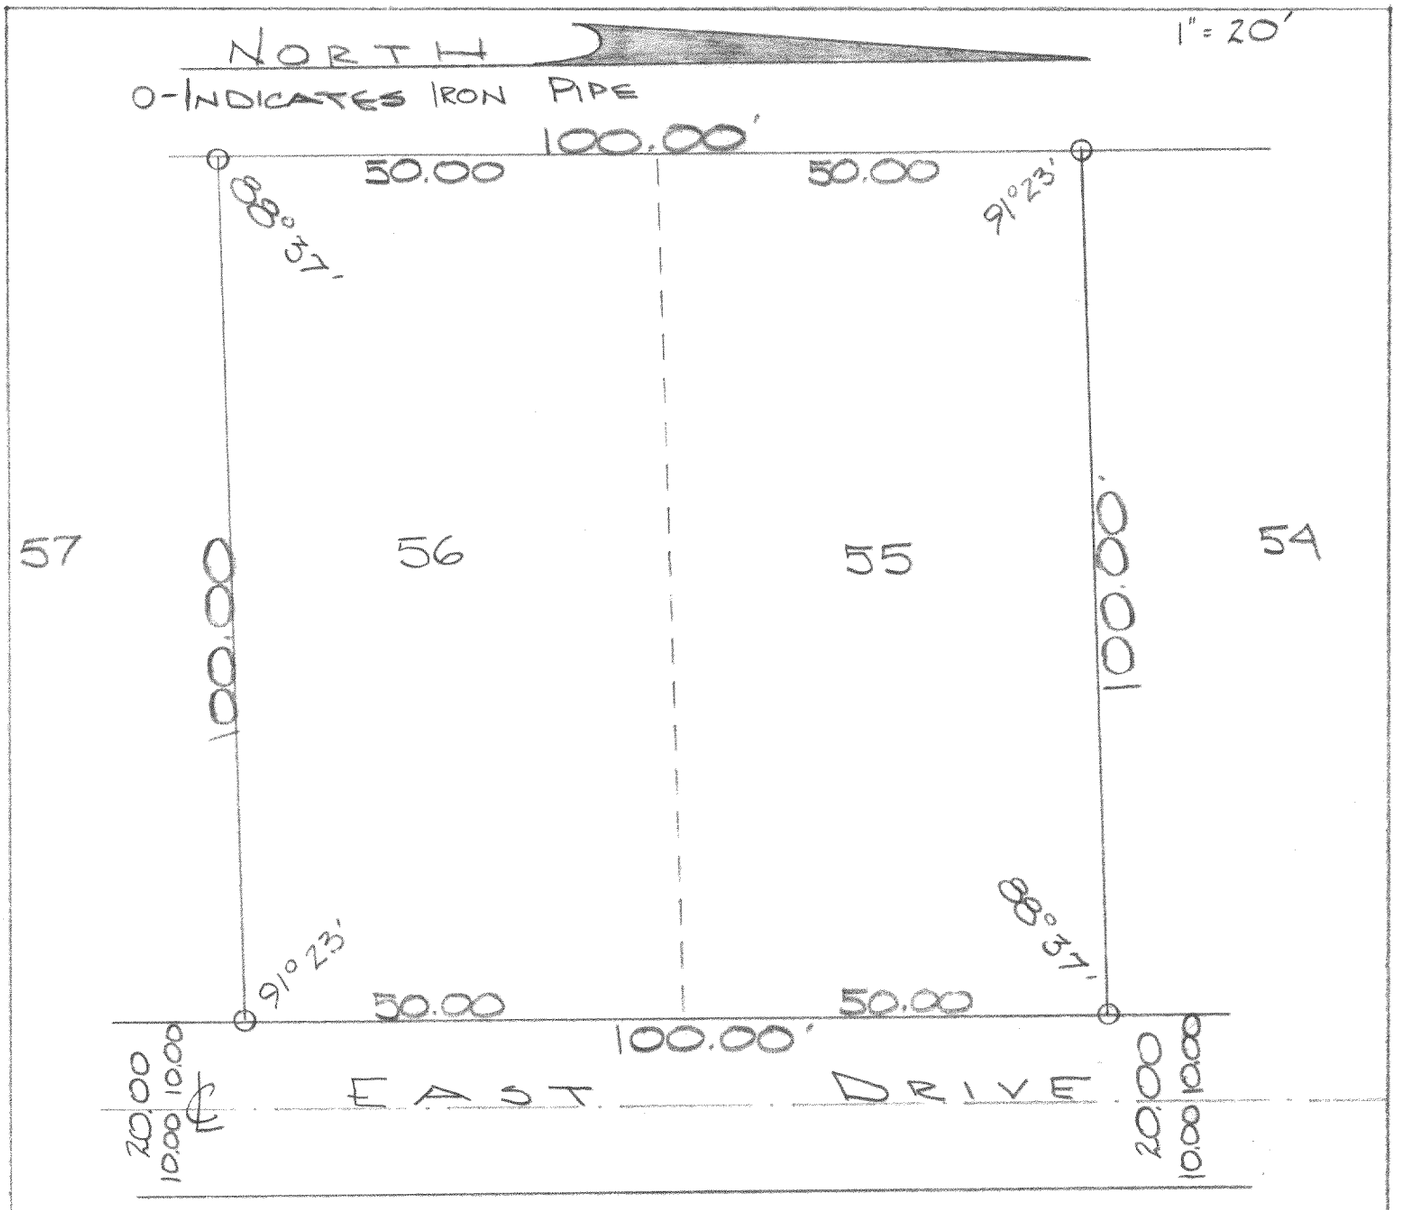

DESCRIPTION: Lots 56 and 55 of Golf Hills Subdivision, located in Section 31 T. 3 N., R. 18 E. Walworth County Wisconsin.

CERTIFICATE: I, James F. Biagi, surveyor, do hereby certify that I have surveyed the property hereon described on this 9th day of December 1961.

WISCONSIN
JAMES F. BIAGI
MILWAUKEE, WIS.
LAND SURVEYOR

James F. Biagi RLS 272

218-84 B

218-84 B