
46-50

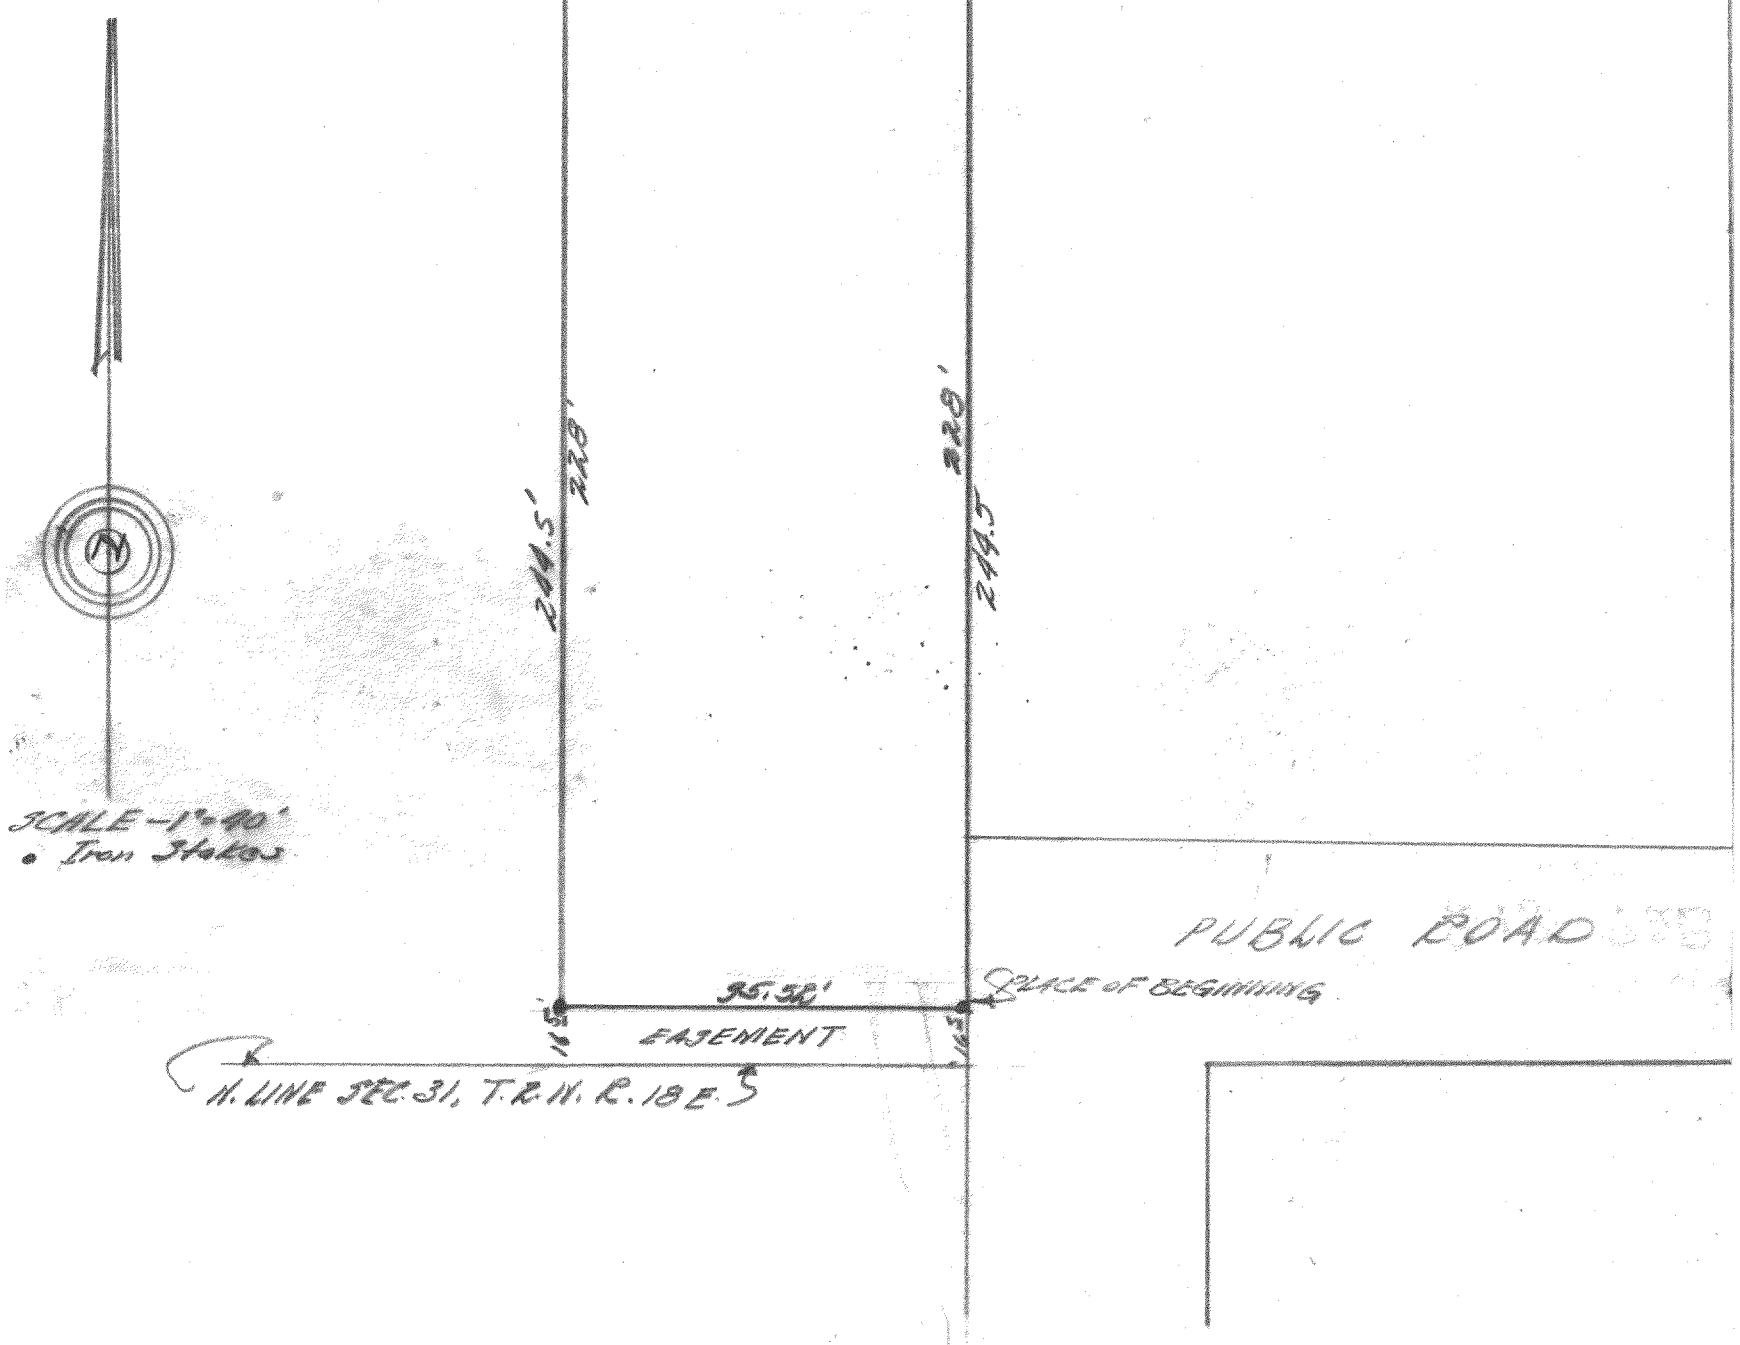

DESCRIPTION: Commencing at an iron stake 16.5 feet North of the intersection of the North line of Section 31, Town 2 north, Range 18 e ast of the 4th P.M., and the west line of the public road in the N.E.$\frac{1}{4}$ of the N.W.$\frac{1}{4}$ of said Section 31, thence North 228 fe et to an iron stake, thence West 95.52 feet to an iron stake, thence South 228 feet to an iron stake, thence East 95.52 feet, to the place of beginning. Containing 50/100 acres more or less.
Certificate; I, hereby certify that I have on this the 13th day of July 1946, surveyed the above described property according to the official records on file in the office of the Recorder of Deeds in and for Walworth County, Wisconsin, and find that the measurements and bearings of the boundary lines of said property as taken on this day substantially agree with those in the above description and that no encroachments exist.
SIGNED AND SEALED THIS 15TH ADY OF JULY 1946.

Joseph M. Biagi Professional Engineer
Elkhorn Wisconsin.

Lyons

46-50

-4-30-14

218-92 B