
GEORGE T. DUNHAM

SURVEYING & SUBDIVIDING

DELAVAN, WISCONSIN

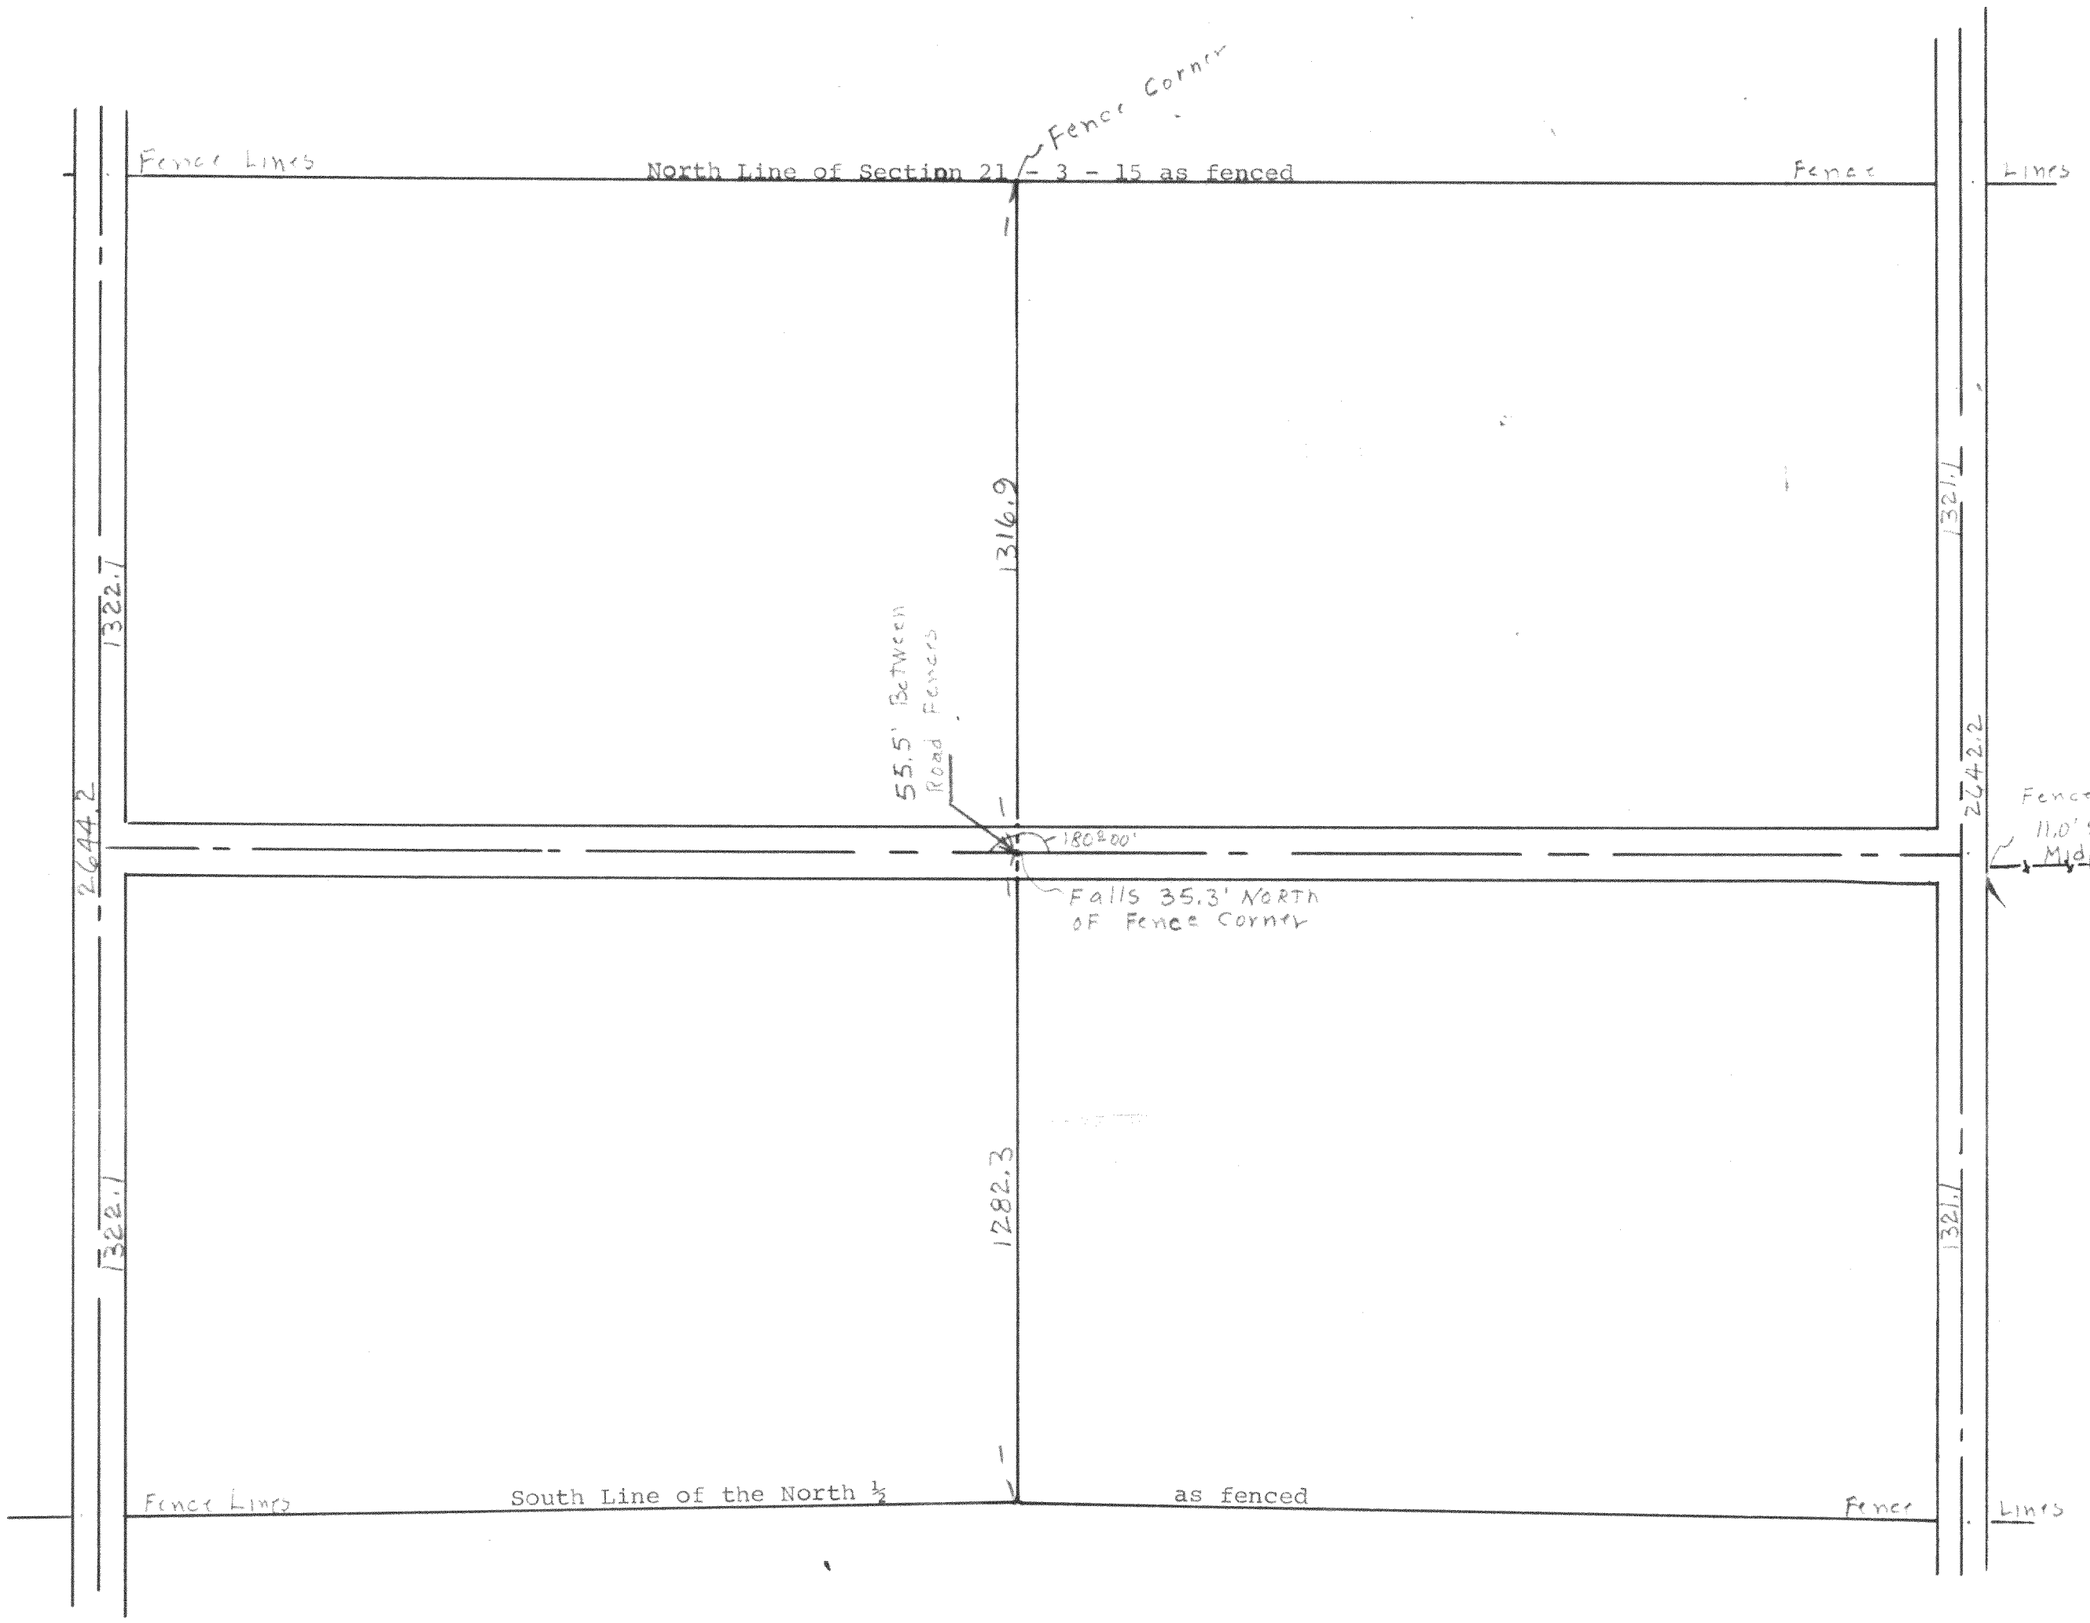

R-21-1
21-2
21-3 & R-21-3B
21-4
21-5

Sketch showing North-South Measurements of the North½ of Section 21 along and between existing fence lines T 3 N, R 15 E, Walworth County, Wisconsin.
July 1966

315-11

George T. Dunham
George T. Dunham, Surveyor