AMBIT LAND SURVEYING
P. O. Box 42
Bassett, Wisconsin 53101-0042

# PLAT OF SURVEY
## OF

PHONE: 262-537-4874
FAX: 262-537-4221

Lots 3, 4, 5, and 6, in Block 24 of SKANSEN SWEDISH TRIBUNE-NEWS SUBDIVISION, in the Southwest Quarter of Section 9, Township 3 North, Range 15 East of the 4th Principal Meridian, Town of Richmond, Walworth County, Wisconsin.

PARCEL IDENTIFICATION NO. Lots 3 & 4: CS 00354
PARCEL IDENTIFICATION NO. Lots 5 & 6: CS 00355

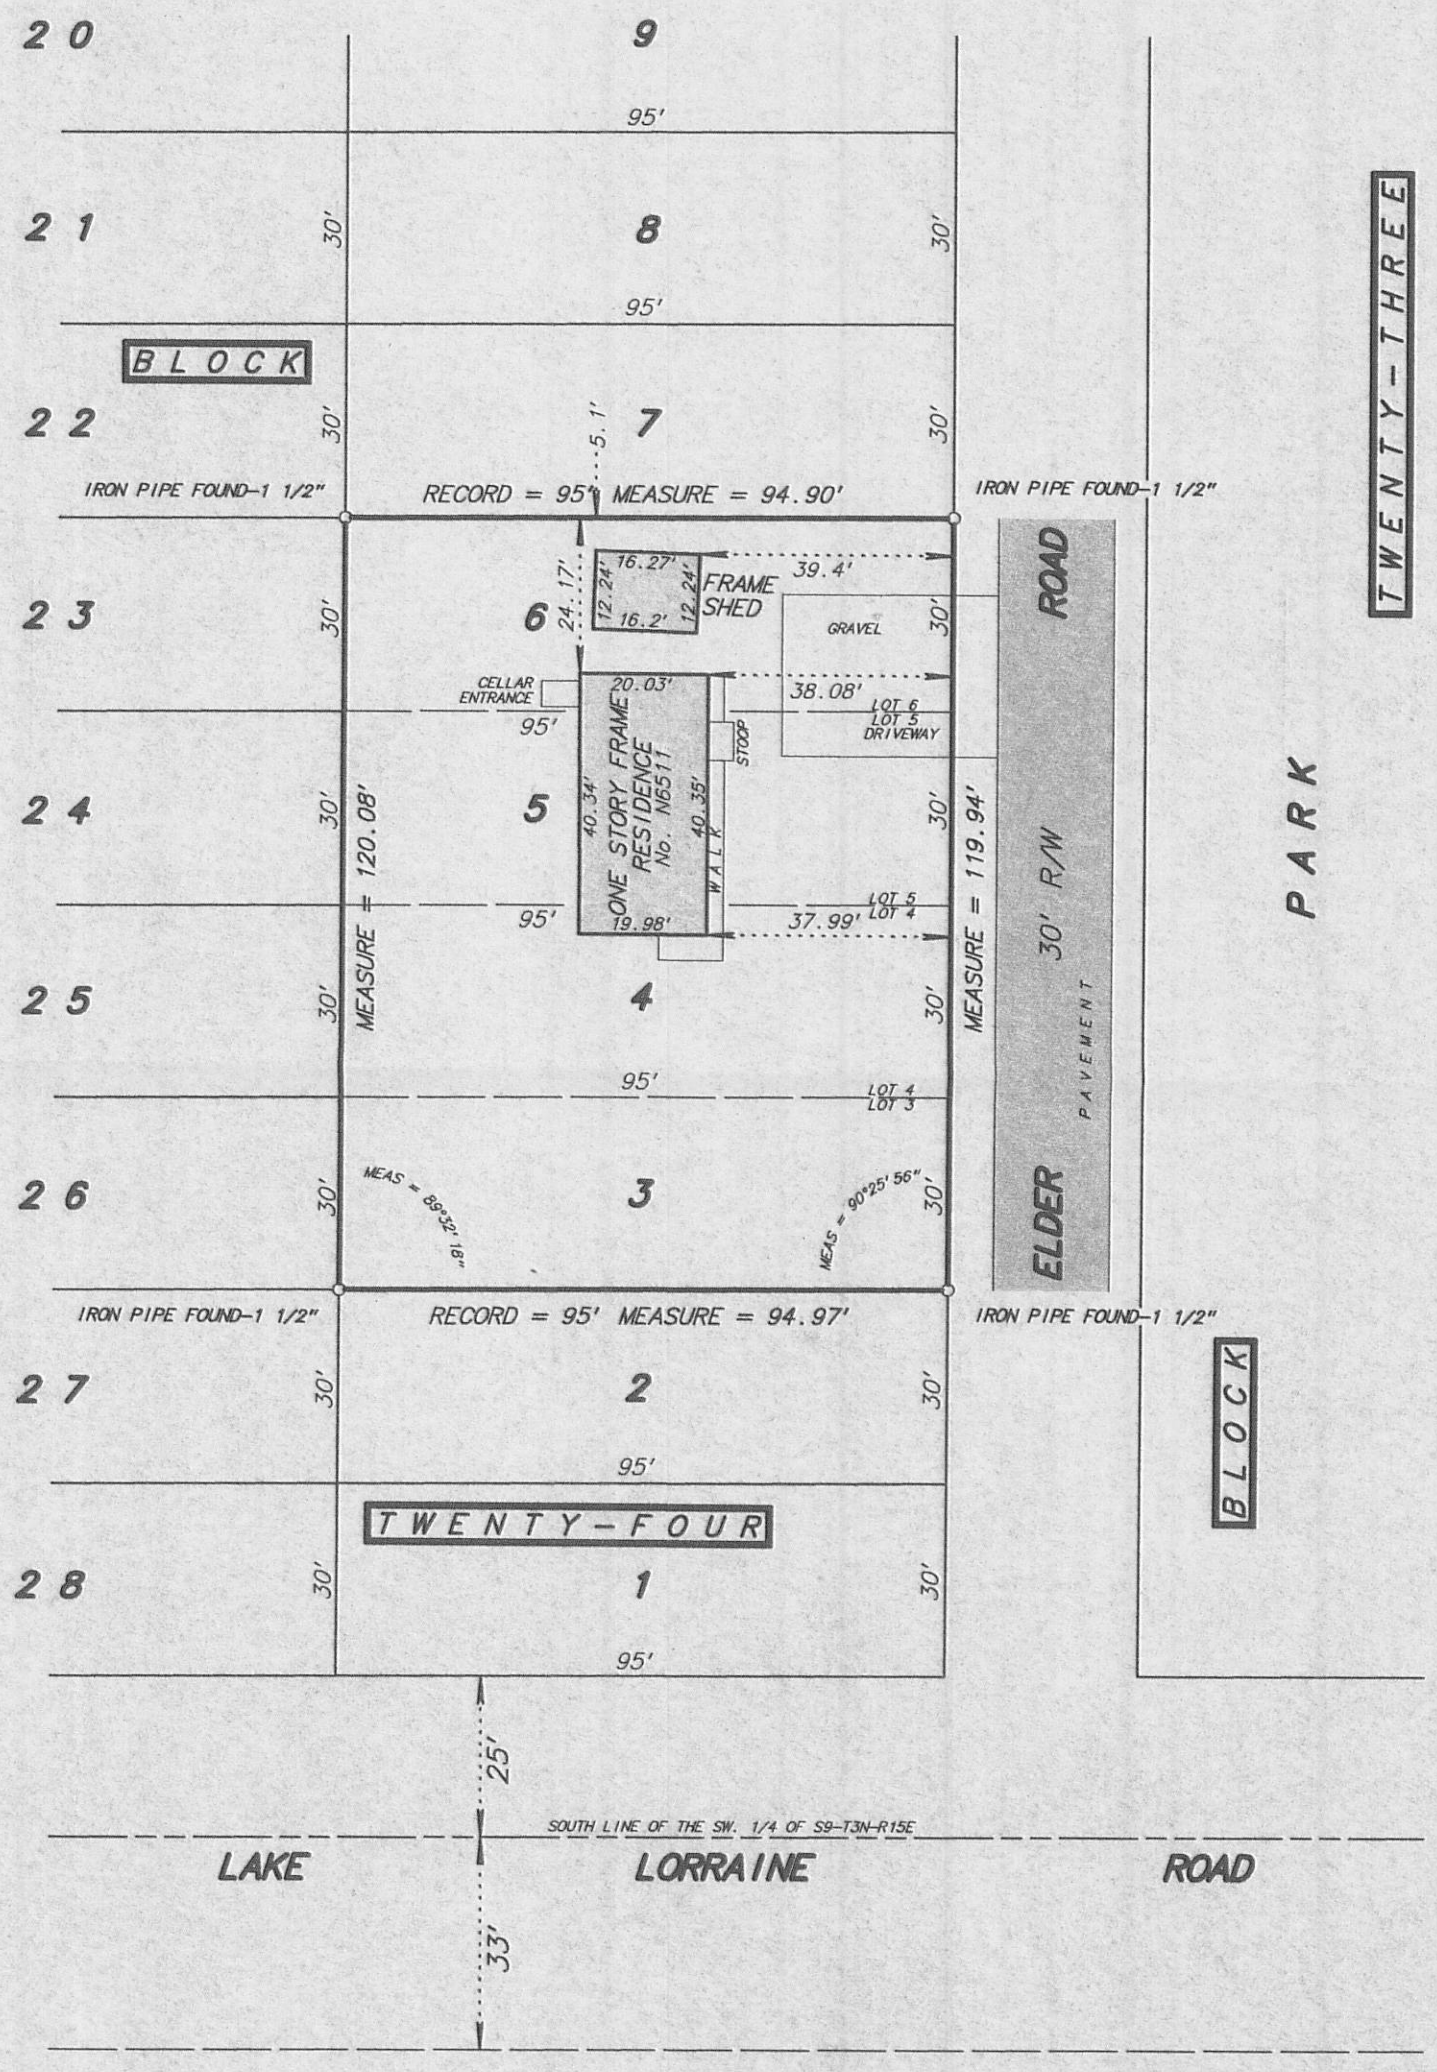


NOTE:
- THIS SURVEY IS A RETRACEMENT OF A SURVEY SIGNED BY ROBERT A. FARRIS, S-1293, OF FARRIS, HANSEN & COOPER, INC., DATED AUGUST 10, 1978.

SCALE: 1 inch = 30 feet
ORDERED BY: J. Lehmann
JOB NO. 07211

Fieldwork completed on and date of certification: September 14, 2007

I hereby certify that I have surveyed the above described property and the above plat is a true representation thereof and shows the size and location of the property, its exterior boundaries, the location and dimensions of all visible structures thereon, boundary fences, apparent easements and roadways and visible encroachments, if any.

This survey is made for the exclusive use of the present owners of the property, and also those who purchase, mortgage or guarantee the title thereto within ONE YEAR from the date hereof.

Dated at Bassett, Wisconsin this _____ day of _____ 2007.

Mark A. Bolender
Wisconsin Registered Land Surveyor S - 1784

CS - 354

RECEIVED
MAY 05 2010
By BMF

315-1116