

Plat of Survey


of

Lots 1, 2, 3 and 4 in Block 2 of Skansen Swedish Tribune News Subdivision,


located in the Southwest 1/4 and the Southeast 1/4 of Section 9, Town 3
North, Range 15 East, Town of Richmond, Walworth County, Wisconsin.

Surveyed for: **Robert Harris**
1519 Pine Needles Lane
Lexington, Kentucky, 40513-1503

Center 1/4 Corner
Section 9-3-15.
N. 269.749.64
E. 2,341.249.71

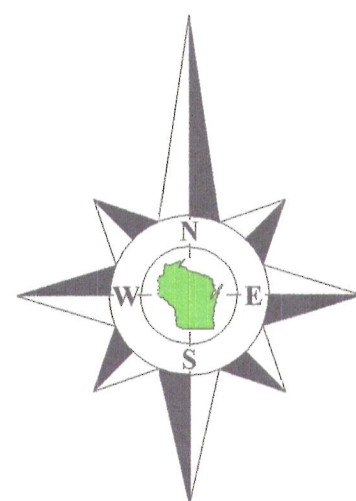

Bearings reference to the Wisconsin State
Plane Coordinate System, South Zone.

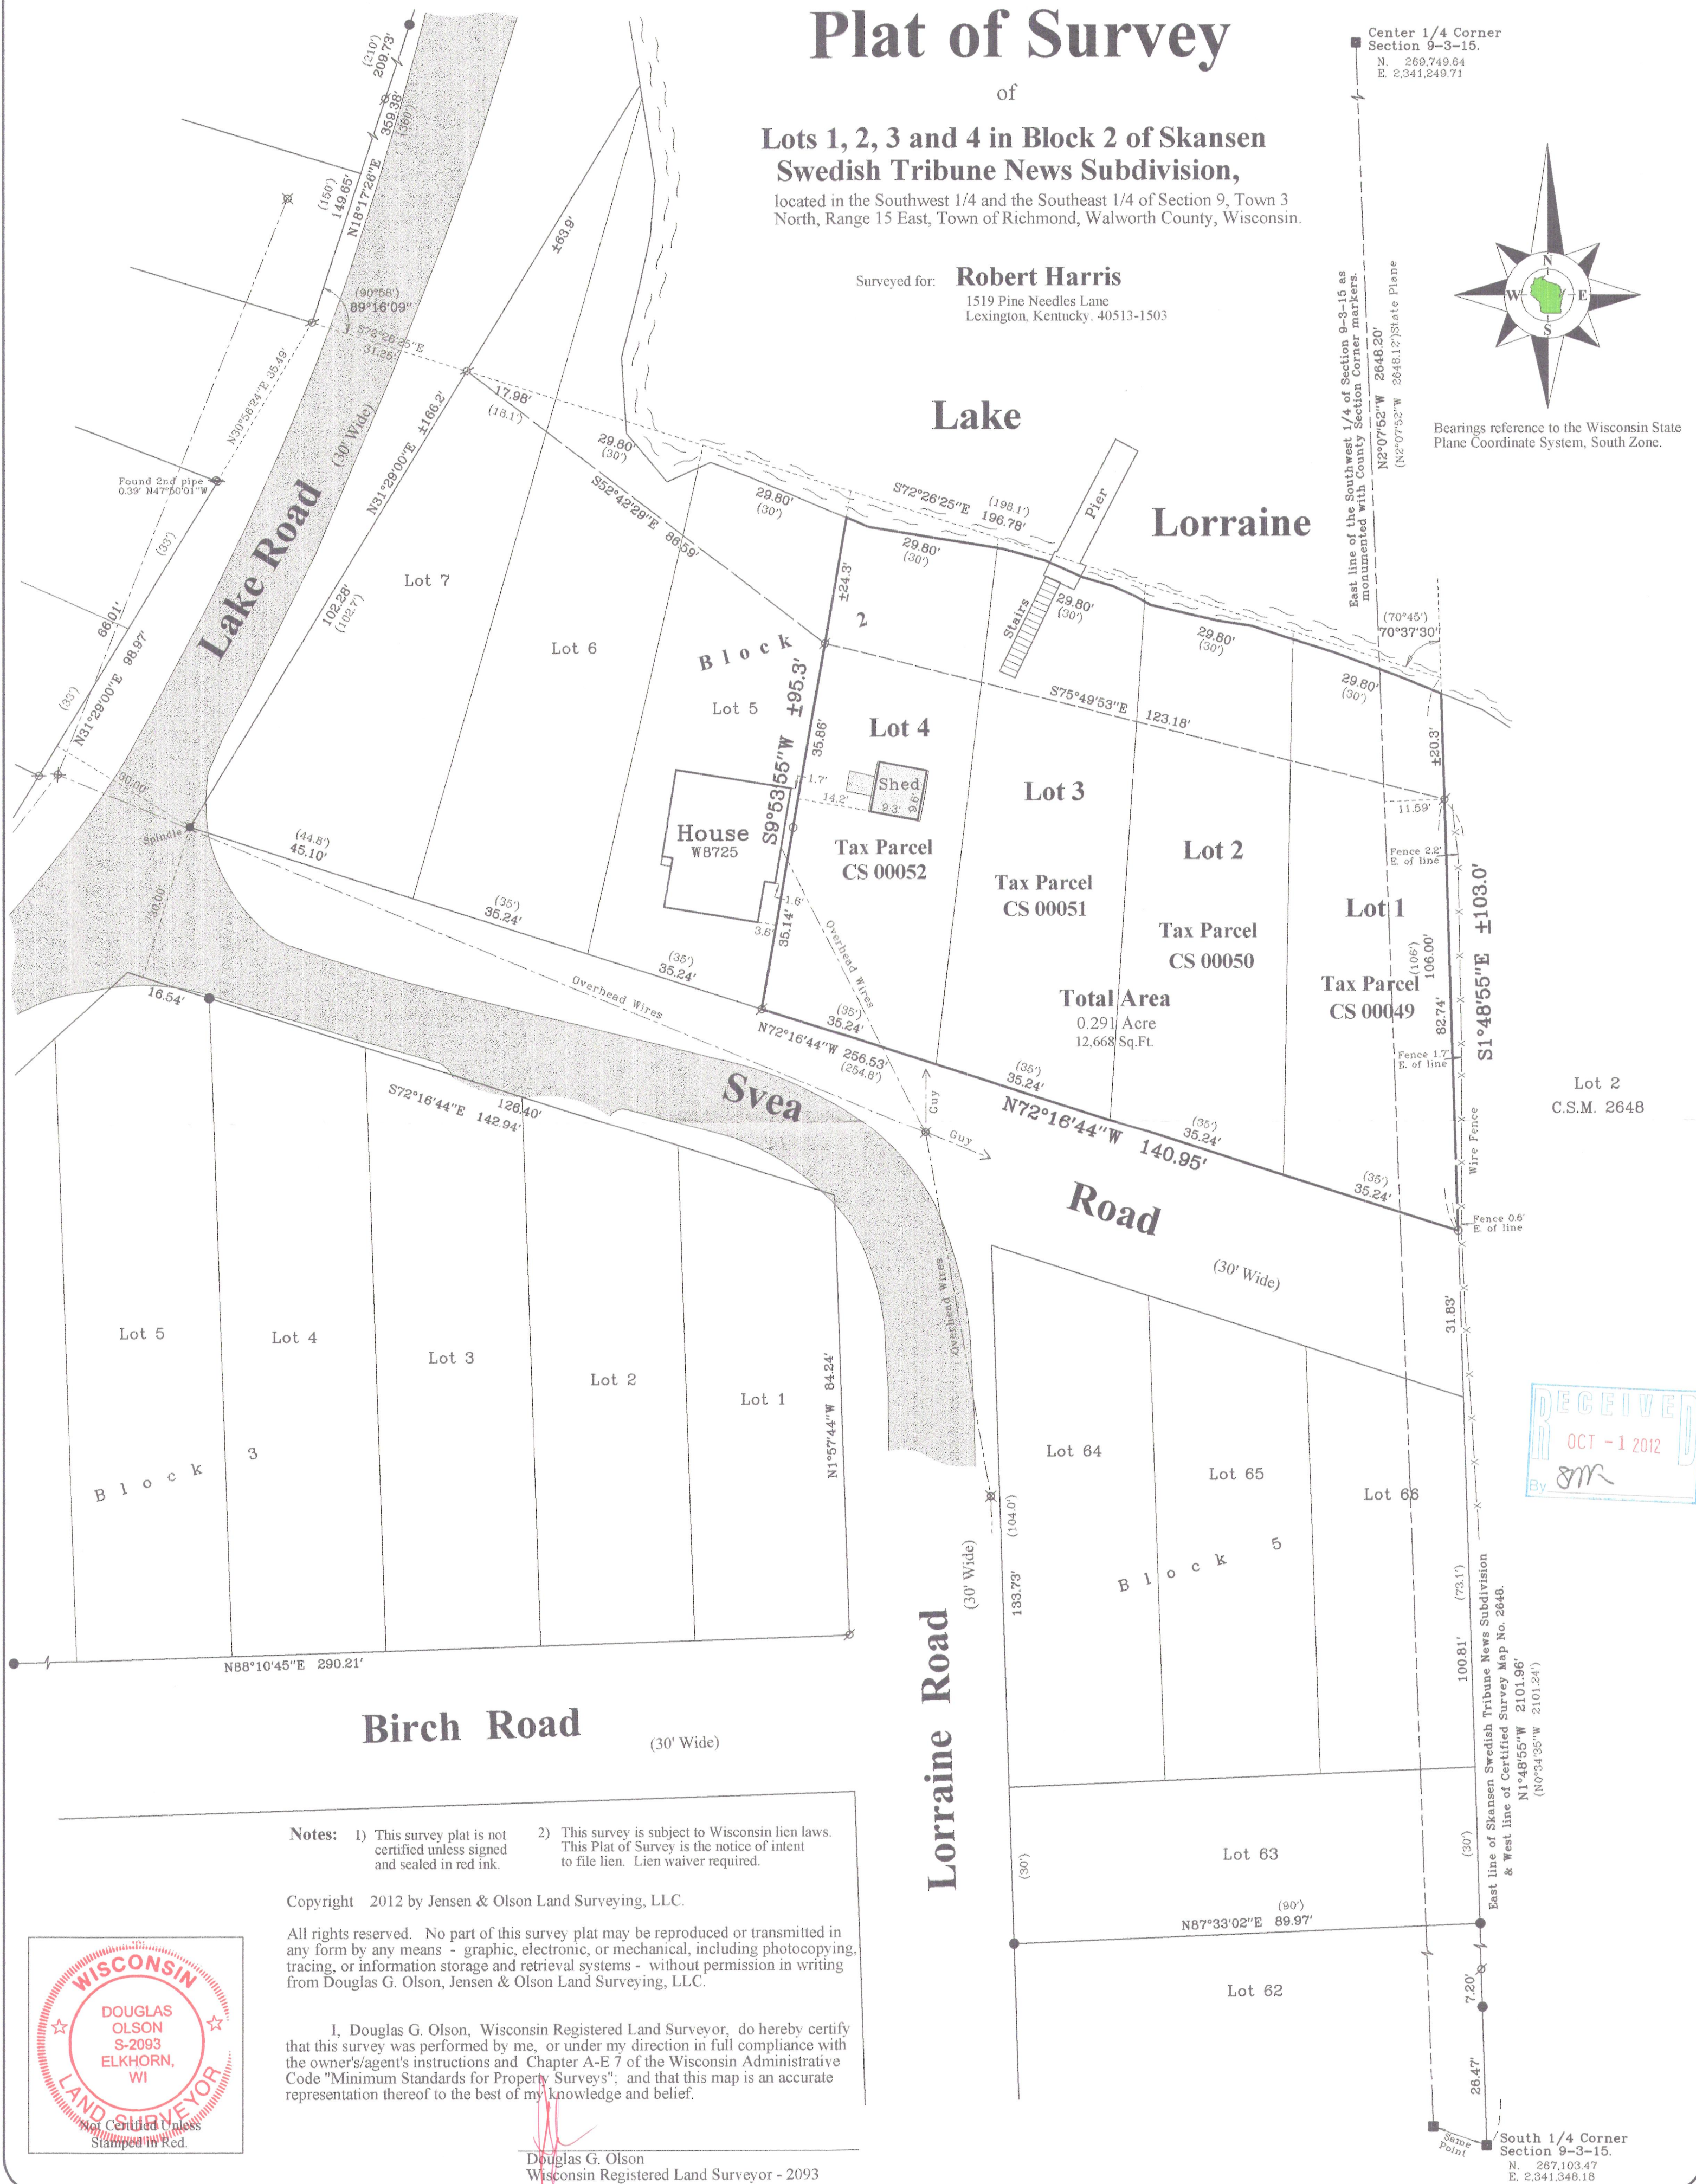


- Notes:** 1) This survey plat is not certified unless signed and sealed in red ink. 2) This survey is subject to Wisconsin lien laws. This Plat of Survey is the notice of intent to file lien. Lien waiver required.

Copyright 2012 by Jensen & Olson Land Surveying, LLC.

All rights reserved. No part of this survey plat may be reproduced or transmitted in any form by any means - graphic, electronic, or mechanical, including photocopying, tracing, or information storage and retrieval systems - without permission in writing from Douglas G. Olson, Jensen & Olson Land Surveying, LLC.

I, Douglas G. Olson, Wisconsin Registered Land Surveyor, do hereby certify that this survey was performed by me, or under my direction in full compliance with the owner's/agent's instructions and Chapter A-E 7 of the Wisconsin Administrative Code "Minimum Standards for Property Surveys"; and that this map is an accurate representation thereof to the best of my knowledge and belief.

Douglas G. Olson
Wisconsin Registered Land Surveyor - 2093

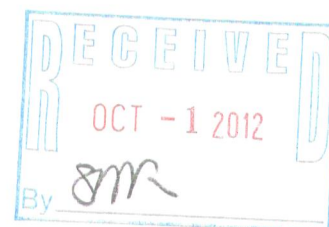

2012.024

Sheet 1 of 1 Sheets

Drawing Name: t3m15e-2012024-2012024Plat.sj

Job Reference Number

2012.024

Legend

- Found County Section Corner
- Found Iron Pipe
- Found Iron Rod
- Set Iron Pipe
- Recorded Information
- Utility Pole
- Asphalt Surface



Jensen & Olson Land Surveying, LLC

45 South Wisconsin Street * P.O. Box 322 * Elkhorn, Wisconsin. 53121

Telephone: (262) 723-3434 * Facsimile: (262) 723-8044

Email: jensen.olson@elknet.net

Scale in Feet
1" = 20'



Survey Date: March 28, 2012.

Revisions:

CS - 49 CS - 50 CS - 51 CS - 52

315-1178