Plat of Survey

of

Lot 18 of Meadowwood,

a subdivision located in the Southwest 1/4 of Section 12, Town 3 North, Range 15 East, Town of Richmond, Walworth County, Wisconsin.

Surveyed for: **Denise Markling**
113 Sandy Circle
Darien, Wisconsin. 53114

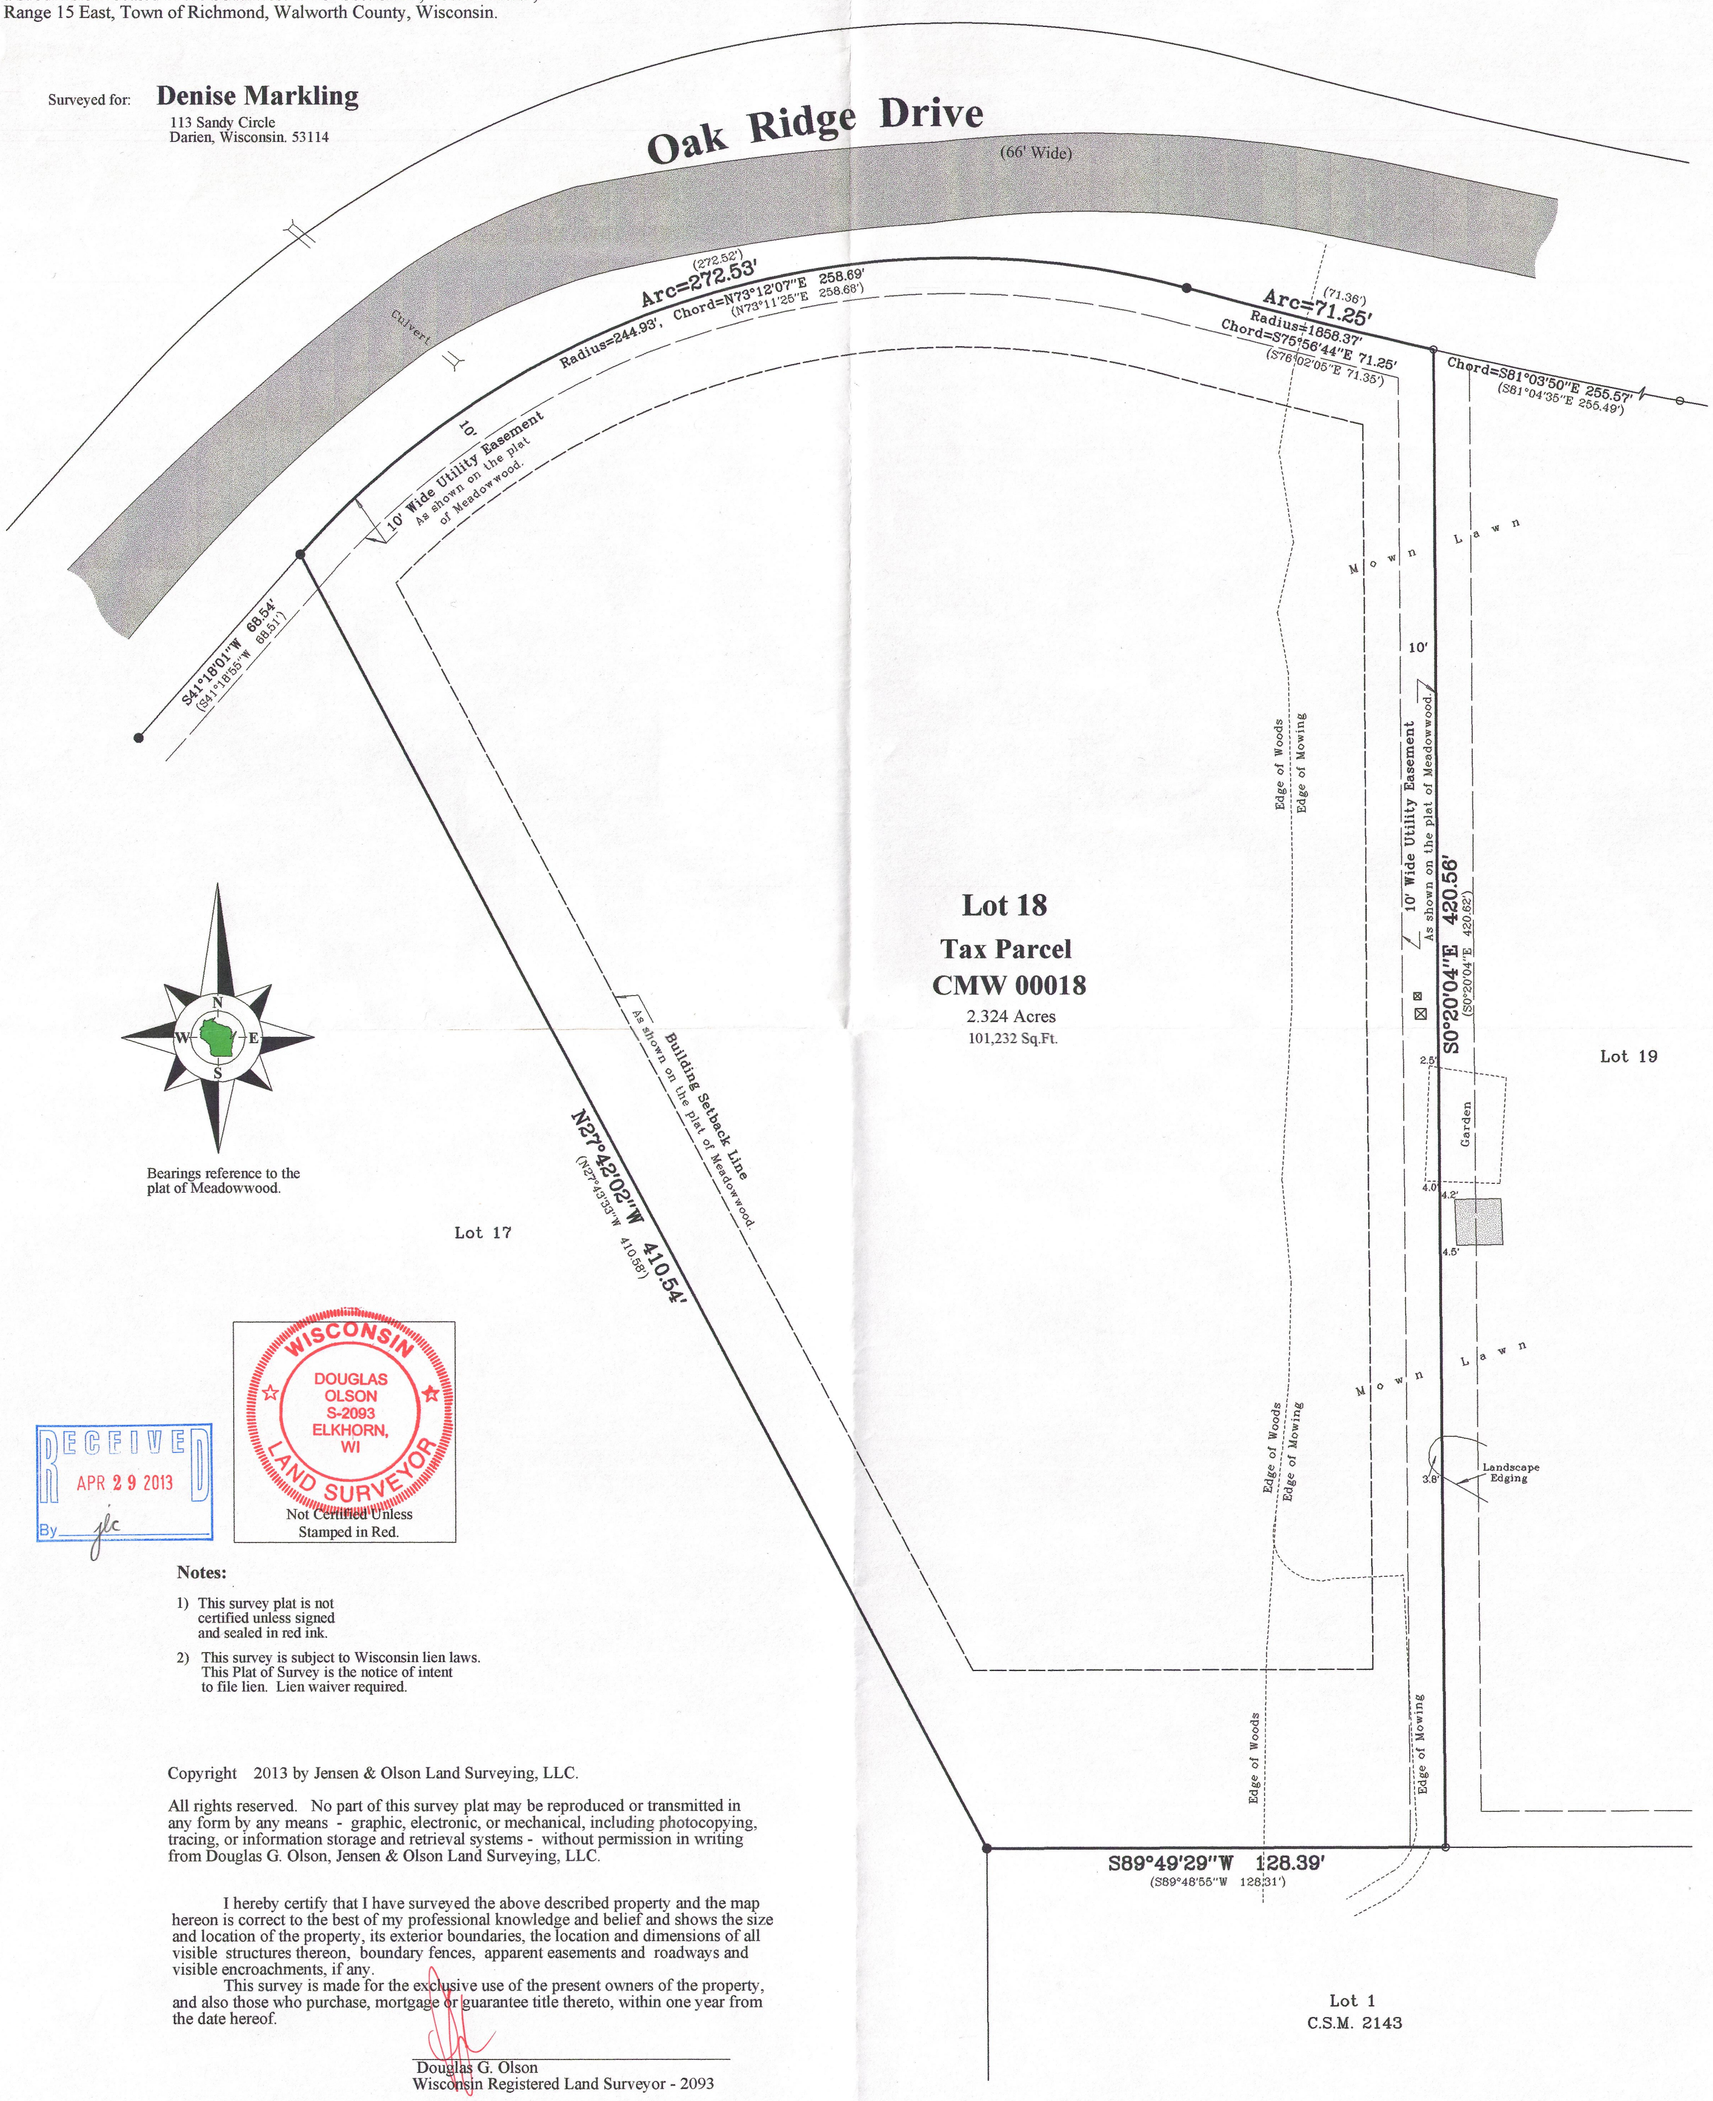

Bearings reference to the plat of Meadowwood.

RECEIVED
APR 29 2013
By jlc

WISCONSIN
DOUGLAS OLSON
S-2093
ELKHORN, WI
LAND SURVEYOR

Not Certified Unless Stamped in Red.

Notes:

1) This survey plat is not certified unless signed and sealed in red ink.

2) This survey is subject to Wisconsin lien laws. This Plat of Survey is the notice of intent to file lien. Lien waiver required.

Copyright 2013 by Jensen & Olson Land Surveying, LLC.

All rights reserved. No part of this survey plat may be reproduced or transmitted in any form by any means - graphic, electronic, or mechanical, including photocopying, tracing, or information storage and retrieval systems - without permission in writing from Douglas G. Olson, Jensen & Olson Land Surveying, LLC.

I hereby certify that I have surveyed the above described property and the map hereon is correct to the best of my professional knowledge and belief and shows the size and location of the property, its exterior boundaries, the location and dimensions of all visible structures thereon, boundary fences, apparent easements and roadways and visible encroachments, if any.

This survey is made for the exclusive use of the present owners of the property, and also those who purchase, mortgage or guarantee title thereto, within one year from the date hereof.

Douglas G. Olson
Wisconsin Registered Land Surveyor - 2093

2013.035

Sheet 1 of 1 Sheets

Drawing Name: t3nr15e-2013035-2013035Plat.scj

Job Reference Number
2013.035

Legend
- ● Found Iron Rod, 1-11/16" dia.
- ○ Found Iron Rod, 1" dia.
- ( ) Recorded Information
- ⊠ Utility Box or Pedestal
- Asphalt Surface
- Concrete Surface

Jensen & Olson Land Surveying, LLC
45 South Wisconsin Street * P.O. Box 322 * Elkhorn, Wisconsin. 53121
Telephone: (262) 723-3434 * Facsimile: (262) 723-8044
Email: jensen.olson@elknet.net

Scale in Feet
1" = 30'
0' 15' 30' 60'

Survey Date: April 29, 2013.
Revisions:

CMW 00018 315-1191