Plat of Survey

of

Lot 5 in Block C of Crystal Bowl,

a subdivision located in Government Lot 1 in the Southwest 1/4 of Section 12, Town 3 North, Range 15 East, Town of Richmond, Walworth County, Wisconsin.

Surveyed for: **Linda Szramiak**
263 Bobwhite Lane
Bloomingdale, Illinois. 60108

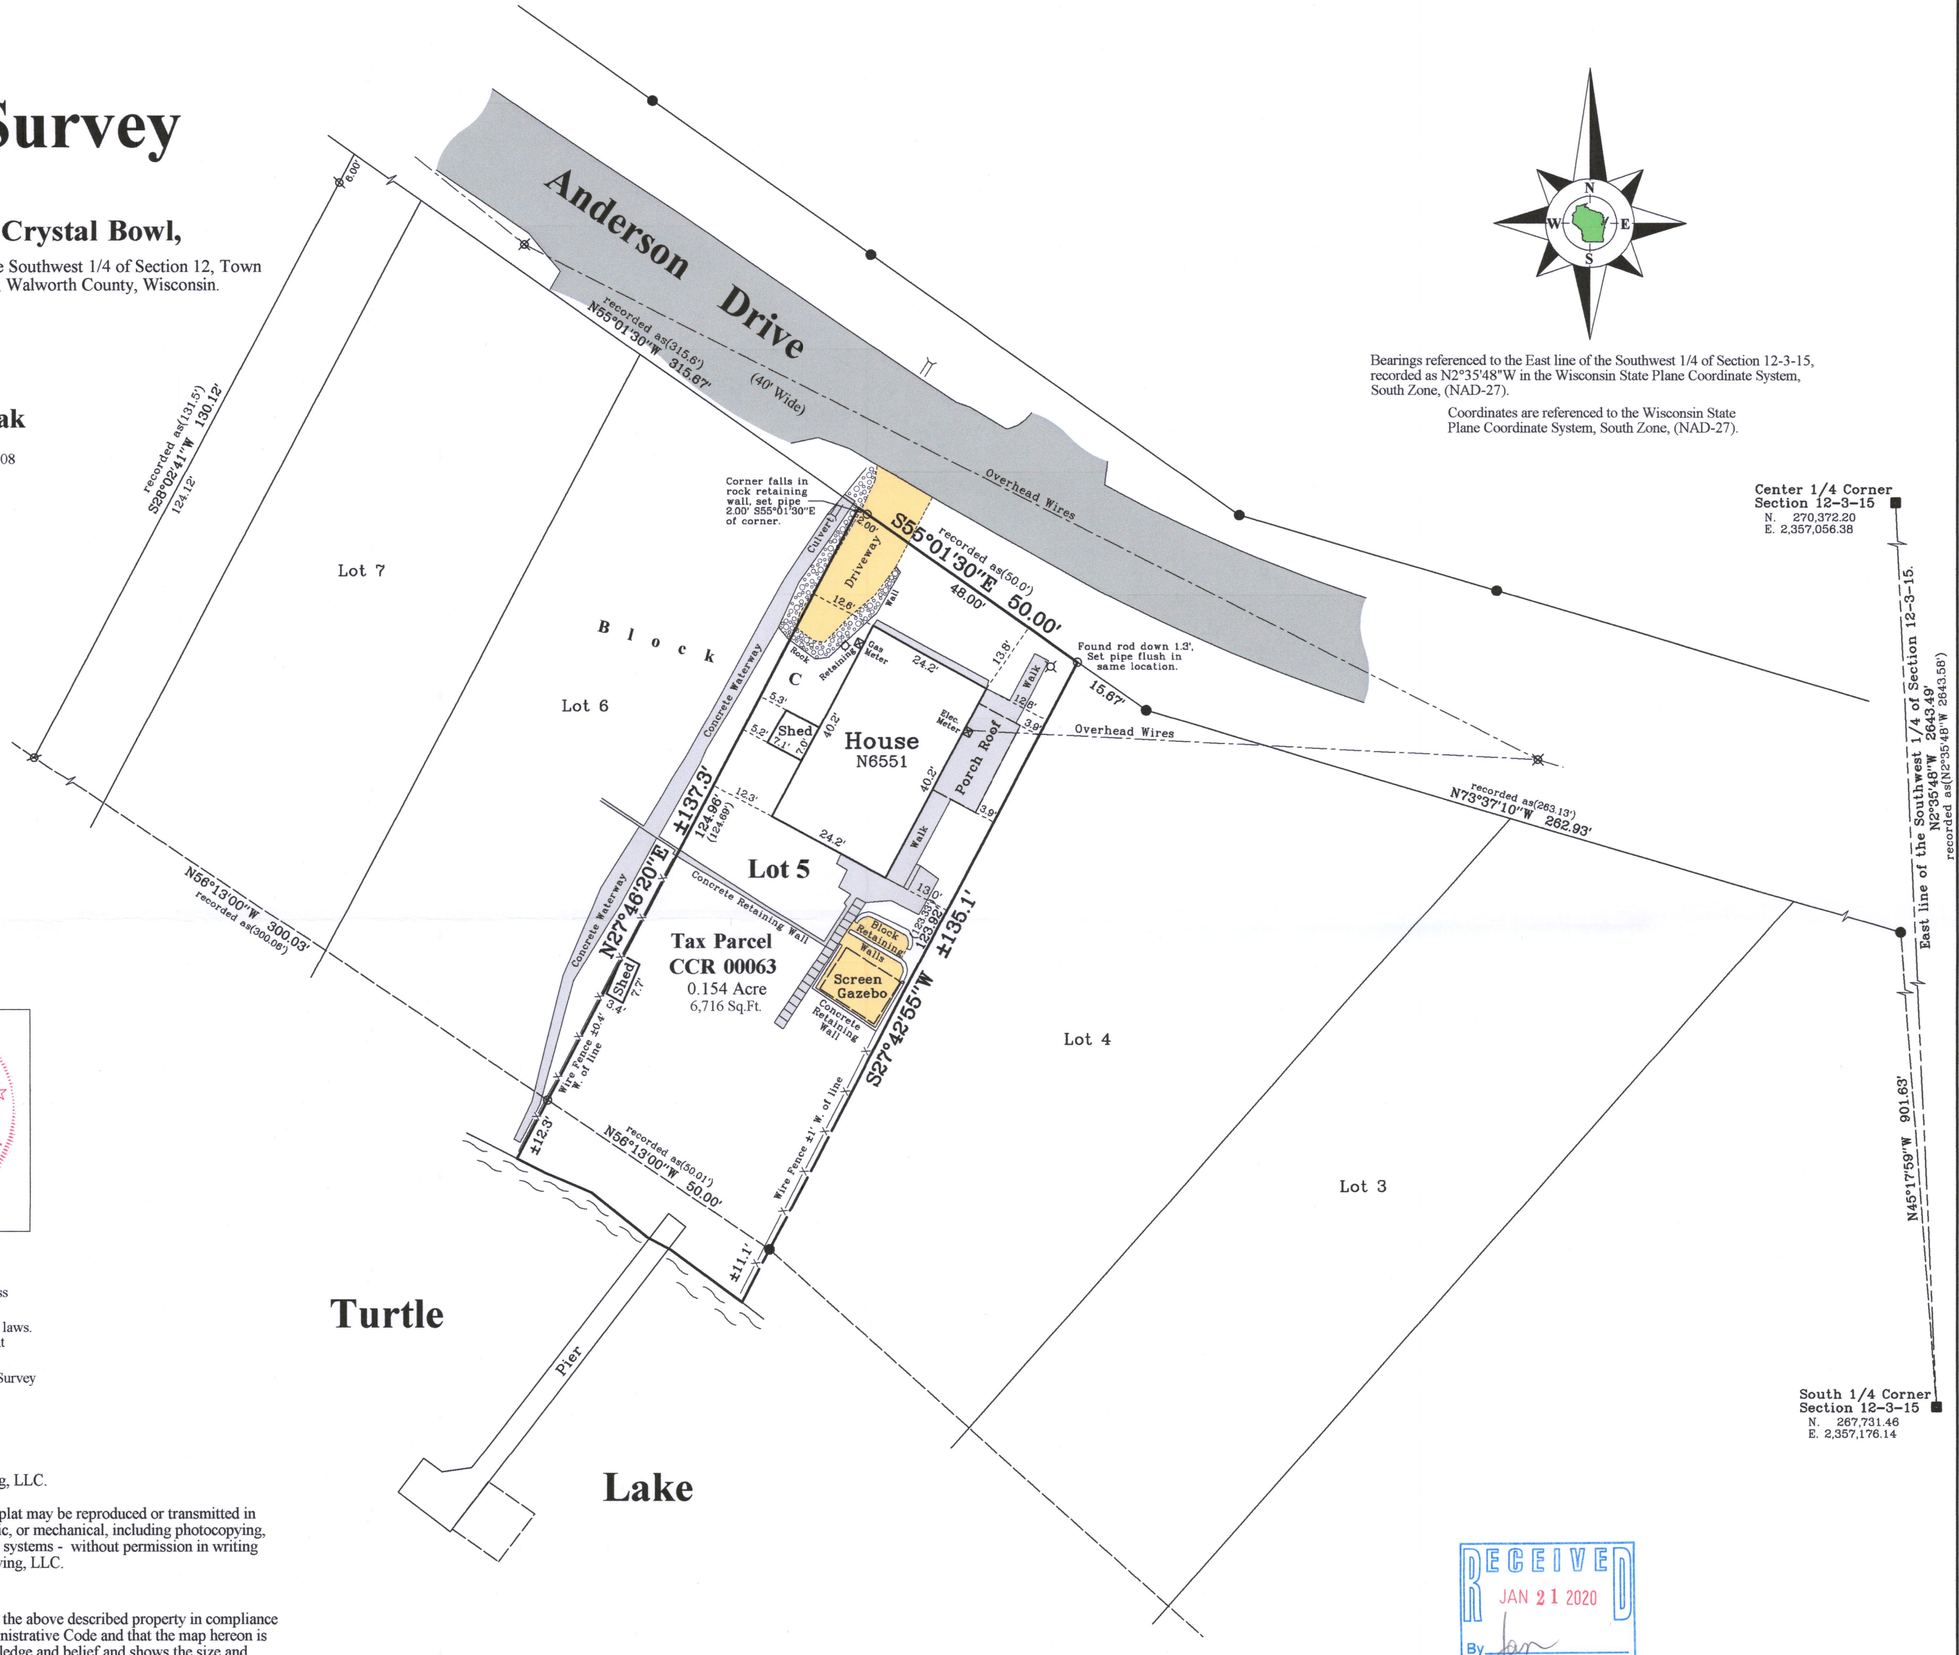

Bearings referenced to the East line of the Southwest 1/4 of Section 12-3-15, recorded as N2°35'48"W in the Wisconsin State Plane Coordinate System, South Zone, (NAD-27).

Coordinates are referenced to the Wisconsin State Plane Coordinate System, South Zone, (NAD-27).

WISCONSIN
DOUGLAS OLSON
S-2093
ELKHORN, WI
LAND SURVEYOR
Not Certified Unless Stamped in Red.

Notes:

1) This Plat of Survey is not certified unless signed and sealed in red ink.
2) This survey is subject to Wisconsin lien laws. This Plat of Survey is the notice of intent to file lien. Lien waiver required.
3) The Survey Date shown on this Plat of Survey is the completion date of the field work.

Copyright ©2019 by Olson Land Surveying, LLC.

All rights reserved. No part of this survey plat may be reproduced or transmitted in any form by any means - graphic, electronic, or mechanical, including photocopying, tracing, or information storage and retrieval systems - without permission in writing from Douglas G. Olson, Olson Land Surveying, LLC.

I hereby certify that I have surveyed the above described property in compliance with Chapter A-E 7 of the Wisconsin Administrative Code and that the map hereon is correct to the best of my professional knowledge and belief and shows the size and location of the property, its exterior boundaries, the location and dimensions of all visible structures thereon, boundary fences, apparent easements and roadways and visible encroachments, if any.

This survey is made for the exclusive use of the present owners of the property, and also those who purchase, mortgage or guarantee title thereto, within one year from the date hereof.

Douglas G. Olson
Wisconsin Professional Land Surveyor - 2093

RECEIVED
JAN 21 2020
By jan

CCR-63 315-1366

Survey Date: August 27, 2019.
Revisions:

Scale in Feet
1" = 20'
0' 10' 20' 40' 60'

OLSON
LAND SURVEYING, LLC
Rural | Residential | Commercial
45 South Wisconsin Street | P.O. Box 322
Elkhorn, Wisconsin. 53121
Telephone: (262) 723-3434
Facsimile: (262) 723-8044
Email: doug@olsonsurveying.com
Website: www.olsonsurveying.com

Legend of Symbols & Abbreviations

- Found County Section Corner
- Found Iron Pipe
- Found Iron Rod
- Set Iron Pipe 1" dia
- Recorded Information
- Utility Pole
- Utility Pedestal
- Lamp
- Asphalt Surface
- Concrete Surface
- Gravel/Stone Surface

N North
S South
E East
W West
In Bearings
Decimals
' Minutes
" Seconds
In Distances
' Feet
" Inches

Sheet 1 of 1 Sheets

Drawing Name:

Job Reference Number
2019.105

2019.105