
GEORGE T. DUNHAM
SURVEYING & SUBDIVIDING
DELAVAN, WISCONSIN

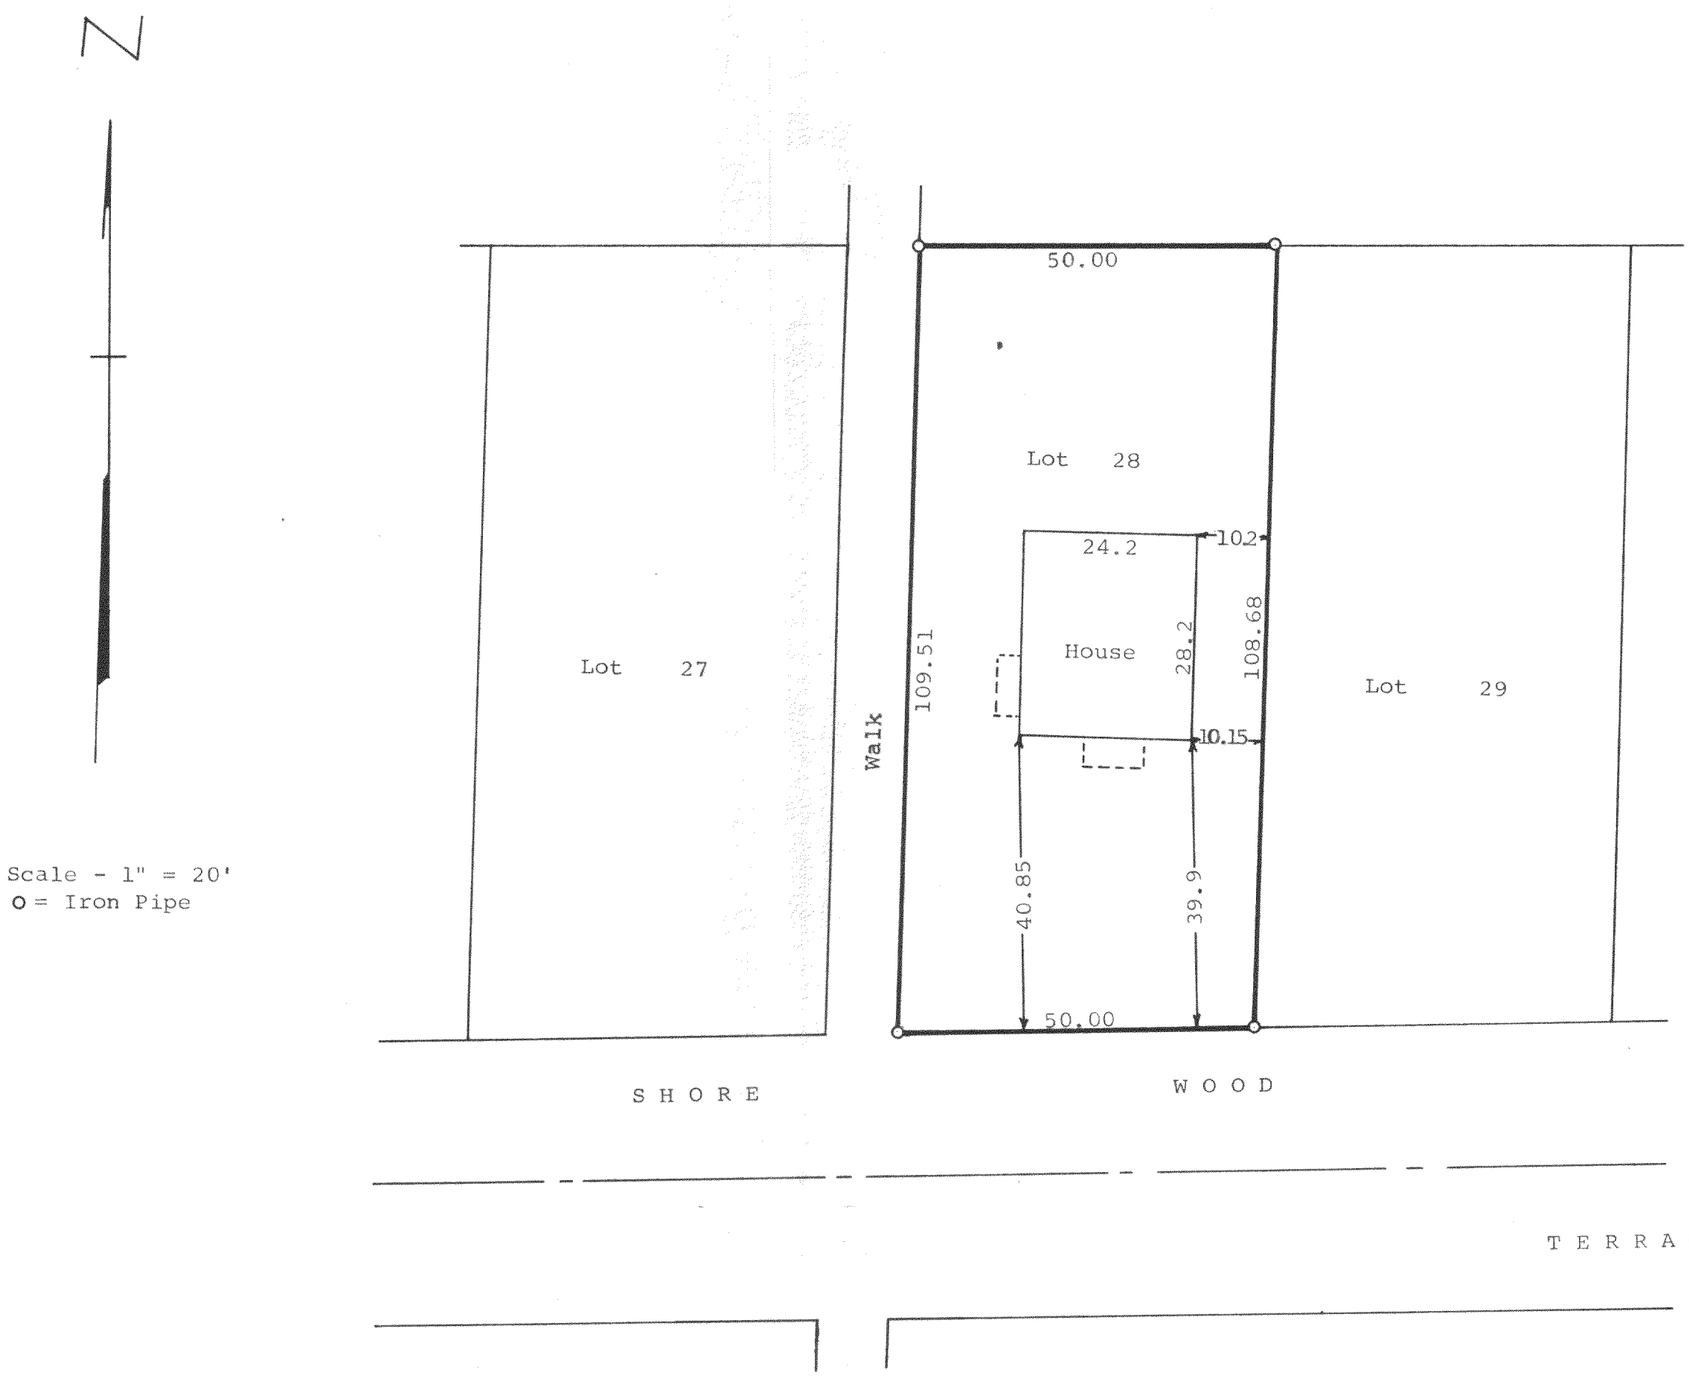

Scale - 1" = 20'
O = Iron Pipe

STATE OF WISCONSIN)
WALWORTH COUNTY,) SS

I, George T. Dunham, Surveyor, certify that I have surveyed the property described as follows,

Lot 28, Block "A" of Crystal Bowl, a subdivision located in Sections 12 and 13, T 3 N, R 15 E, Walworth County, Wisconsin.

and the above plat is an accurate survey and a true representation thereof and correctly shows the exterior boundary lines and location of buildings on said property and the correct measurements thereof.

October 12, 1967

George T. Dunham

George T. Dunham, Surveyor

CCR-15

CCR-15

K & E 10-7155 250-8-66

315-16