
DUNHAM SURVEYING, S. C.

SURVEYING & SUBDIVIDING

DELAVAN, WISCONSIN 53115

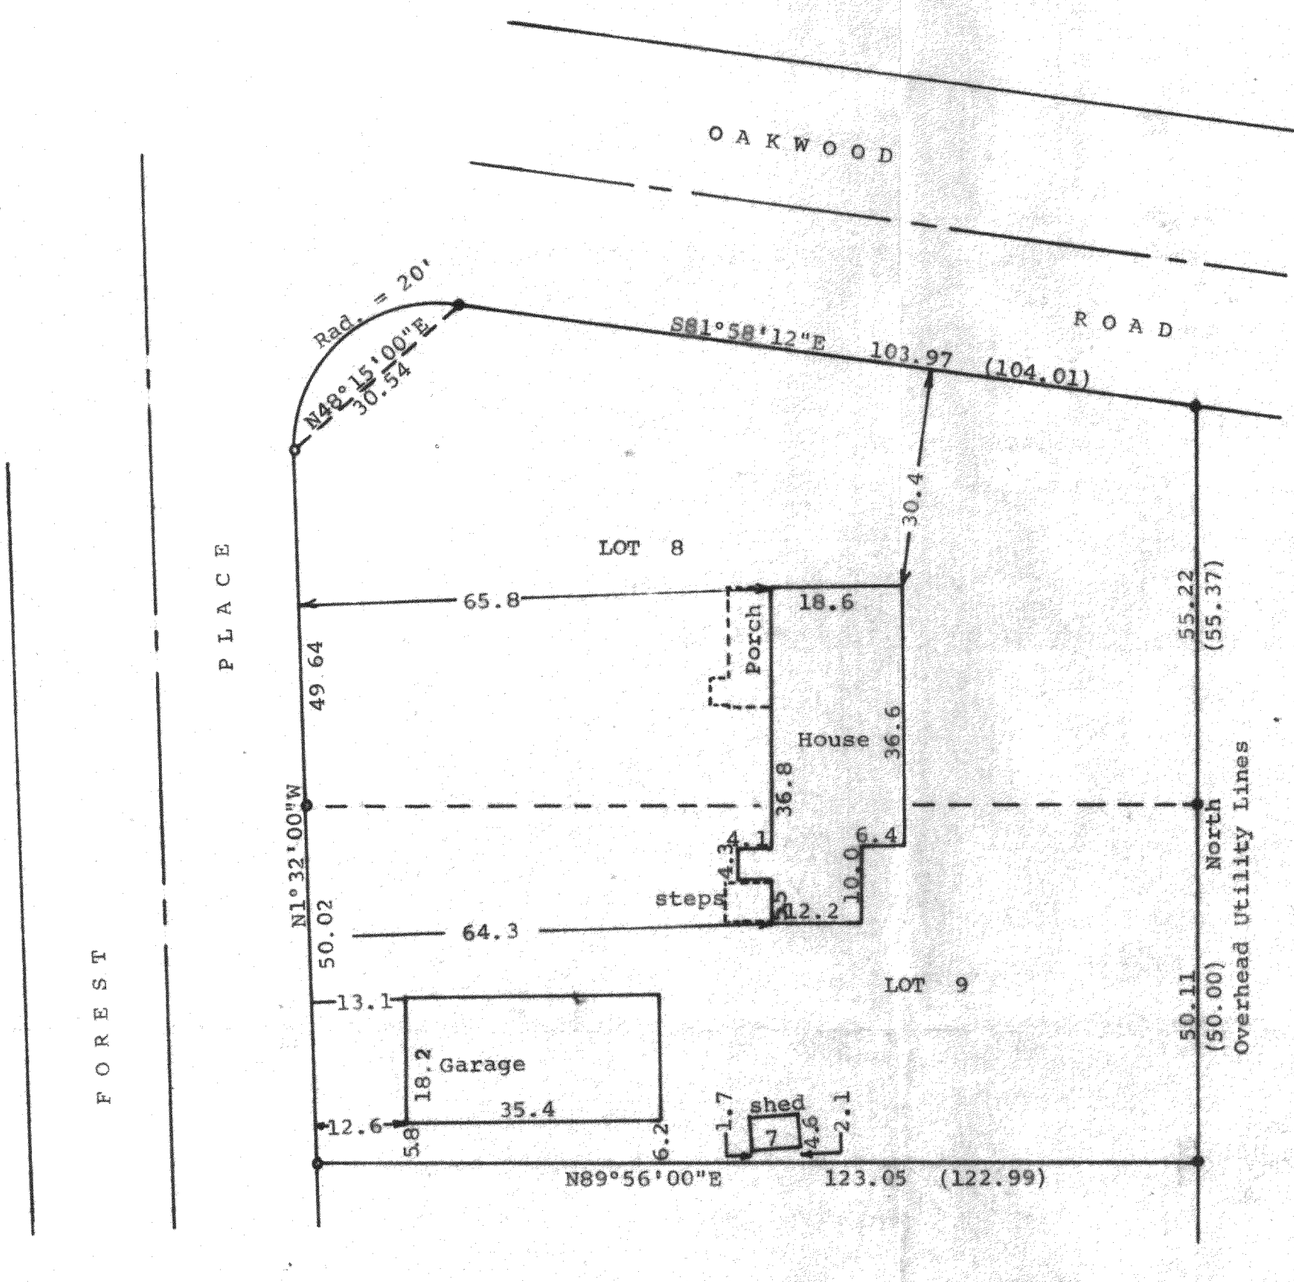

Scale - 1" = 20'

● = Iron Rod Found

o = Iron Rod Found and Pipe reset

(0.00) = Recorded Distance

Owner: Gordon Delaney
R. 1
Delavan, WI 53115

Bearings referenced to the east line of Lots 8 & 9 with the assumed bearing of North

STATE OF WISCONSIN)
COUNTY OF WALWORTH) SS

I, George T. Dunham, Surveyor, certify that I have surveyed the property described as follows:

Lots 8 and 9 in Block "E" of Crystal Bowl Subdivision located in Sections 12 and 13, T 3 N, R 15 E, Walworth County, Wisconsin,

and that the above map is a true representation thereof and shows the size and location of the property, its exterior boundaries, the location of all visible structures and dimensions of all principal buildings thereon, boundary fences, apparent easements, roadways and visible encroachments, if any.

This survey is made for the use of the present owners of the property, and also those who purchase, mortgage, or guarantee the title thereto within one (1) year from date hereof.

April 28, 1982

George T. Dunham

George T. Dunham, Surveyor

WISCONSIN
GEORGE T. DUNHAM
DELAVAN, WIS.
LAND SURVEYOR

CCR-92

K & E 10-9155

Lots 8 & 9 Blk "E" Crystal Bowl Subd. Secs. 12 & 13-T3-15

315-187-D