
KOLB LAND CONSULTING, INC.

LAND SURVEYING · SUBDIVIDING · LAND PLANNING

LAKE GENEVA, WISCONSIN 53147 WHITEWATER, WISCONSIN 53190

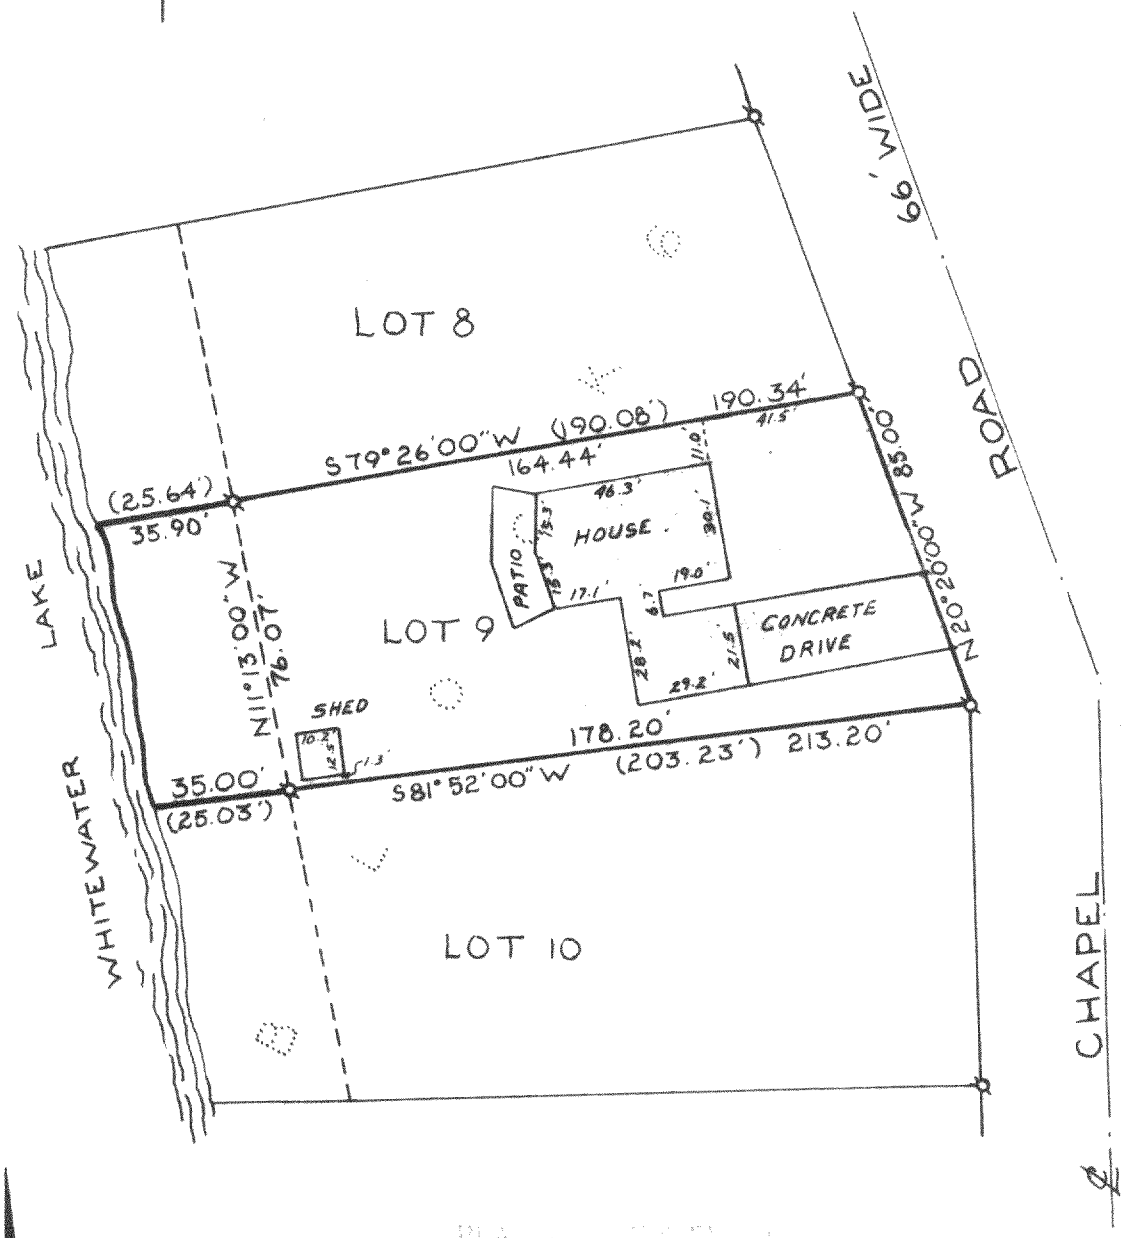

N

SCALE: 1" = 50'

LEGEND

ø - IRON PIPE FOUND

( ) - AS PLATTED

PLAT OF SURVEY

Lot 9, Block 6, [illegible]

Located in the Northeast 1/4 of the Southeast 1/4 of Section 36, T3N, R15E, Walworth County, Wisconsin.

Bearings are referenced to the East line of the Southeast 1/4 of Section 36, T3N, R15E, which is assumed to bear S00°08'00"E.

Owner's Name: Alfred E. Burton
[illegible]

REVISED AUG. 25, 1983

Harold H. Kolb

HAROLD H. KOLB
WISCONSIN SURVEYOR, S-187

I, [illegible], do hereby certify that I have surveyed the above described property, to the best of my knowledge and that the plat hereon is a correct representation thereof.

WISCONSIN REGISTERED LAND SURVEYOR, S-1279

DATE June 1, 1979

315-200

CCH--00014A

3-15-12