EAST 13'

POINT 694 FEET SOUTH OF THE SOUTH ¼ SECTION CORNER OF THE SOUTHWEST ¼ OF SECTION 35, T4N R15E.

98.58'

113.52'

78.88'

107.92'

N.-S. ⅛TH LINE

116.51'

795.98'

SOUTH

133.18'

157.37'

MIDDLE ⅛ SEC. COR. OF THE NW¼ OF SECTION 2 T3N R15E

182.32'

WHITEWATER LAKE

PRESENT SHORE LINE

740'±

69'±

411.14'

N 19°-11'-30" E

162.20'

176.94'

6.4 ACRES, MORE OR LESS

351.96'

S 88°-57' W

658.69'

306.73'

E.-W. ⅛TH LINE

- ● – CONCRETE MONUMENT FOUND
- ⊗ – IRON PIPE FOUND
- ○ – IRON PIPE SET

WISCONSIN
LLOYD L JENSEN
S-211
ELKHORN, WIS.
LAND SURVEYOR

PLAT OF SURVEY

OF

A PARCEL OF LAND LOCATED IN THE NW¼ OF THE NW¼ OF SECTION 2, T3N R15E, WALWORTH COUNTY, WISCONSIN.

R-2-3J


Lloyd L Jensen
SURVEYOR

SCALE 1" = 60'

DATE SEPT 1971

315-21.1

GEORGE T. DUNHAM
SURVEYING & SUBDIVIDING
DELAVAN, WISCONSIN

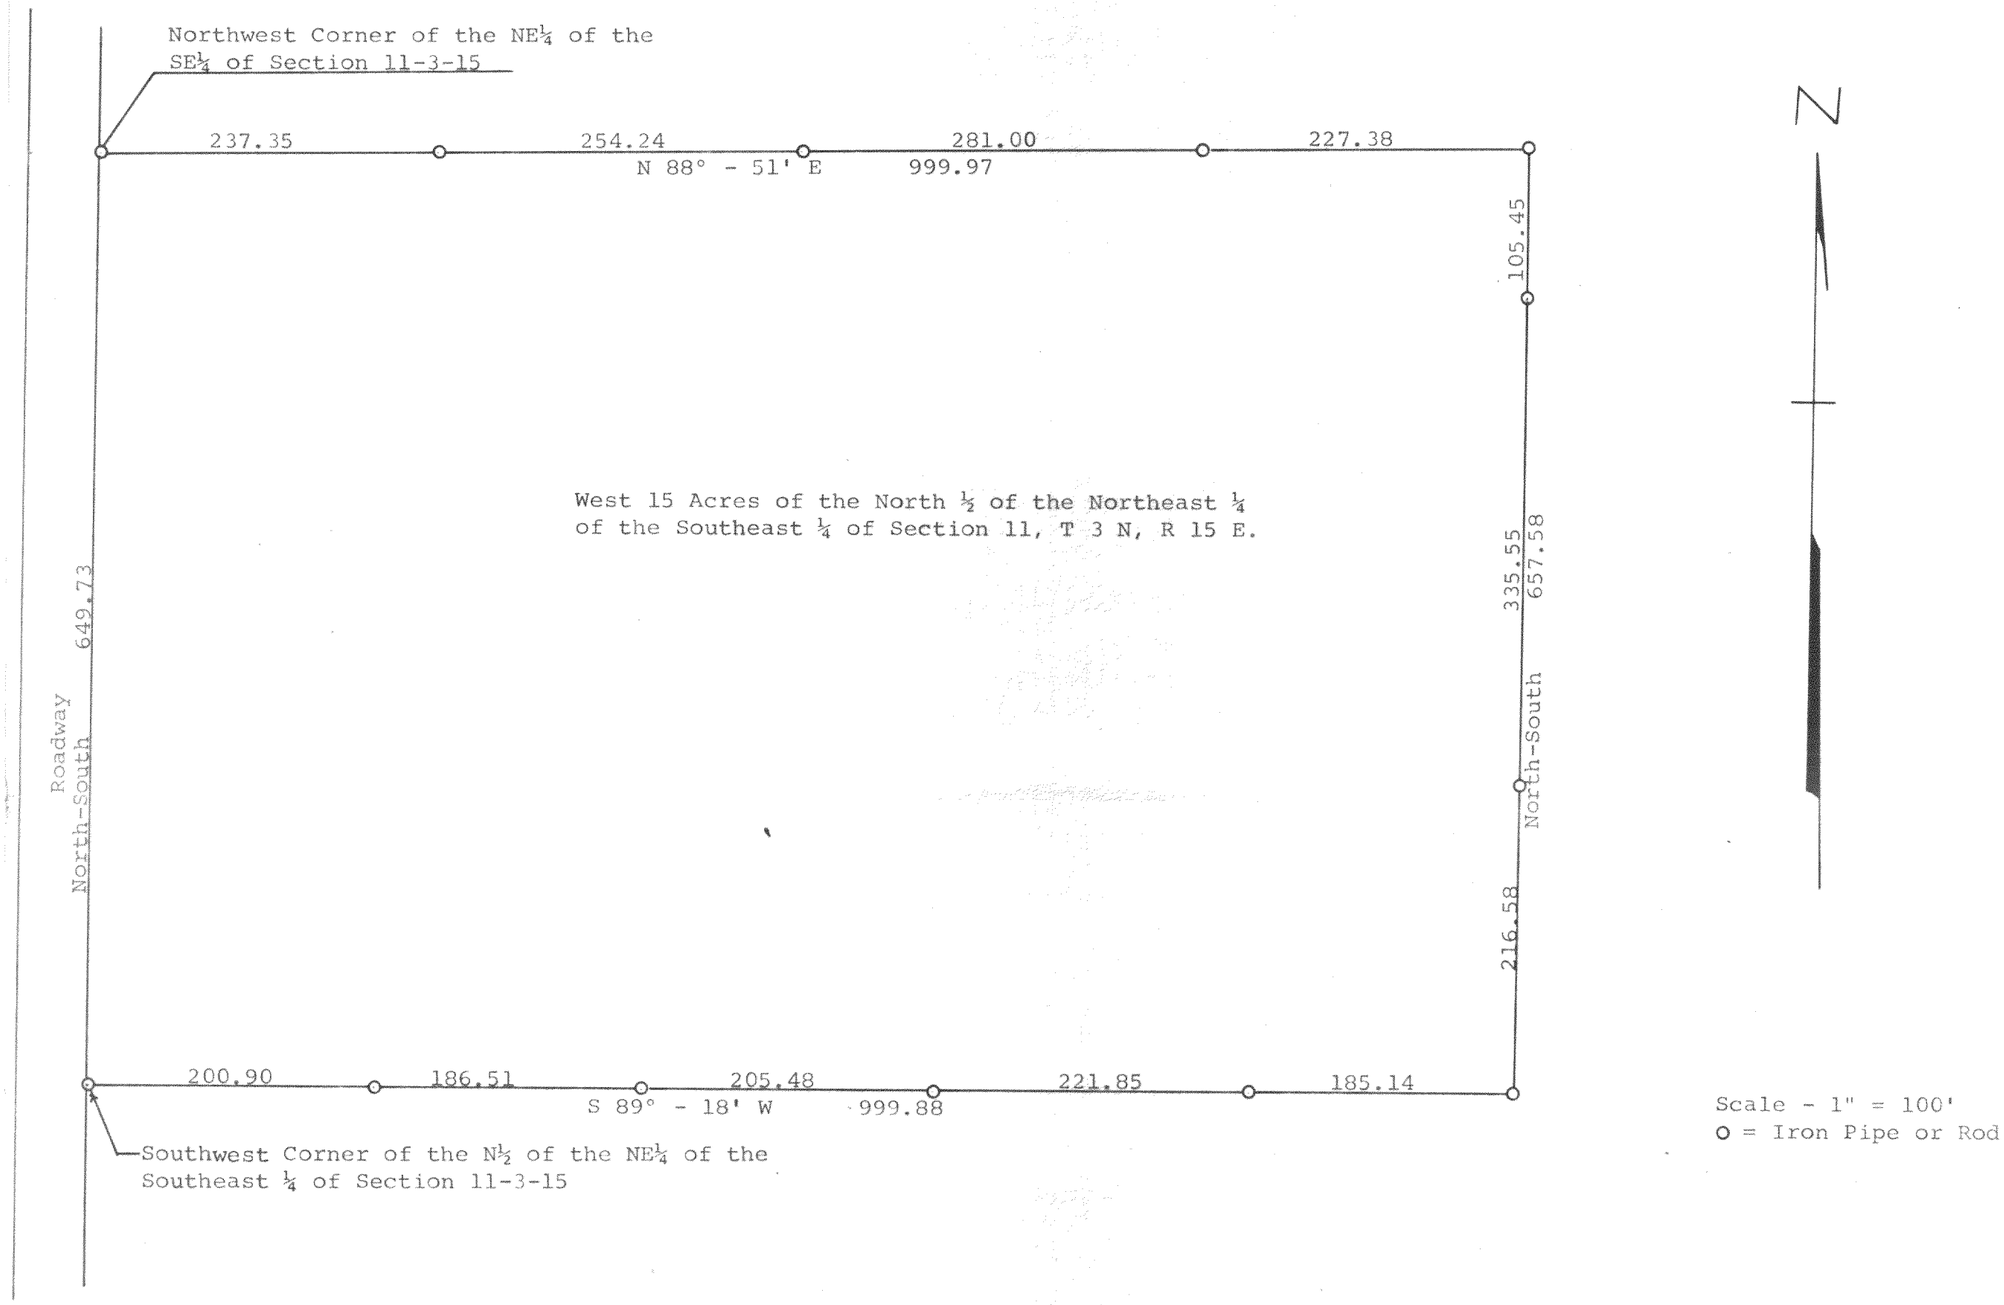

Plat of survey of a parcel of land described as follows, to-wit:
The West 15.00 acres of the North ½ of the Northeast ¼ of the Southeast ¼ of Section 11, T 3 N, R 15 E, Walworth County, Wisconsin.
or may also be described as follows;:
A parcel of land located in the North ½ of the Northeast ¼ of the Southeast ¼ of Section 11, T 3 N, R 15 E, Walworth County, Wisconsin, described as follows, to-wit: Beginning at the northwest corner of said Northeast ¼ of the Southeast ¼; thence N 88° - 51' E along the north line of said Northeast ¼ of the Southeast ¼, 999.97 feet; thence South parallel with the west line of said Northeast ¼ of the Southeast ¼, 657.58 feet to the south line of said North ½ of the Northeast ¼ of the Southeast ¼; thence S 89° - 18' W along said south line 999.88 feet to the southwest corner of said North ½; thence North along the west line of said Northeast ¼ of the Southeast ¼, 649.73 feet to the place of beginning containing 15.00 acres of land more or less.
July 24, 1968

Part of R-12-11

George T. Dunham, Surveyor

CR11-10A

315-22