
DUNHAM SURVEYING, S.C.
SURVEYING & SUBDIVIDING
DELAVAN, WISCONSIN 53115

RECEIVED
AUG 19 1986



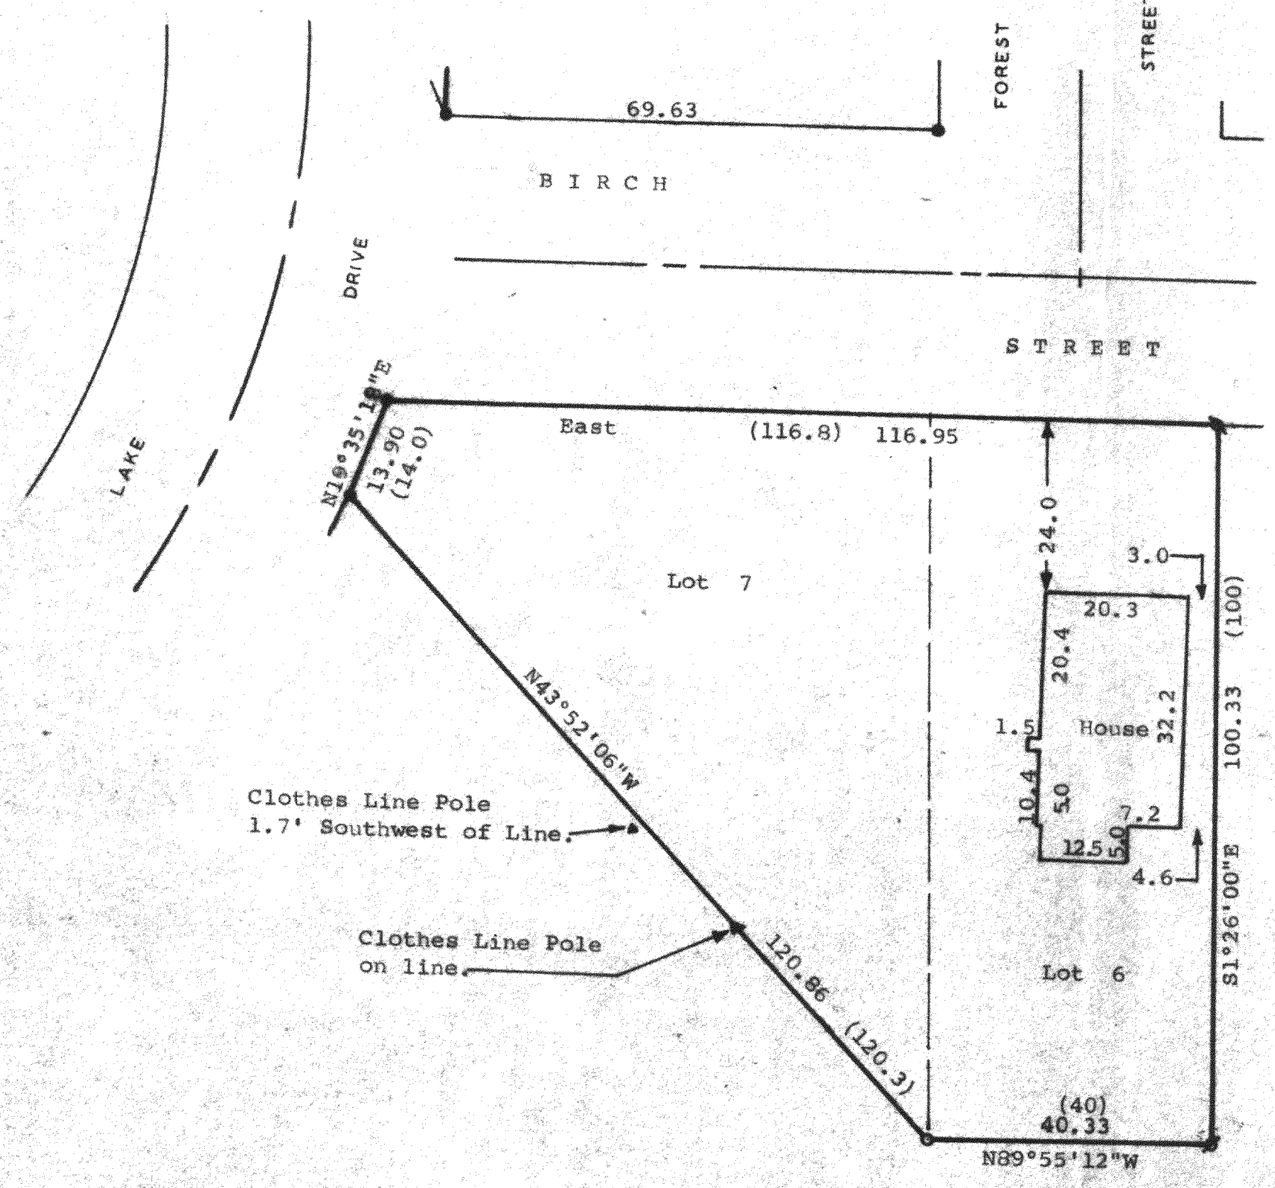

Scale - 1" = 20'
● = Concrete Monument Found
○ = 1" Dia. Iron Pipe Found
◥ = 3/4" Dia. Iron Pipe Found
▰ = ½"x24" Iron Pipe Set
▲ = Clothes Line Pole
(00) = Recorded Distance

Bearings are referenced to the South line of Birch Street, assumed bearing of East-West.

Survey Ordered By: G. W. Burke
66 East Walworth Avenue
Delavan, Wisconsin 53115

STATE OF WISCONSIN)
COUNTY OF WALWORTH) SS

I, George T. Dunham, Surveyor, certify that I have surveyed the property described as follows,

Lots 6 and 7, Block 4 of Forest Beach, a subdivision located in the Northwest ¼ of Section 9, T3N, R15E, Walworth County, Wisconsin, and that the above map is a true representation thereof and shows the size and location of the property, its exterior boundaries, the location of all visible structures and dimensions of all principal buildings thereon, boundary fences, apparent easements, roadways and visible encroachments, if any, and that I have surveyed the property hereon described according to the official records, to the best of my knowledge and belief.

July 31, 1986.

George T. Dunham, Surveyor

WISCONSIN
GEORGE T. DUNHAM
S-306
DELAVAN WIS.
LAND SURVEYOR

CFB-00022

315-221