
D. D. COOPER & CO., INC.
Daniel D. Cooper
Rt. 4 Box 508B
Elkhorn, WI 53121

RECEIVED
APR 9 1987

Plat of Survey of Lot 6, Block 6 Chapel Hills Subdivision, being located in the Town of Richmond, Walworth County, Wisconsin

Bearing reference: Westerly Line of Chapel Drive assumed to bear N12 53'W as recorded

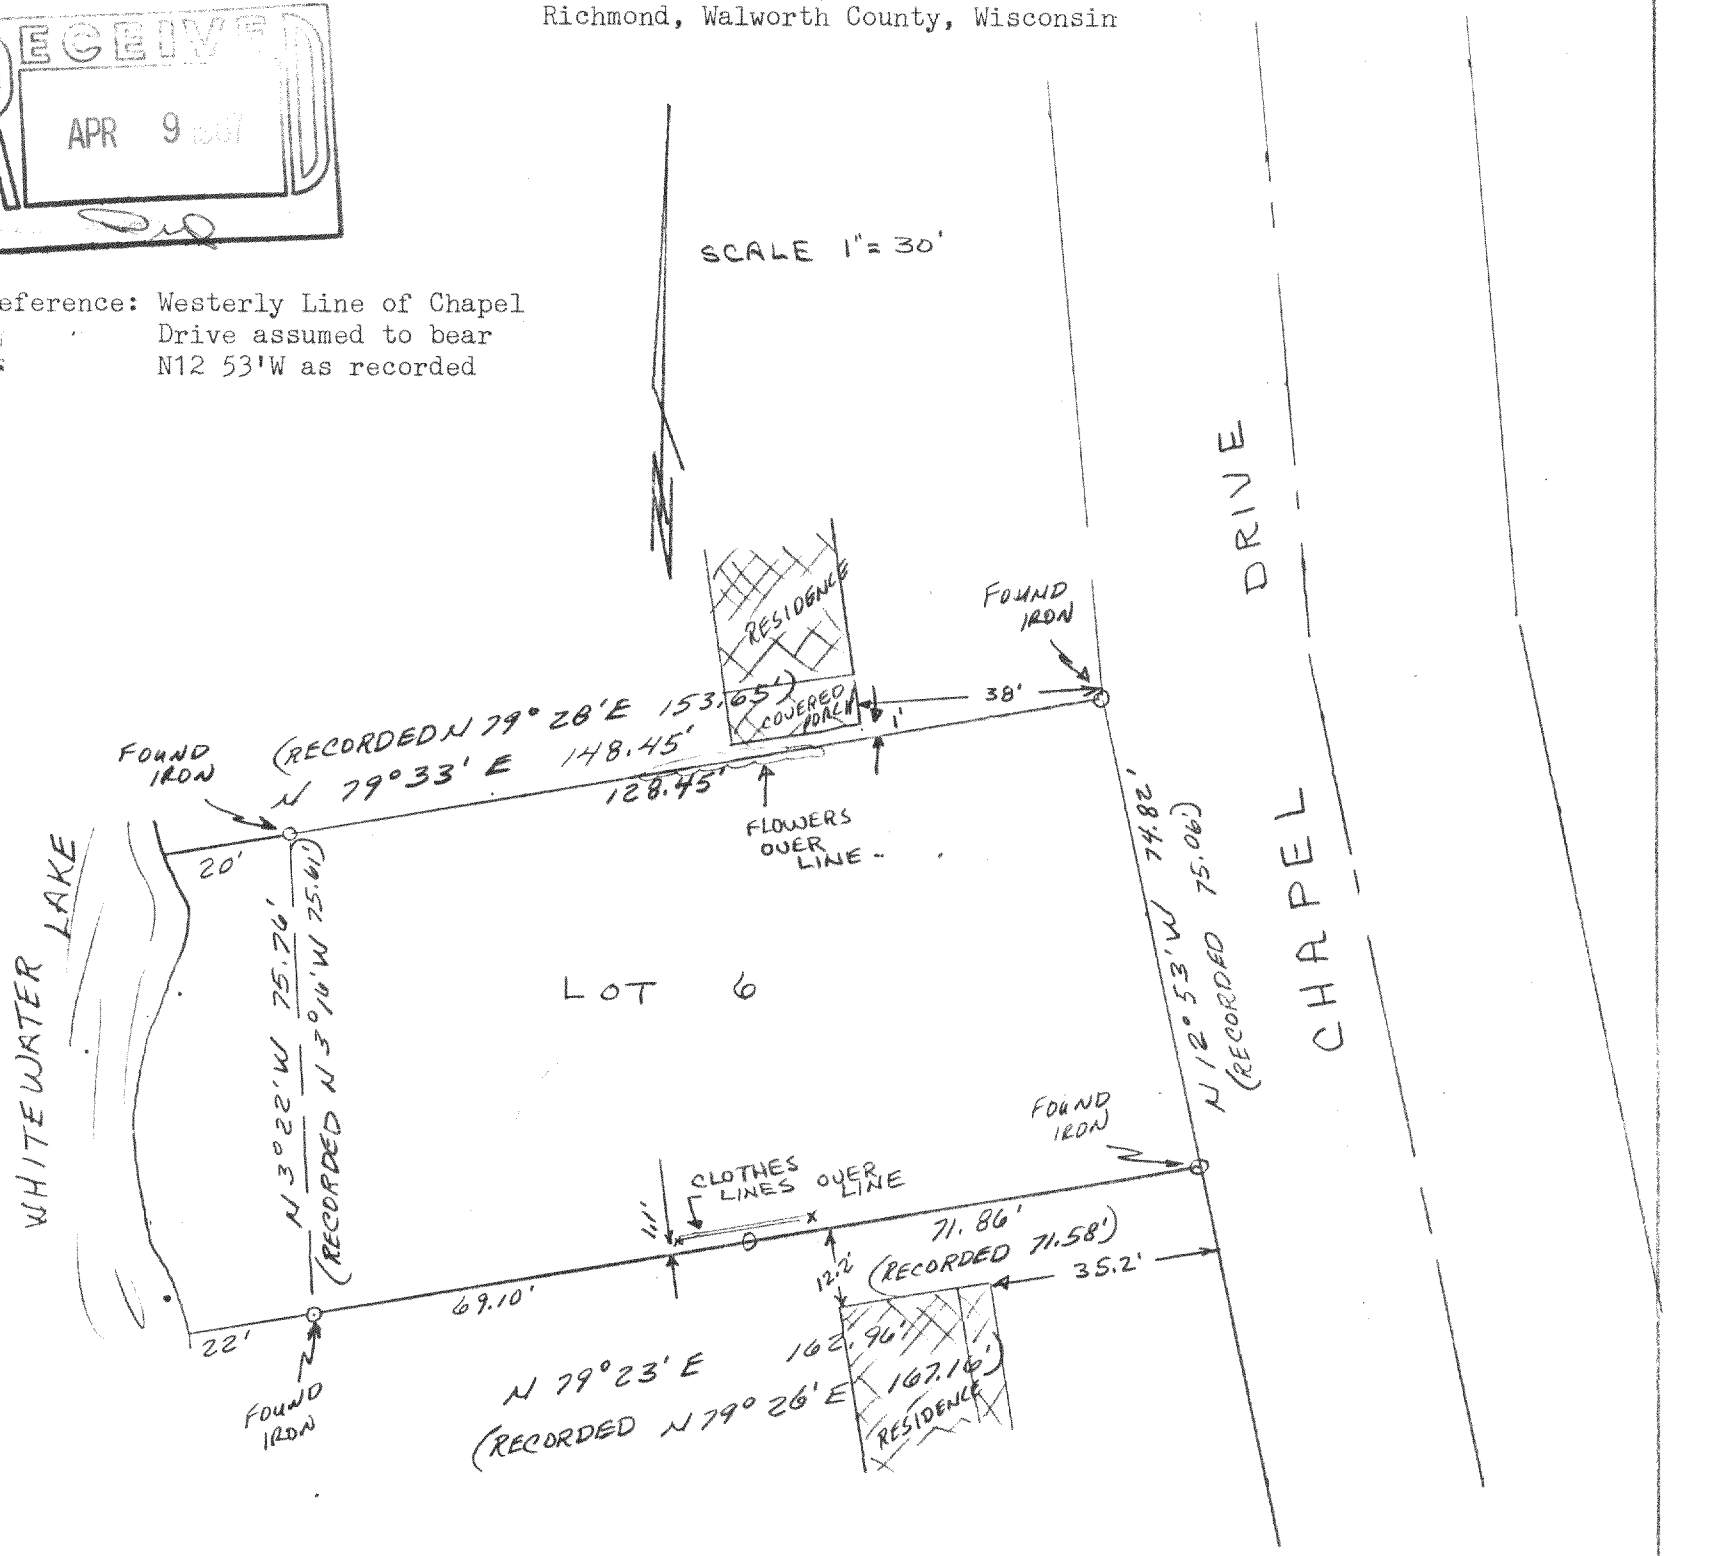

Survey ordered by Rummel-Devitt & Ass.
Whitewater WI

I hereby certify that I have surveyed the property described hereon and that the above map is a true and accurate representation thereof to the best of my professional knowledge and belief.

Dated this 23 day of Mar. ,1987

Daniel D. Cooper, RLS No S-1464

WISCONSIN
DANIEL D. COOPER
S-1464
WIS.
LAND SURVEYOR

CCH-13E

Drawing No. 3069-S-6-7

315-228