



DUNHAM SURVEYING, S.C.
SURVEYING & SUBDIVIDING
DELAVER, WISCONSIN 53115

N

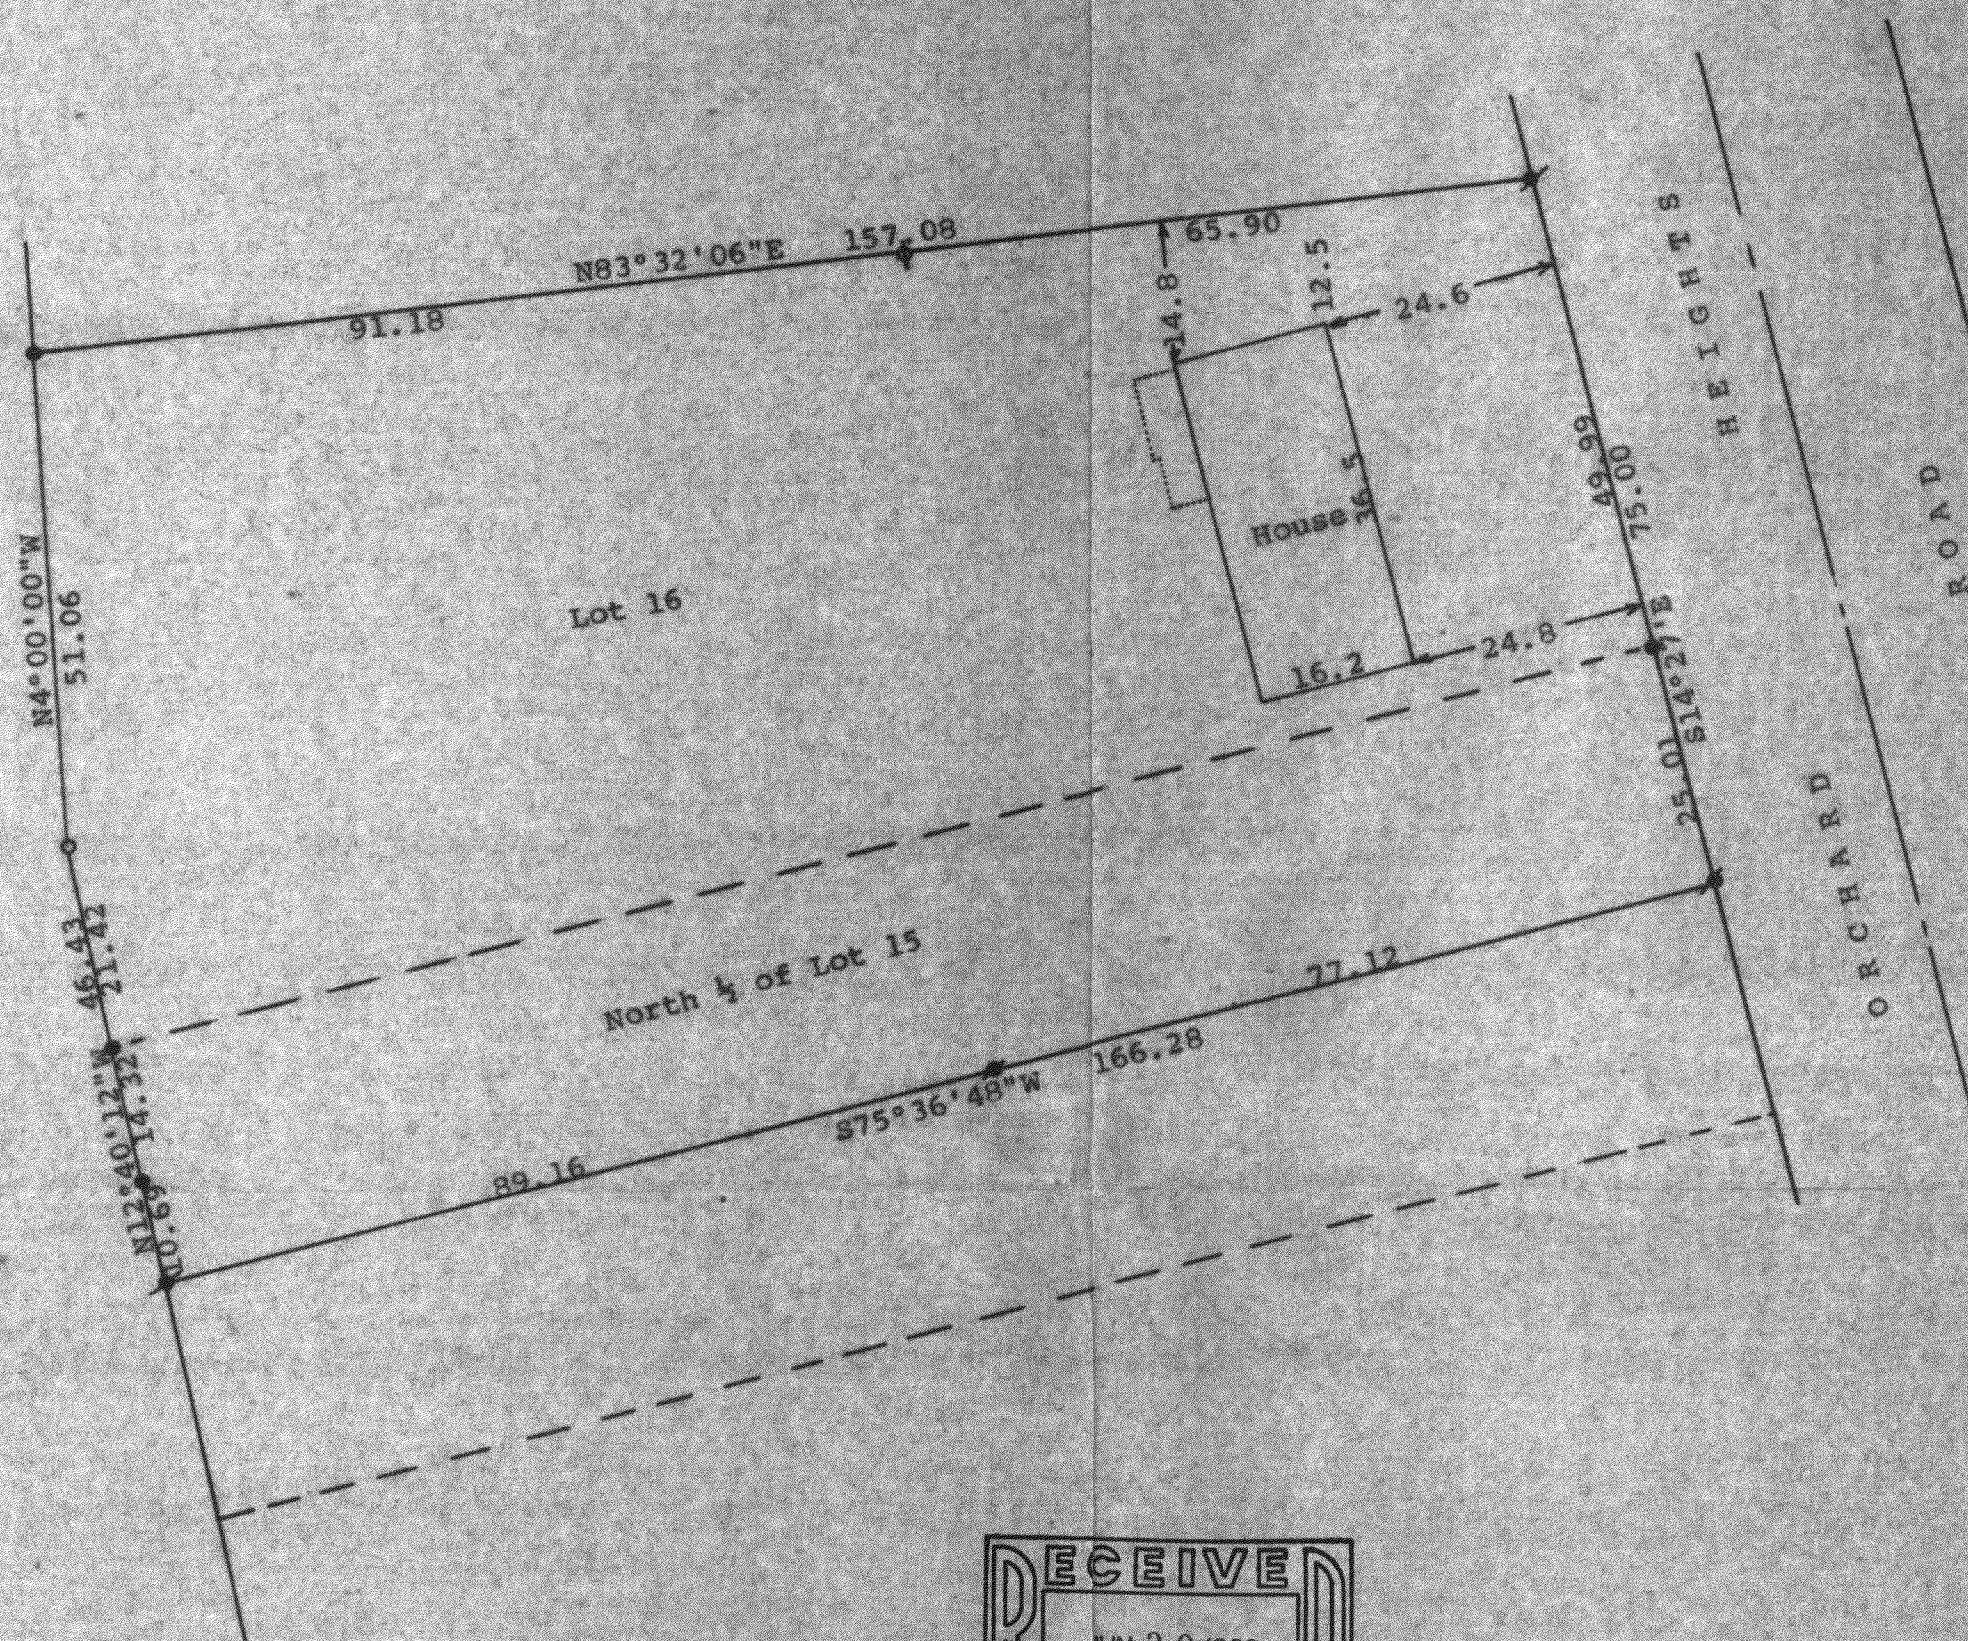

Scale - 1" = 20'
● = 3/4" Iron Rod Found
⊙ = 3/4" Iron Pipe Found
⊕ = 1" X 24" Iron Pipe Set
○ = 1 1/2" X 24" Iron Pipe Set
Bearings referenced to the west
line of Lot 16 with the assumed
bearing of N4°W
Survey ordered by:
Realty World, Carmin Realtors
811 East Geneva Street
DeLavan, WI 53115

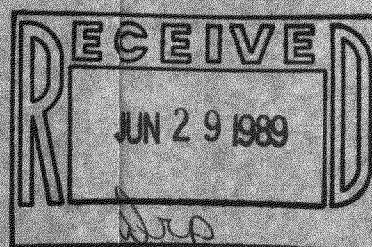

STATE OF WISCONSIN) SS
COUNTY OF WALWORTH)

I, George T. Dunham, Surveyor, certify that I have surveyed the property described as follows:
Lot 16 and the North 1/2 of Lot 15 in Block "G" of Crystal Bowl Subdivision located in Sections 12 and 13, T 3 N, R 15 E, Walworth County, Wisconsin,
and that the plat shown above is a correct representation thereof and shows the size and location of the property, its exterior boundaries, the location of all visible structures and dimensions of all principal buildings thereon, boundary fences, apparent easements, roadways and visible encroachments, if any, and that I have surveyed the property hereon described, according to the official records, to the best of my knowledge and belief.

December 22, 1988

315-263

George T. Dunham
George T. Dunham, Surveyor

