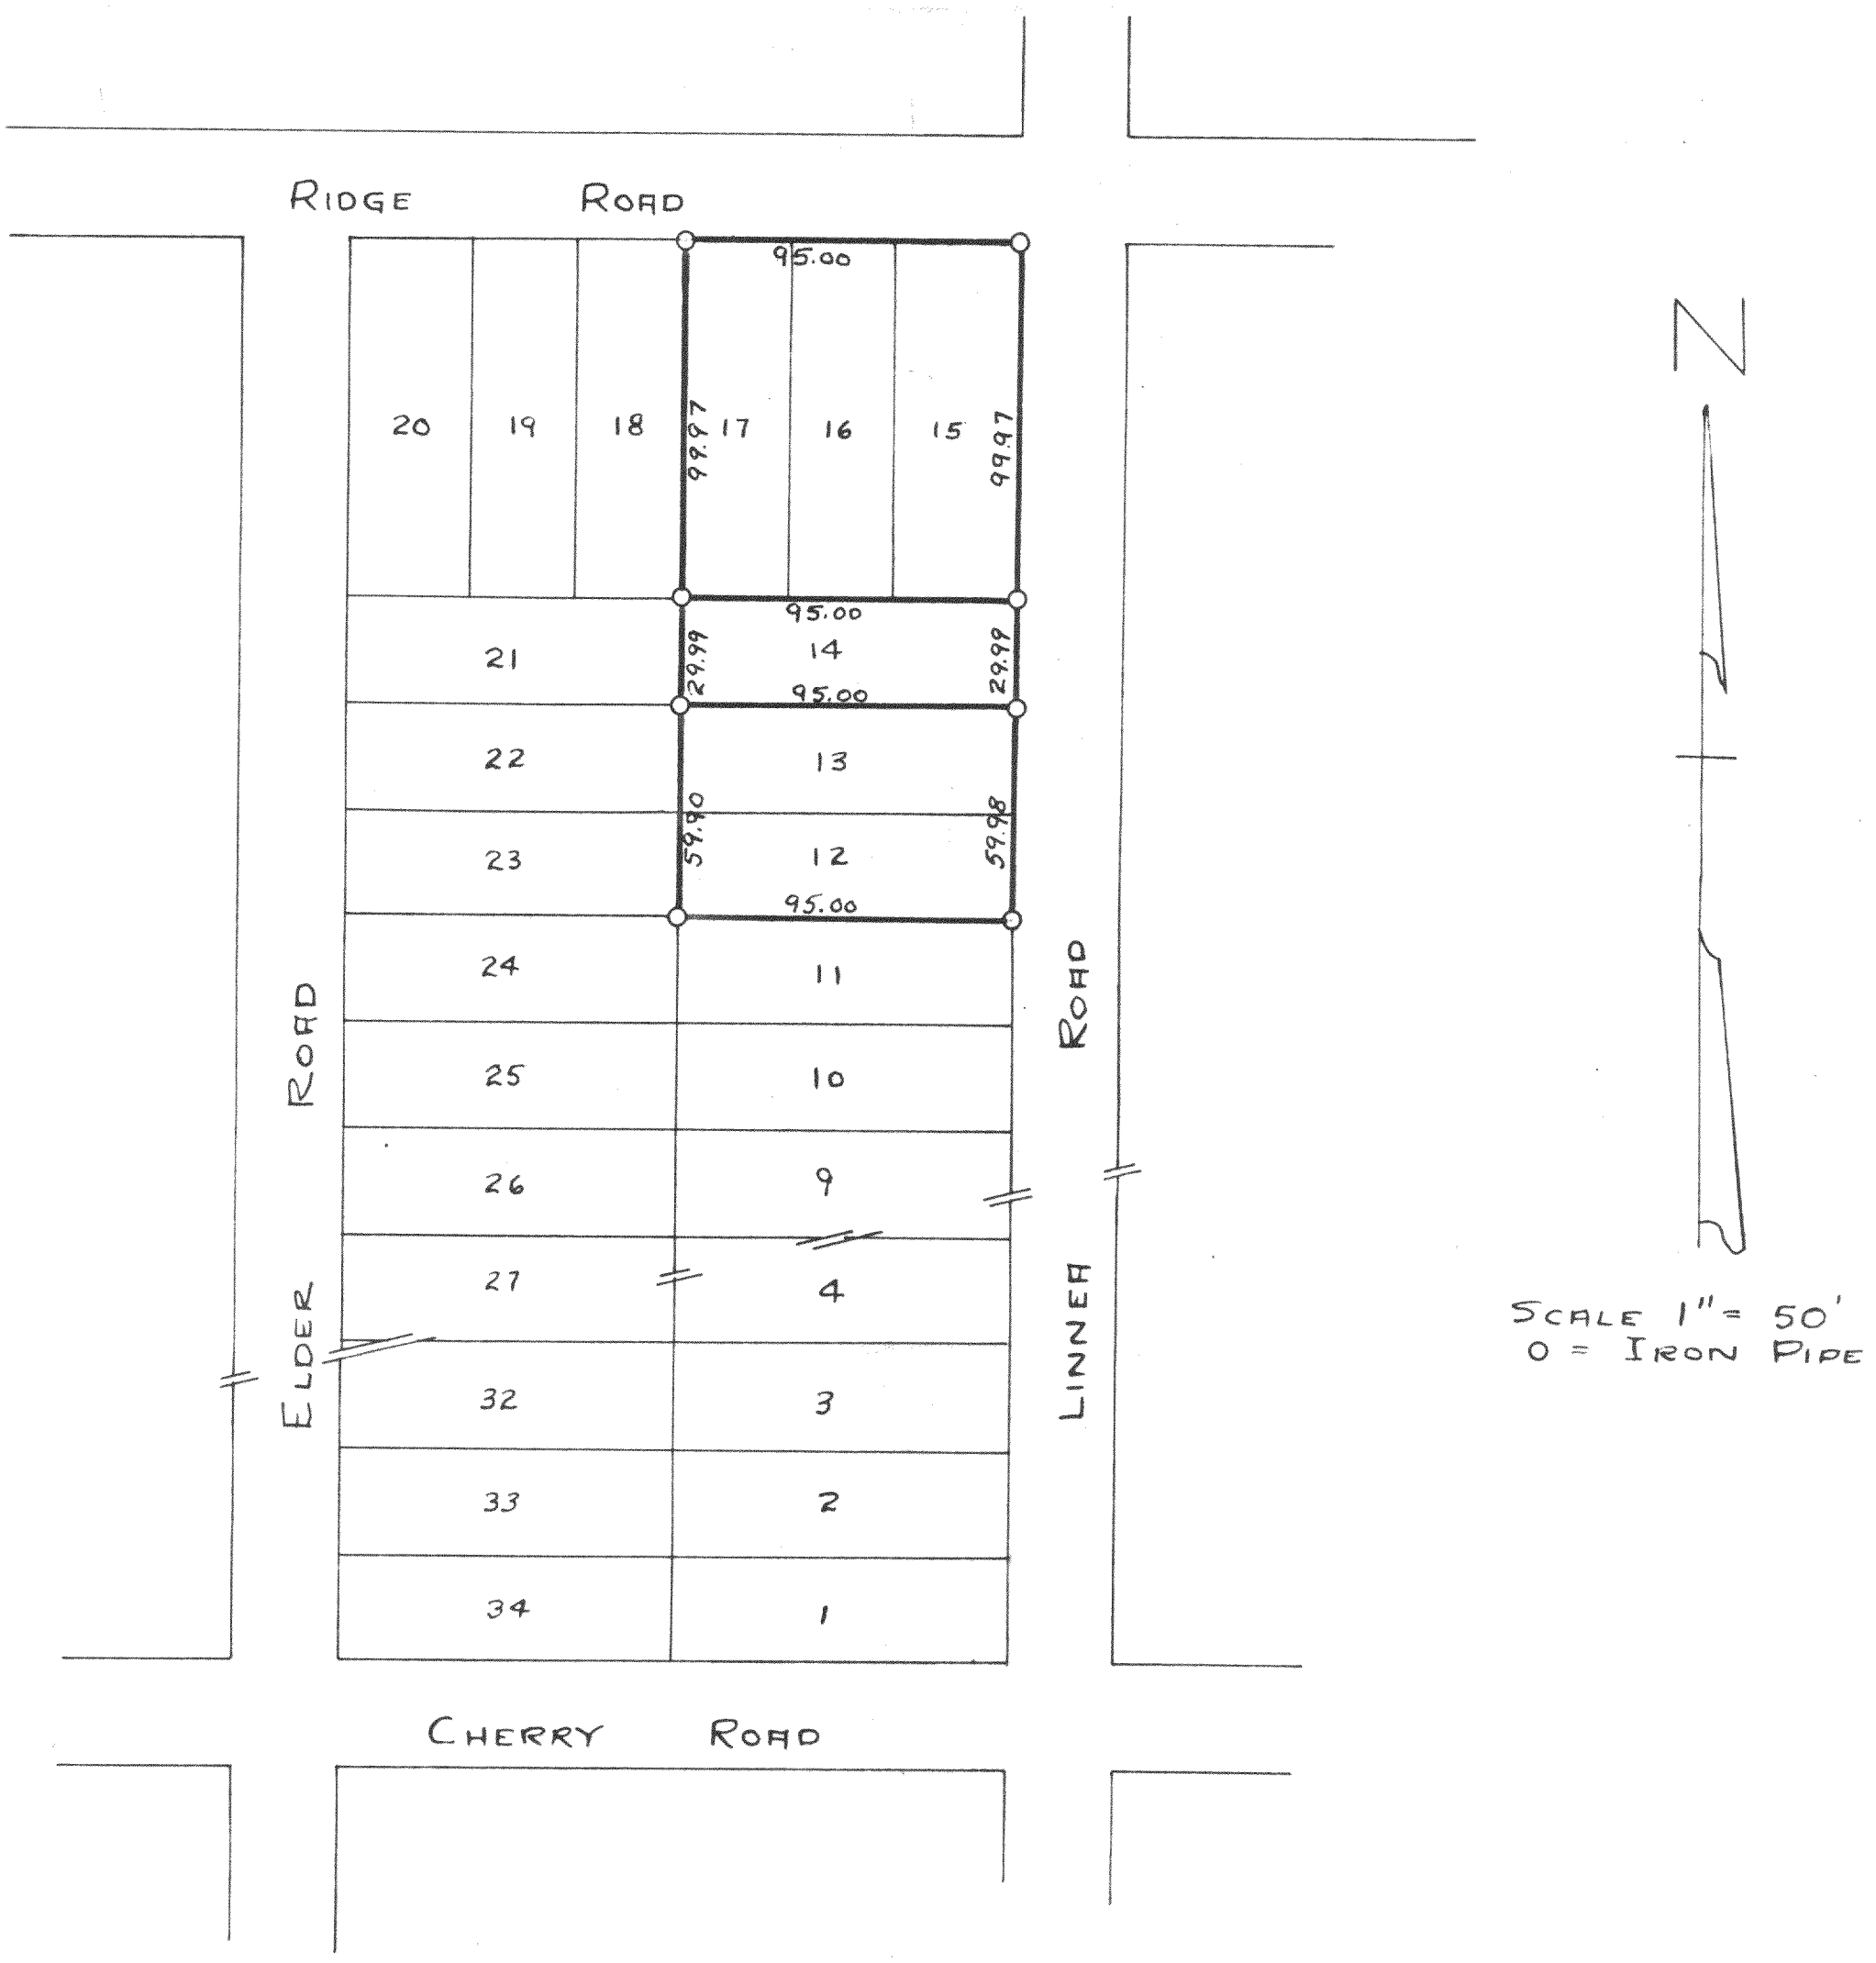

Cl-306
" 311

PLAT OF SURVEY OF LOTS 12, 13, 14, 15, 16 AND 17 OF BLOCK 18 OF SKANSEN SWEDISH TRIBUNE-NEWS SUBDIVISION LOCATED IN SECTION 9 OF T3NR15E, WALWORTH COUNTY, WISCONSIN

AUGUST 1949

Floyd L. Jensen
COUNTY SURVEYOR

315-3.1

CS-306, 311