
PLAT OF SURVEY

LOTS 1 THRU 10, BLOCK 5
FOREST BEACH SUBDIVISION
SECTION 9, TOWN 3 NORTH, RANGE 15 EAST
WALWORTH COUNTY, WISCONSIN

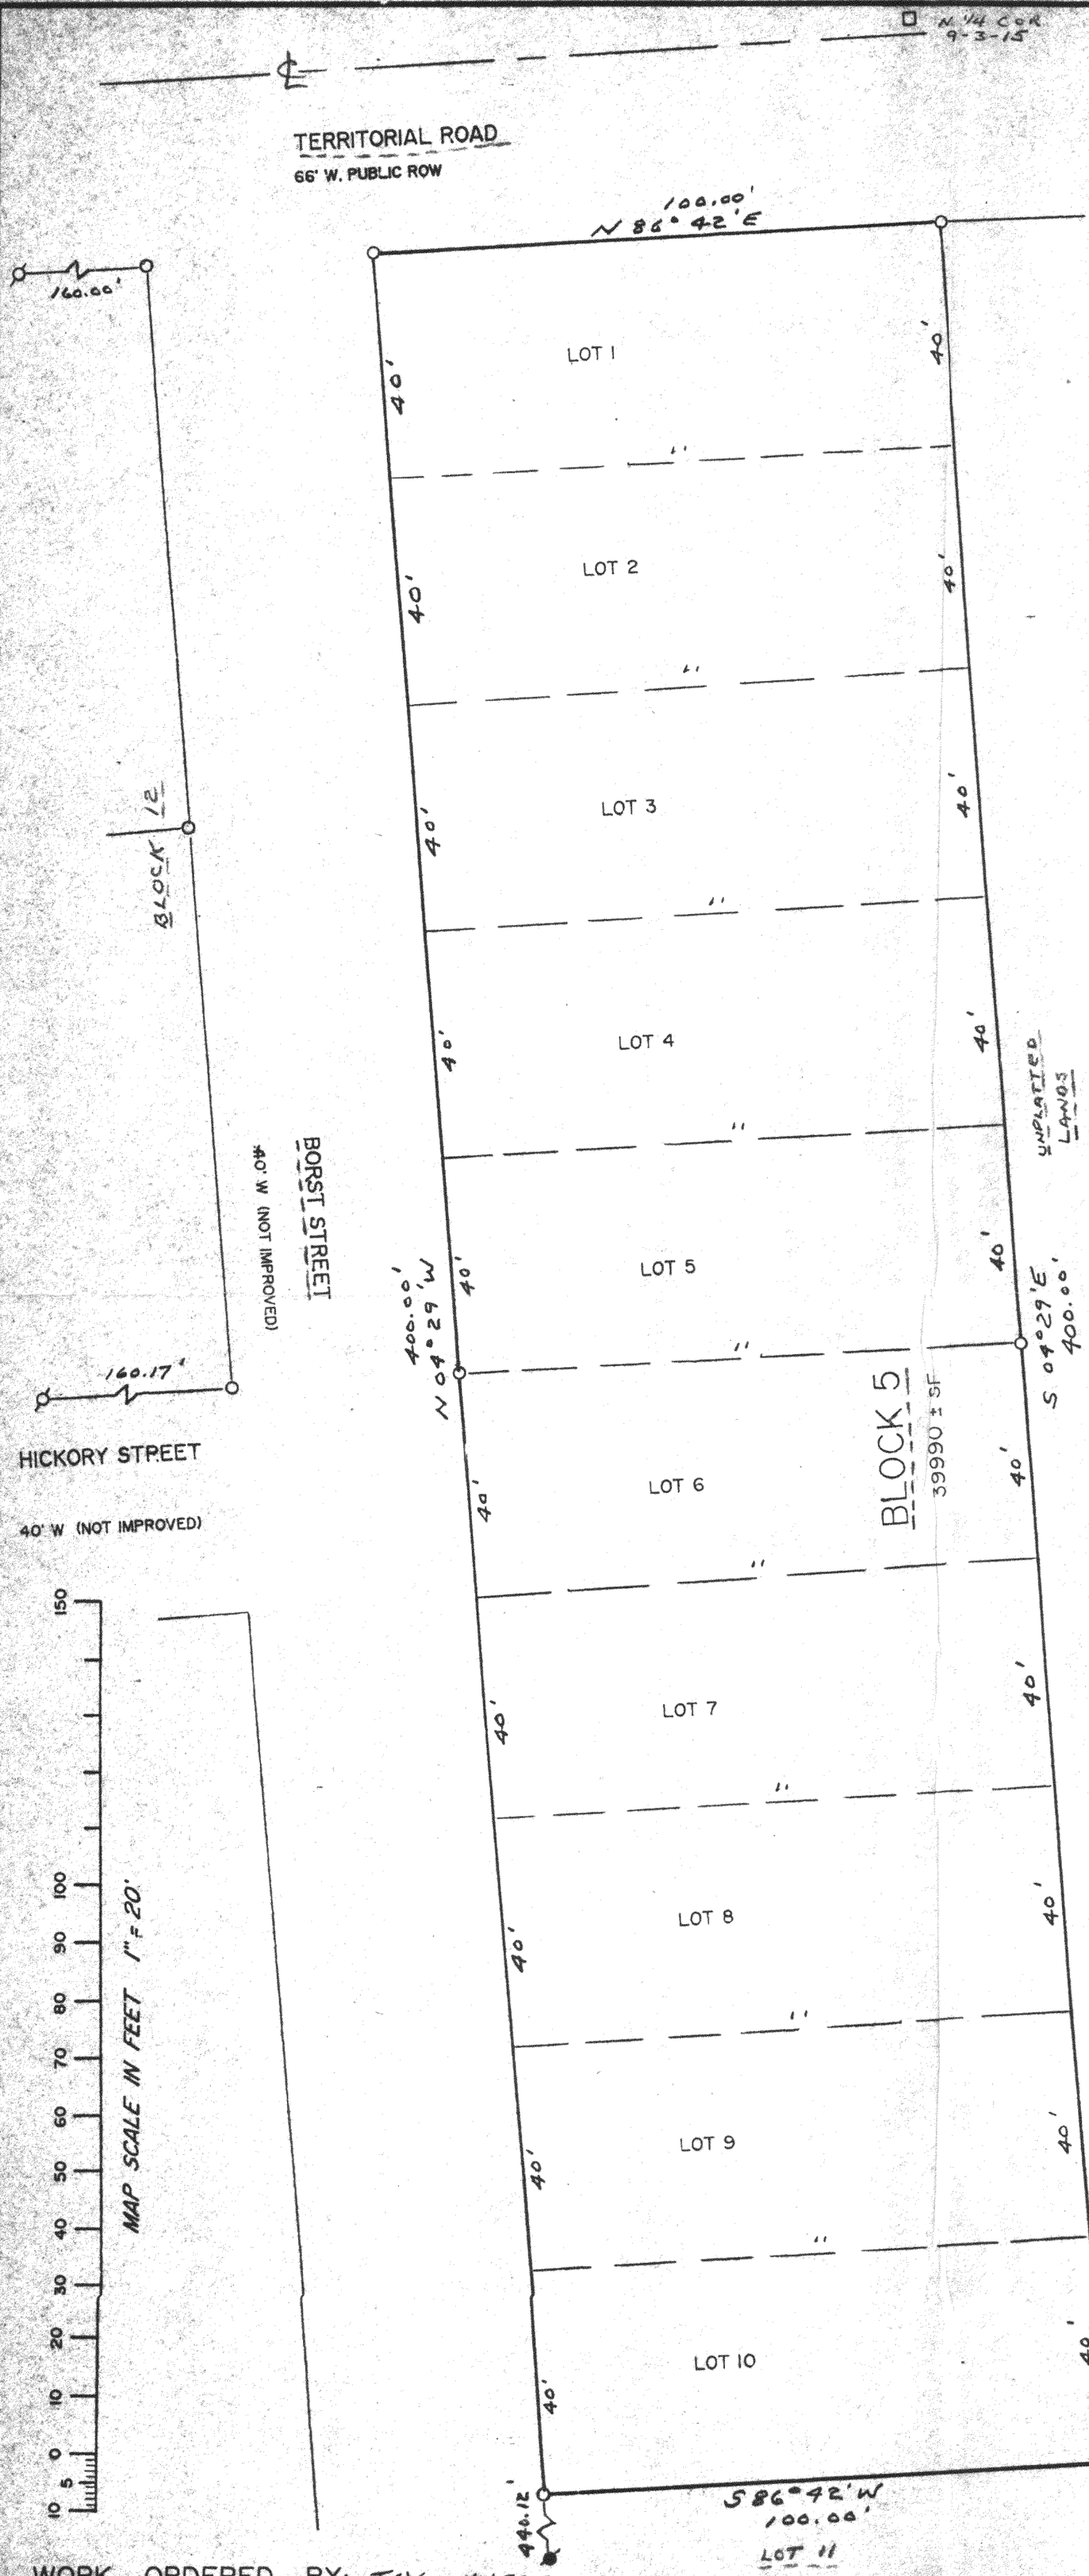

SOUTH LINE TERRITORIAL ROAD
ASSIGNED BEARING N 86° 42' E

LEGEND

- IRON REBAR STAKE FOUND
- IRON REBAR STAKE SET
- POZEY PIN FOUND
- CONCRETE COUNTY MONUMENT FOUND
- (<×>) RECORDED AS

NOTE: COPIES OF THIS MAP TO WHICH THE FOLLOWING CERTIFICATE WILL APPLY ARE BLUE LINE PRINTS SHOWING SURVEYOR'S ORIGINAL SEAL AND SIGNATURE IN BLACK INK. COPIES BY ANY OTHER MEANS MAY HAVE ALTERATIONS WHICH DO NOT REPRESENT THE SURVEYOR'S WORK PRODUCT.

I HEREBY CERTIFY THAT THIS PLAT OF SURVEY IS A TRUE AND ACCURATE REPRESENTATION OF THE BOUNDARY LINES OF THE SUBJECT PARCEL TO THE BEST OF MY KNOWLEDGE AND BELIEF. THIS SURVEY IS MADE FOR THE USE OF THE PRESENT OWNERS OF THE PROPERTY, AND ALSO THOSE WHO PURCHASE, MORTGAGE, OR GUARANTEE THE TITLE THERETO WITHIN ONE YEAR FROM THE DATE HEREOF.

DATED: MARCH 23, 1992

PETER S. GORDON RLS

WISCONSIN
PETER S. GORDON
S-2101
ELKHORN, WI
LAND SURVEYOR

RECEIVED
MAY 18 1992

WORK ORDERED BY: JAY MYERS

PLAT OF SURVEY

LOTS 1 THRU 10, BLOCK 5
FOREST BEACH SUBDIVISION
SECTION 9, TOWN 3 NORTH, RANGE 15 EAST
WALWORTH COUNTY, WISCONSIN

FARRIS, HANSEN & ASSOCIATES, INC.
Engineering, Architecture, Surveying
7 Ridgway Court P.O. Box 437
ELKHORN, WISCONSIN 53121
Office: (414) 723-2098
Fax: (414) 723-5886

REVISIONS

PROJECT NO 3613
DATE 03/19/92
SHEET NO. 1 OF 2

315-342

CFB-27
CFB-28