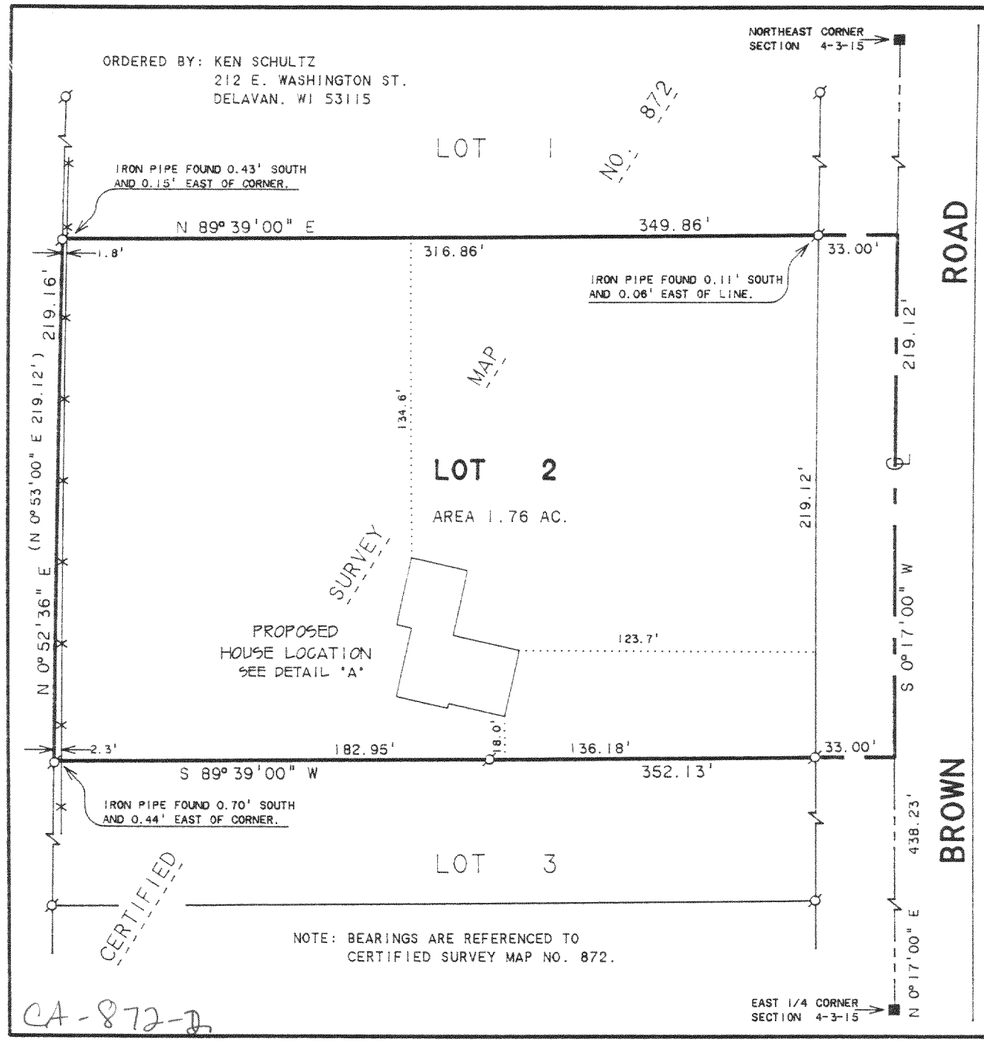


CA-872-D


SCALE 1"=60'

LEGEND

- ○ - IRON PIPE FOUND
- ■ - CONCRETE MONUMENT FOUND
- × - 60d SPIKE SET
- -×-×- - WIRE FENCE
- ( ) - RECORDED AS

RECEIVED
FEB 12 1993

December 16, 1992
REVISED DATE

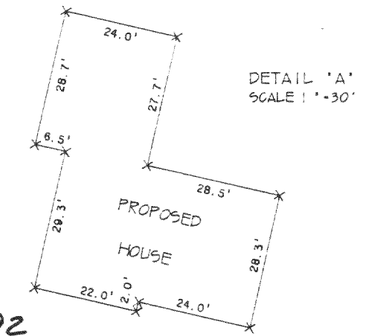

DETAIL 'A'
SCALE 1"=30'

ABELL SURVEYING & MAPPING

DELAVAN, WISCONSIN 53115
414-728-6737

PLAT OF SURVEY OF

LOT 2, CERTIFIED SURVEY MAP NO. 872, LOCATED IN T3N, R15E, WALWORTH COUNTY, WISCONSIN.

I, DAVID F. ABELL, DO HEREBY CERTIFY THAT I HAVE SURVEYED THE PROPERTY HEREON DESCRIBED ACCORDING TO THE OFFICAL RECORDS AND THAT THE PLAT HEREON IS A CORRECT REPRESENTATION OF THE PROPERTY LINES TO THE BEST OF MY KNOWLEDGE AND BELIEF.

David F. Abell

DAVID F. ABELL
WISCONSIN REGISTERED LAND SURVEYOR, S-1596

NOVEMBER 5, 1992
DATE

JOB NUMBER - 92243

NOTE: THIS IS NOT A CERTIFIED COPY UNLESS SEALED.

315-371