

ABELL
SURVEYING & MAPPING
1140 SEQUOIA STREET • DELAVAN, WISCONSIN 53115
262-728-6737

RECEIVED
AUG 31 2001

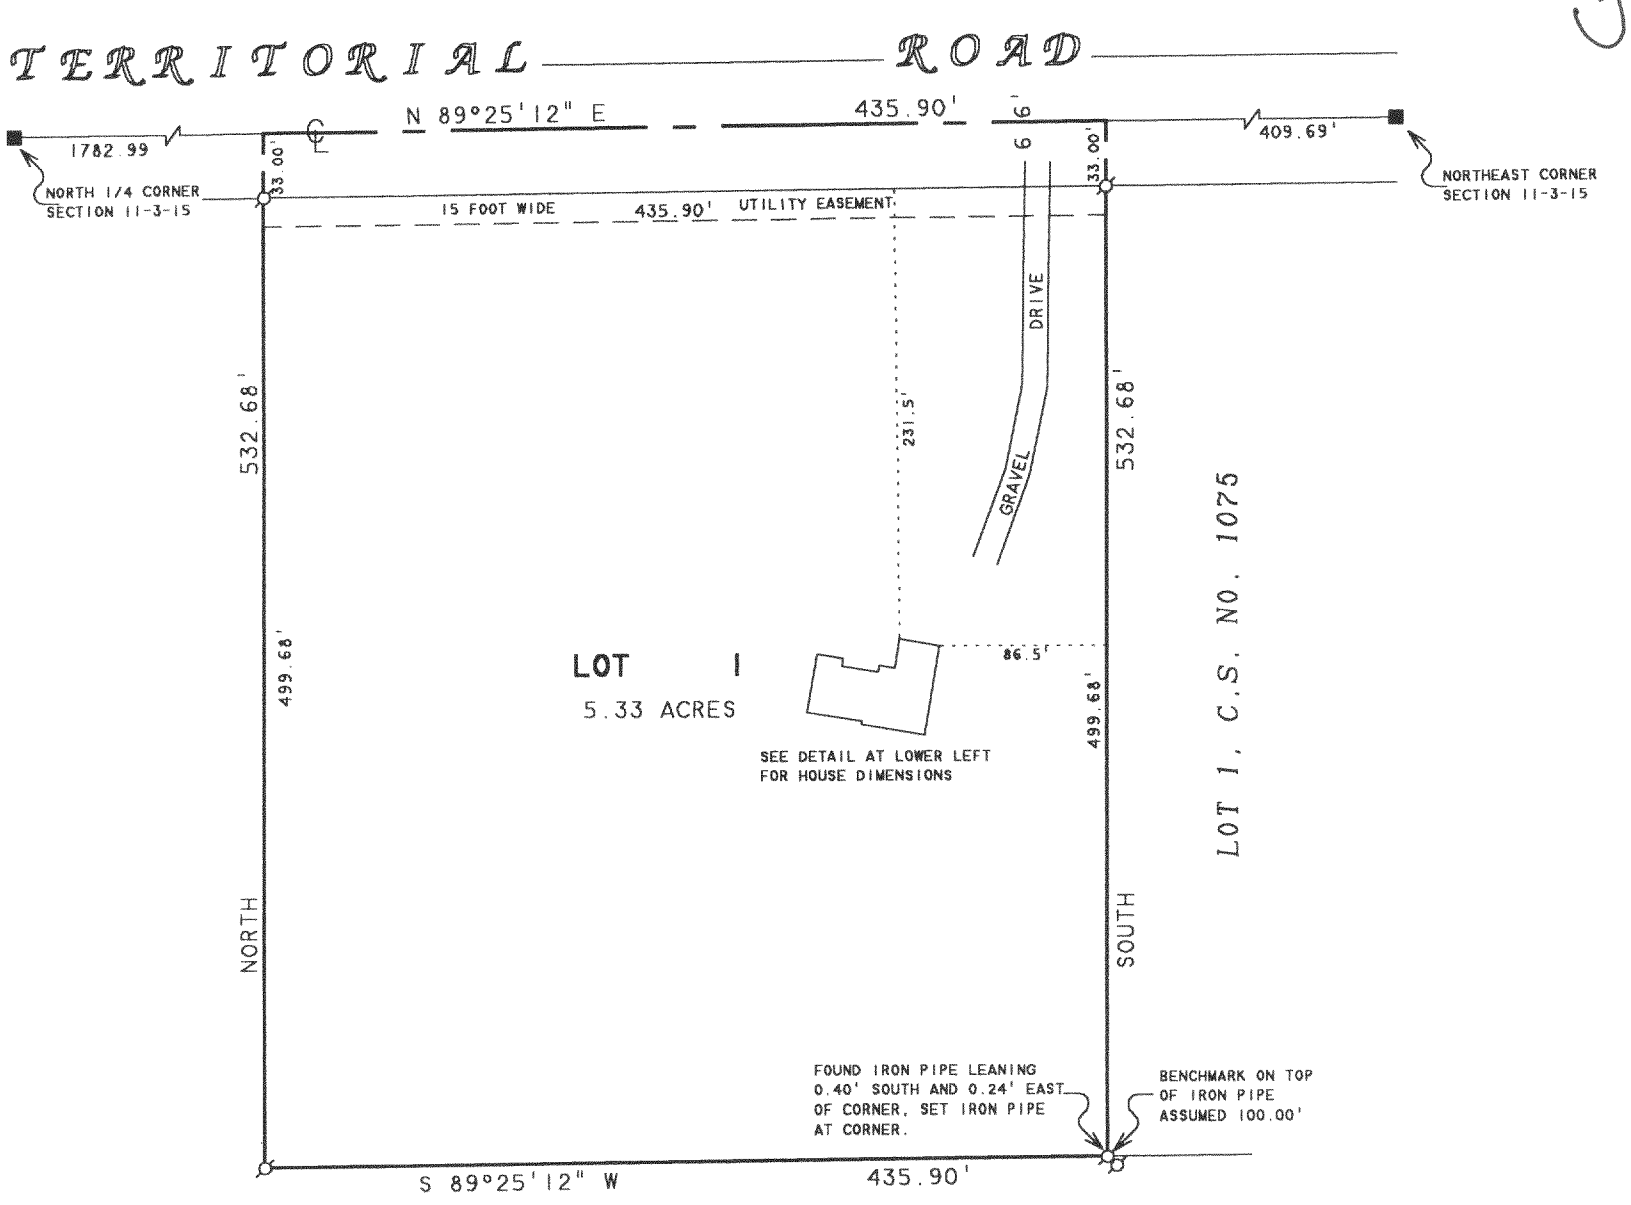

DETAIL SCALE - 1"=30'

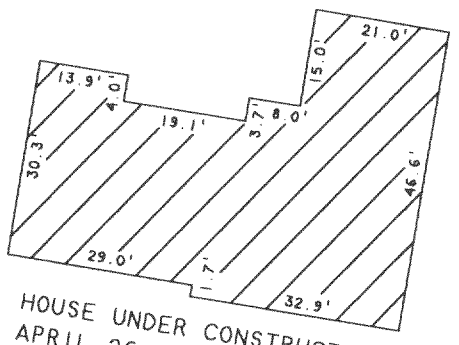

HOUSE UNDER CONSTRUCTION
APRIL 26, 2001

PLAT OF SURVEY OF

LOT 1, CERTIFIED SURVEY MAP NO. 3294, LOCATED IN THE NORTHEAST 1/4 OF THE NORTHEAST 1/4 OF SECTION 11, T3N, R15E, WALWORTH COUNTY, WISCONSIN.

ORDERED BY: GINGER HAMMERSTAD
W7864 COUNTY ROAD A
DELAVAN, WI 53115

NOTE: BEARINGS ARE REFERENCED TO CERTIFIED SURVEY MAP NO. 3294.

N

SCALE 1"=100'

LEGEND

ø - IRON PIPE FOUND
■ - WALWORTH COUNTY MONUMENT

I, DAVID F. ABELL, DO HEREBY CERTIFY THAT I HAVE SURVEYED THE PROPERTY HEREON DESCRIBED ACCORDING TO THE OFFICAL RECORDS AND THAT THE PLAT HEREON IS A CORRECT REPRESENTATION OF THE PROPERTY LINES TO THE BEST OF MY KNOWLEDGE AND BELIEF.

David F. Abell

DAVID F. ABELL
WISCONSIN REGISTERED LAND SURVEYOR, S-1596

April 26, 2001

DATE JOB NUMBER - 00095B
NOTE: THIS IS NOT A CERTIFIED COPY UNLESS SEALED.

CA-3294-1
315-742