ABELL
SURVEYING & MAPPING


1140 SEQUOIA STREET • DELAVAN, WISCONSIN 53115
262-728-6737

N

SCALE 1"=20'

LEGEND

Ø - IRON PIPE FOUND
CP - COVERED PORCH
( ) - RECORDED AS

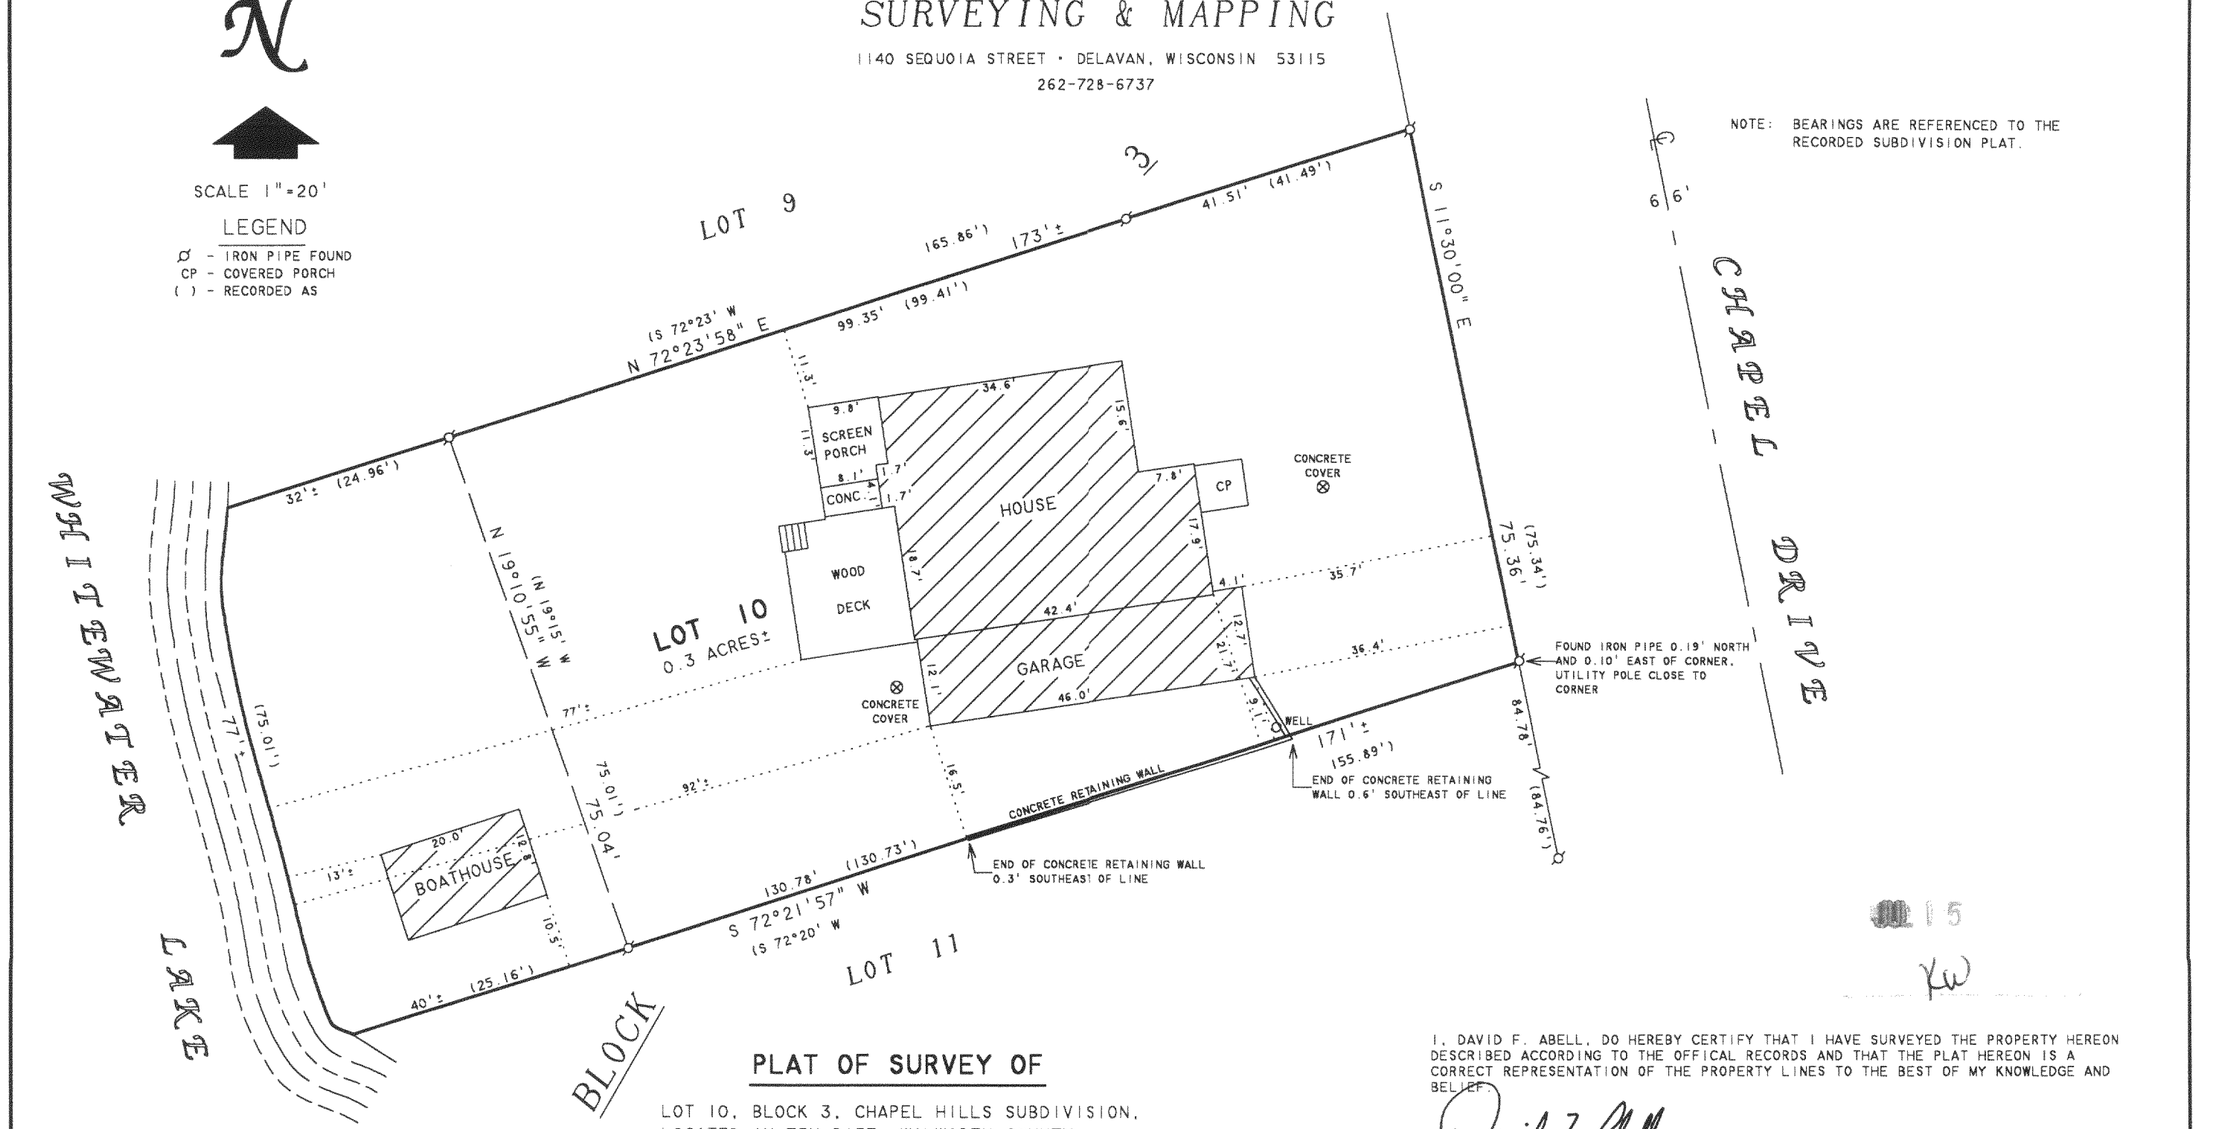

NOTE: BEARINGS ARE REFERENCED TO THE RECORDED SUBDIVISION PLAT.

PLAT OF SURVEY OF

LOT 10, BLOCK 3, CHAPEL HILLS SUBDIVISION, LOCATED IN T3N, R15E, WALWORTH COUNTY, WISCONSIN.

ORDERED BY: RONALD SHAPIRO
222 E. CHESTNUT STREET
APT. 5C
CHICAGO, IL 60611

REVISED DATE: MAY 21, 2004
REVISED TO SHOW LOCATION OF WOOD DECK, WELL AND CONCRETE COVERS.

ORDERED BY: JANET LIPPINCOTT
741 CRESTWOOD DRIVE
WAUKESHA, WI 53188

I, DAVID F. ABELL, DO HEREBY CERTIFY THAT I HAVE SURVEYED THE PROPERTY HEREON DESCRIBED ACCORDING TO THE OFFICAL RECORDS AND THAT THE PLAT HEREON IS A CORRECT REPRESENTATION OF THE PROPERTY LINES TO THE BEST OF MY KNOWLEDGE AND BELIEF.

David F. Abell

DAVID F. ABELL
WISCONSIN REGISTERED LAND SURVEYOR, S-1596

February 11, 1999

DATE JOB NUMBER - 99009A

NOTE: THIS IS NOT A CERTIFIED COPY UNLESS SEALED.

CCH 00088

315-863