PREPARED FOR : CENTURY 21 AFFILIATED
C\O JIM CURTIS
PO. BOX 367
WILLIAMS BAY WI. 53191

PLAT OF SURVEY

- OF -

LOTS 16,17 AND18 BLOCK 1 OF SKANSEN FIRST ADDITION TO THE SWEDISH TRIBUNE NEWS SUBDIVISION, TOWN OF RICHMOND, TOWN 3 NORTH, RANGE 15 EAST, WALWORTH COUNTY, WISCONSIN .

PATHFINDER SURVEYING INC.
N3705 WILLOW BEND LANE
LAKE GENEVA WI. 53147

NOTE : BASIS OF BEARING IS THE RECORD PLAT

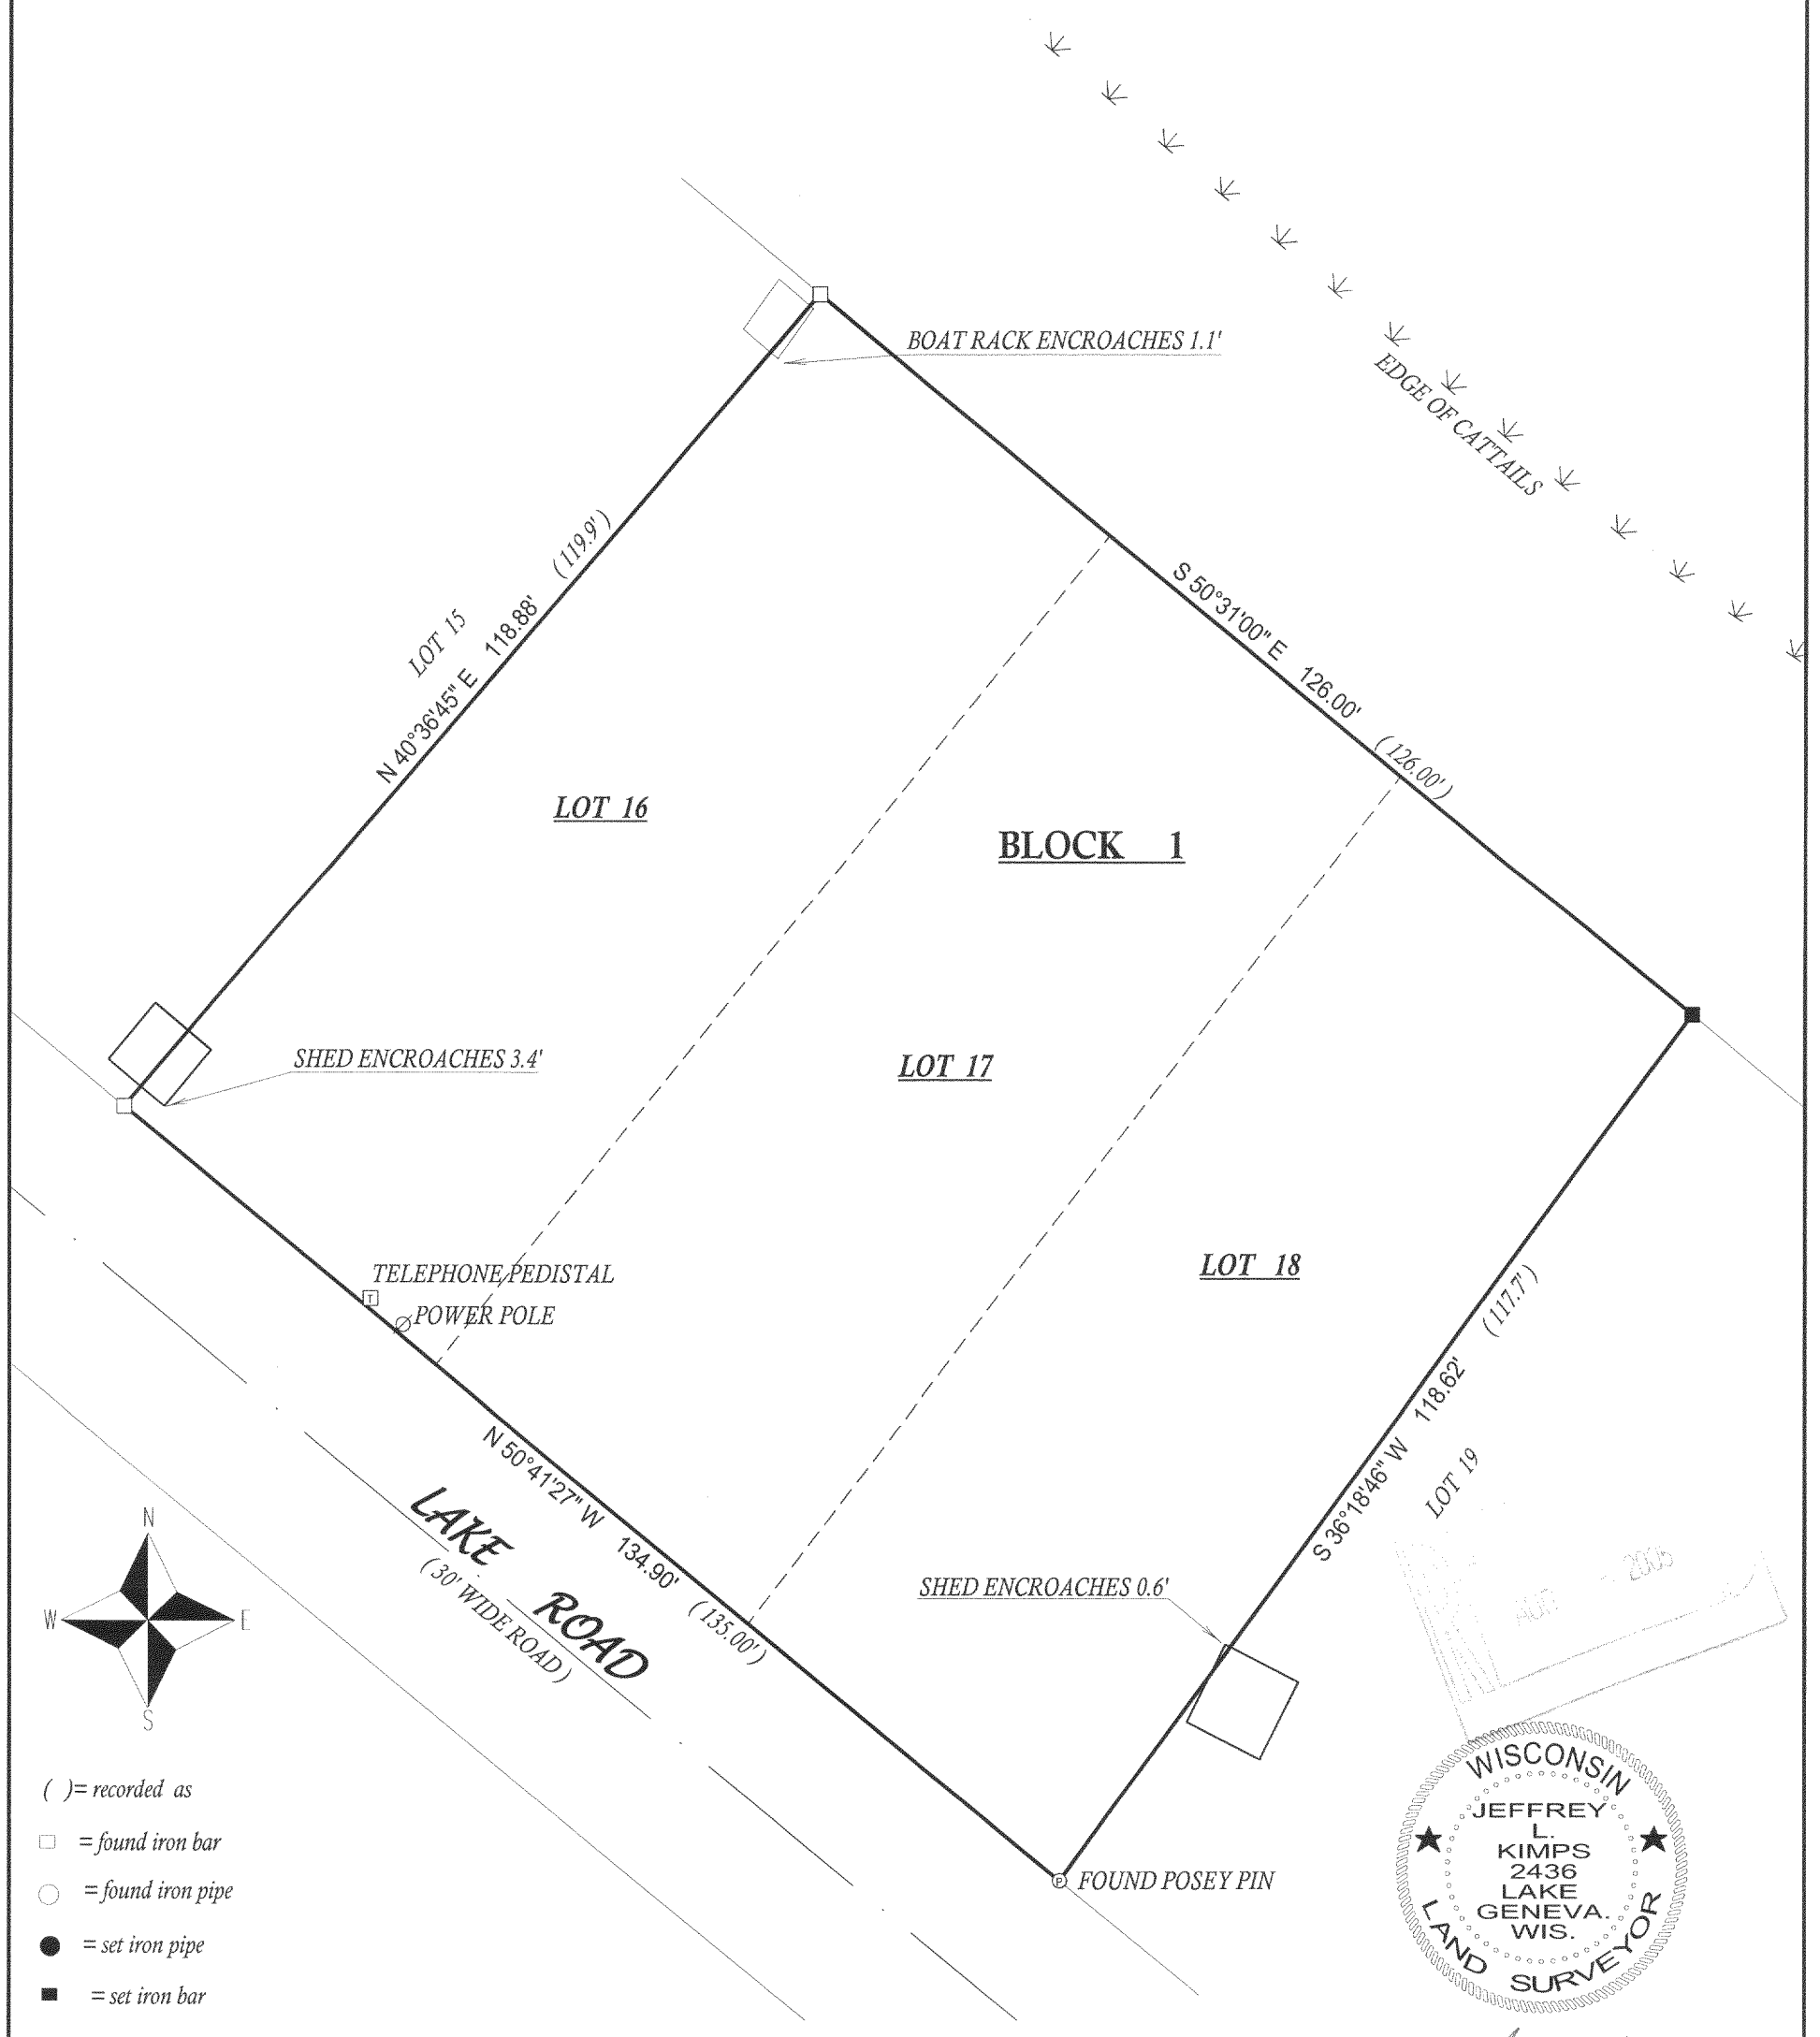

( )= recorded as

□ = found iron bar

○ = found iron pipe

● = set iron pipe

■ = set iron bar

SCALE 1" = 20'

JOB # 05-290

TAX ID # CSA00009

COMPARE LEGAL DESCRIPTION ABOVE AND DRAWING WITH DEED. FOR BUILDING RESTRICTIONS AND EASEMENTS NOT SHOWN,REFER TO DEED, ABSTRACT SOURCES AND LOCAL MUNICIPAL CODES. NOTIFY THE SURVEYOR IMMEDIATELY OF ANY DISCREPANCY.

"I hereby certify that I have surveyed the above described property and that the above map, to the best of my knowledge and belief, is a true representation thereof and shows the size and location of all visible structures, apparent easements and encroachmentsif any."
This survey is made for the present owners of the property, and those who purchase, mortgage, or guarentee the title thereto, within one year from the date hereof.

WISCONSIN JEFFREY L. KIMPS 2436 LAKE GENEVA. WIS. LAND SURVEYOR

JEFFREY L. KIMPS S - 2436
Wisconsin Registered Land Surveyor
(original if signed in red)

DATED THIS THE 15th DAY OF JUNE 2005.

CSA 00009

315 - 920