
FARRIS, HANSEN & ASSOCIATES, INC.

ENGINEERING – ARCHITECTURE – SURVEYING
7 RIDGWAY COURT – P.O. BOX 437 – ELKHORN, WISCONSIN 53121
PHONE: (262) 723–2098 FAX: (262) 723–5886

PLAT OF SURVEY

LOTS 8 THRU 13 OF BLOCK H
OF CRYSTAL BOWL SUBDIVISION
LOCATED IN PART OF THE NE 1/4 OF
THE NW 1/4 OF SECTION 13, TOWN 3 NORTH,
RANGE 15 EAST, WALWORTH COUNTY, WISCONSIN

– WORK ORDERED BY –
PAUL DEMCHENKO
W4724 S. LAKESHORE DRIVE
FONTANA, WI 53125

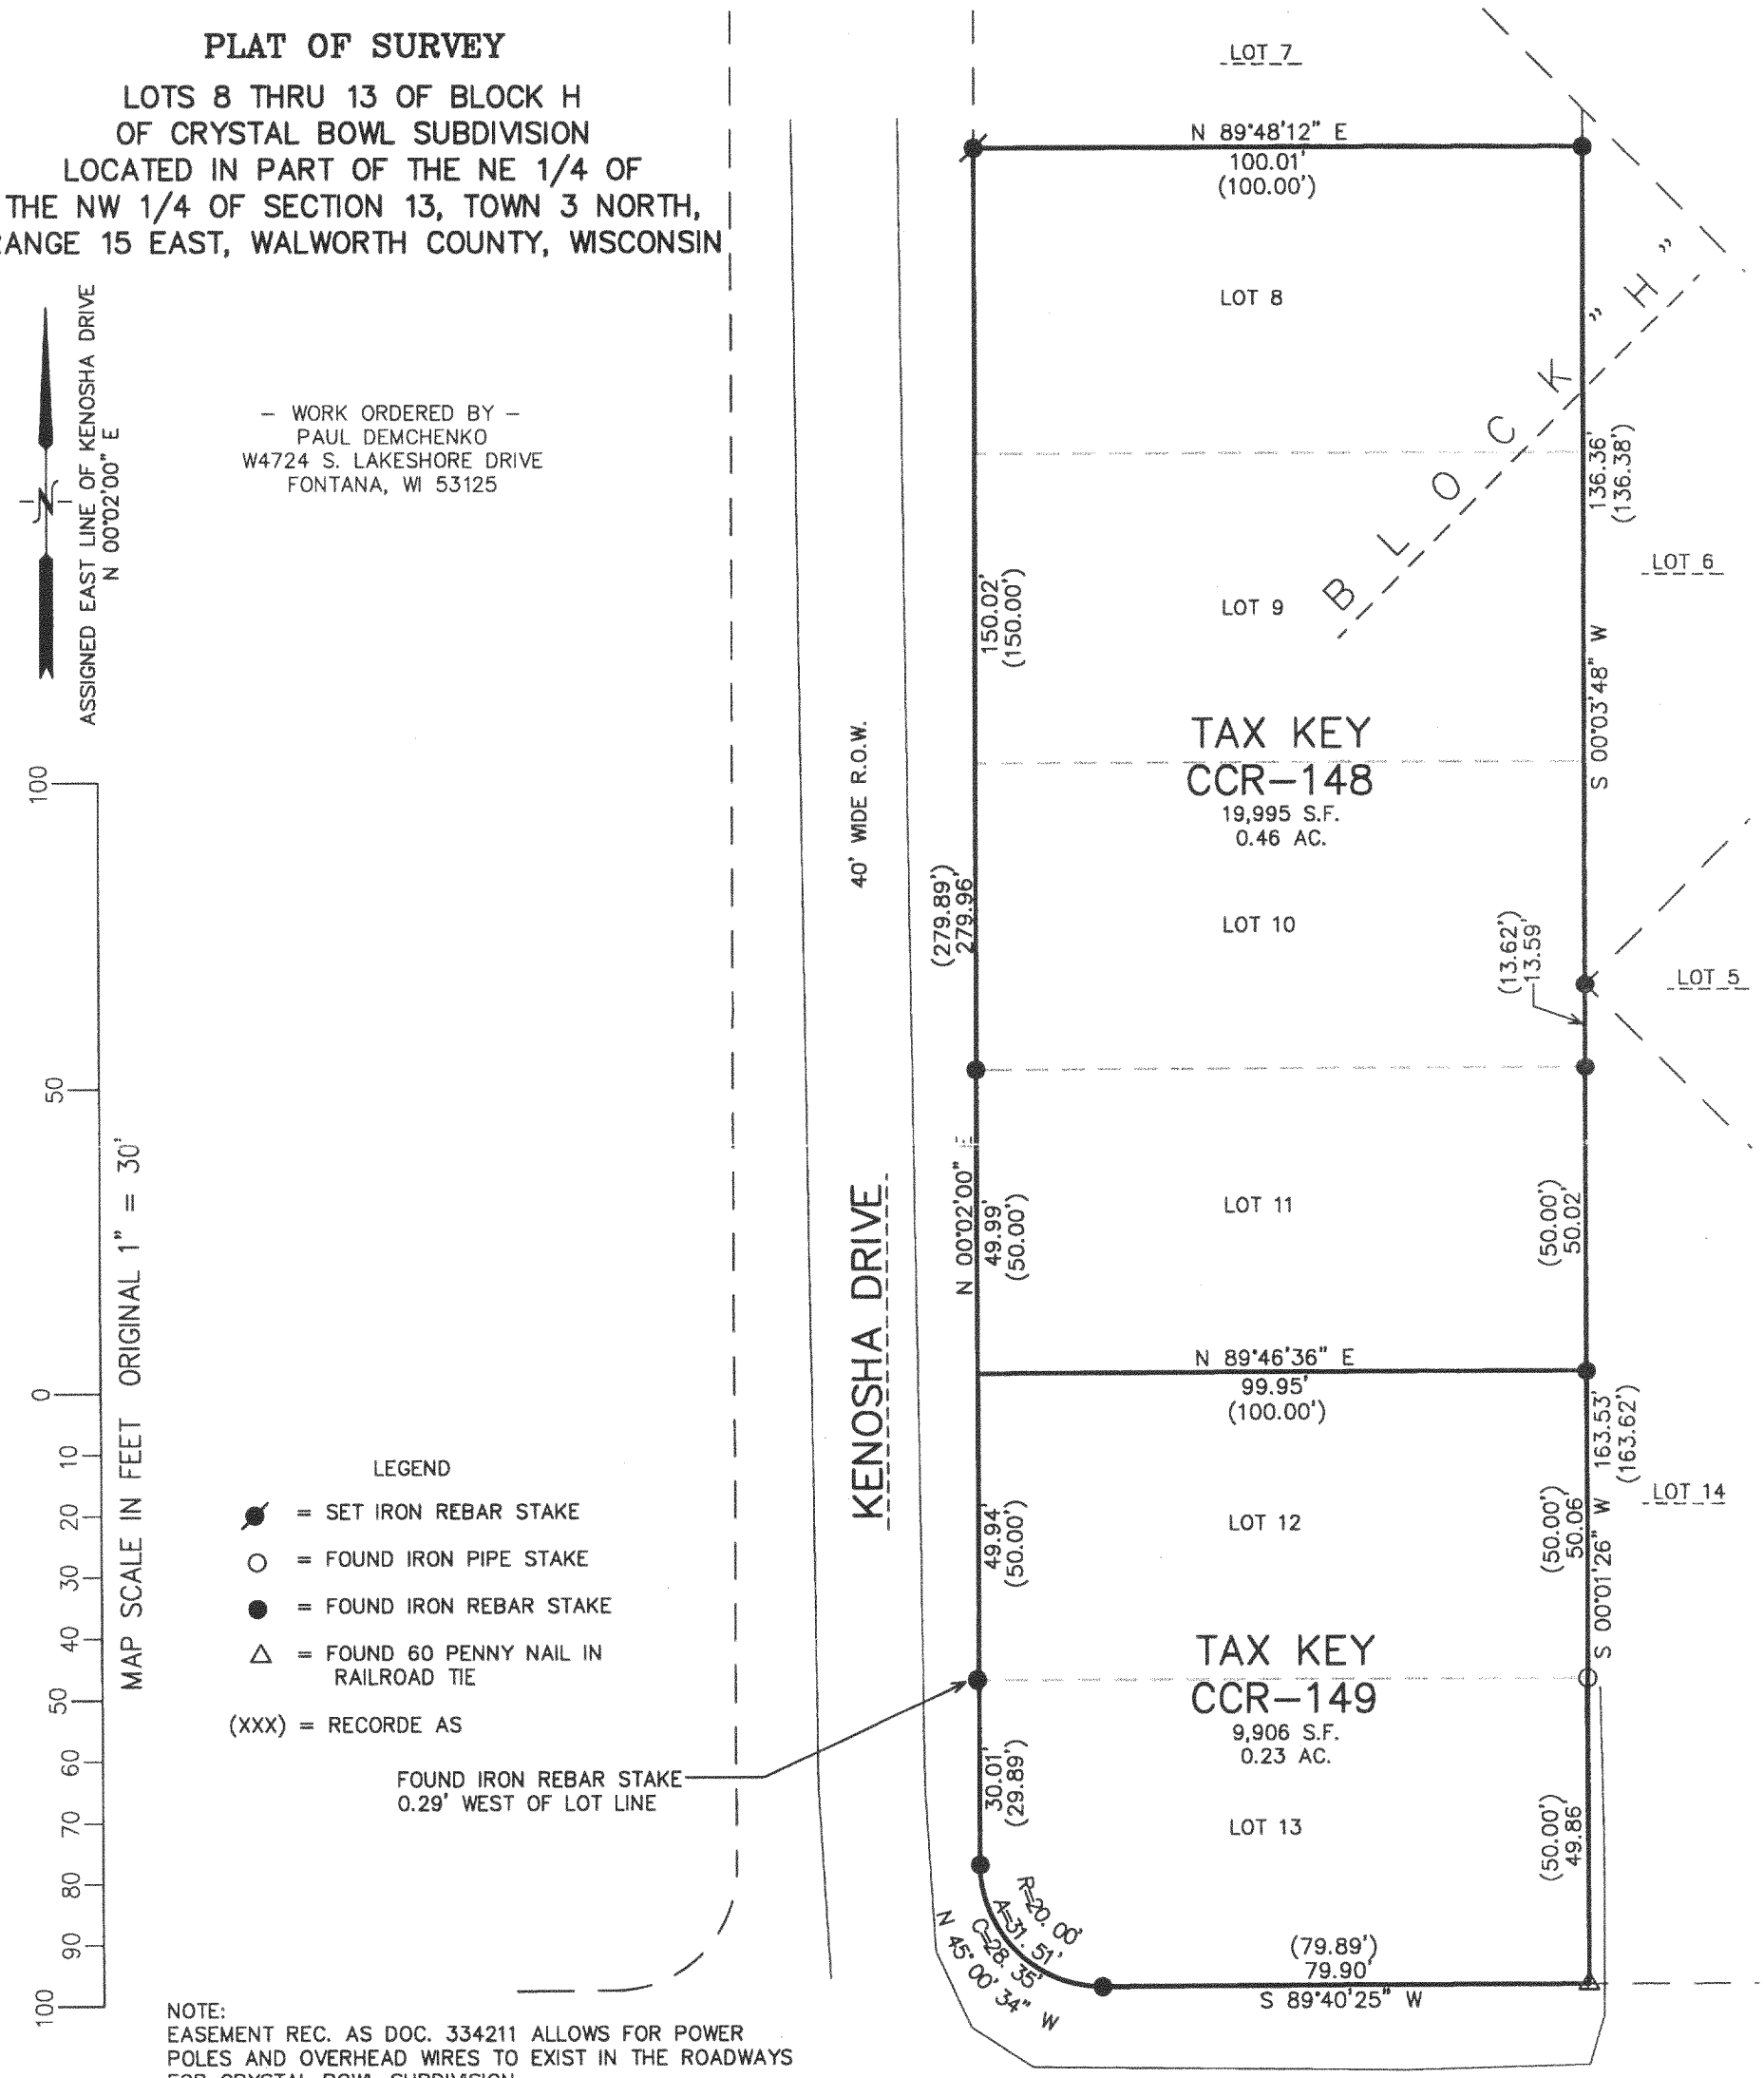

NOTE:
EASEMENT REC. AS DOC. 334211 ALLOWS FOR POWER POLES AND OVERHEAD WIRES TO EXIST IN THE ROADWAYS FOR CRYSTAL BOWL SUBDIVISION.

NOTE: COPIES OF THIS MAP TO WHICH THE FOLLOWING CERTIFICATE WILL APPLY SHOW THE SURVEYOR'S ORIGINAL SEAL AND SIGNATURE IN RED INK. COPIES BY ANY OTHER MEANS MAY HAVE ALTERATIONS WHICH DO NOT REPRESENT THE SURVEYOR'S WORK PRODUCT.

I HEREBY CERTIFY THAT THE ABOVE DESCRIBED PROPERTY HAS BEEN SURVEYED UNDER MY DIRECTION AND THAT THE ABOVE MAP IS A TRUE REPRESENTATION THEREOF AND SHOWS THE SIZE AND LOCATION OF THE PROPERTY, ITS EXTERIOR BOUNDARIES, THE LOCATION OF ALL VISIBLE STRUCTURES, AND DIMENSIONS OF ALL PRINCIPLE BUILDINGS THEREON, BOUNDARY FENCES, APPARENT EASEMENTS, ROADWAYS, AND VISIBLE ENCROACHMENTS, IF ANY. THIS SURVEY IS MADE FOR THE USE OF THE PRESENT OWNERS OF THE PROPERTY, AND ALSO THOSE WHO PURCHASE, MORTGAGE, OR GUARANTEE THE TITLE THERETO WITHIN ONE YEAR FROM THE DATE HEREOF.

DATED: OCTOBER 25, 2005

PETER S. GORDON

PROJECT: 6904
DATE: 10/25/2005
SHEET 1 OF 1

10/31/2005 X:\Projects\6904\Dcad\TITLESUR

CCR-149 · CCR-148

315-941