D Cooper & CO., INC
Rt 4 Box 508B * Elkhorn WI 53121

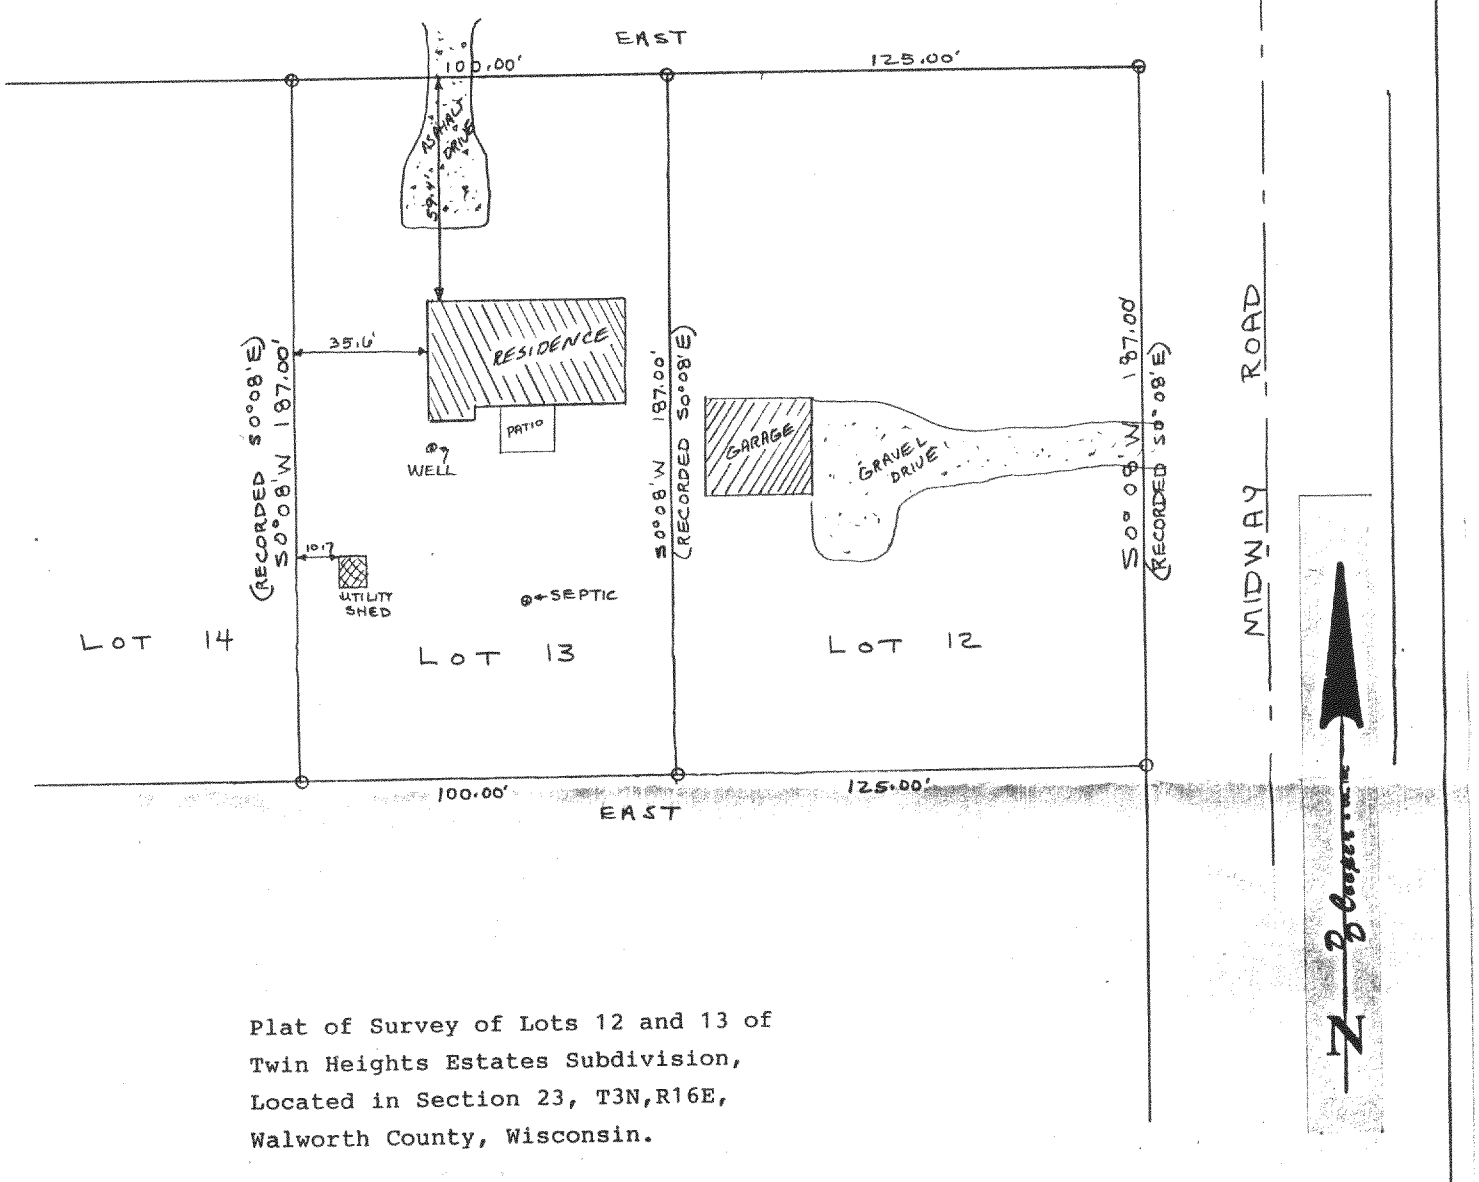

Plat of Survey of Lots 12 and 13 of
Twin Heights Estates Subdivision,
Located in Section 23, T3N,R16E,
Walworth County, Wisconsin.

Survey ordered by Earl Zimmerman
Rt 2 Elkhorn WI.

Bearing Reference: Northerly line of Lot assumed to bear East-West

Legend

- o Indicates Iron pipe found
- • Indicates 1"x24" iron rod set

Scale 1"=40'

WISCONSIN DANIEL D. COOPER S-1464 WIS. LAND SURVEYOR

I hereby certify that I have surveyed the property described hereon and that the map shown hereon is a true and accurate representation thereof to the best of my professional knowledge and belief.

Dated this 28 day of Sept., 1989

Daniel D. Cooper

Daniel D. Cooper, RLS No. S-1464

DRAWING NO. 3514

Reduced

RECEIVED FEB 20 1991

TAX KEY # GTHS 00006 (LOT 12)
GTHS 00007 (LOT 13)

316-477