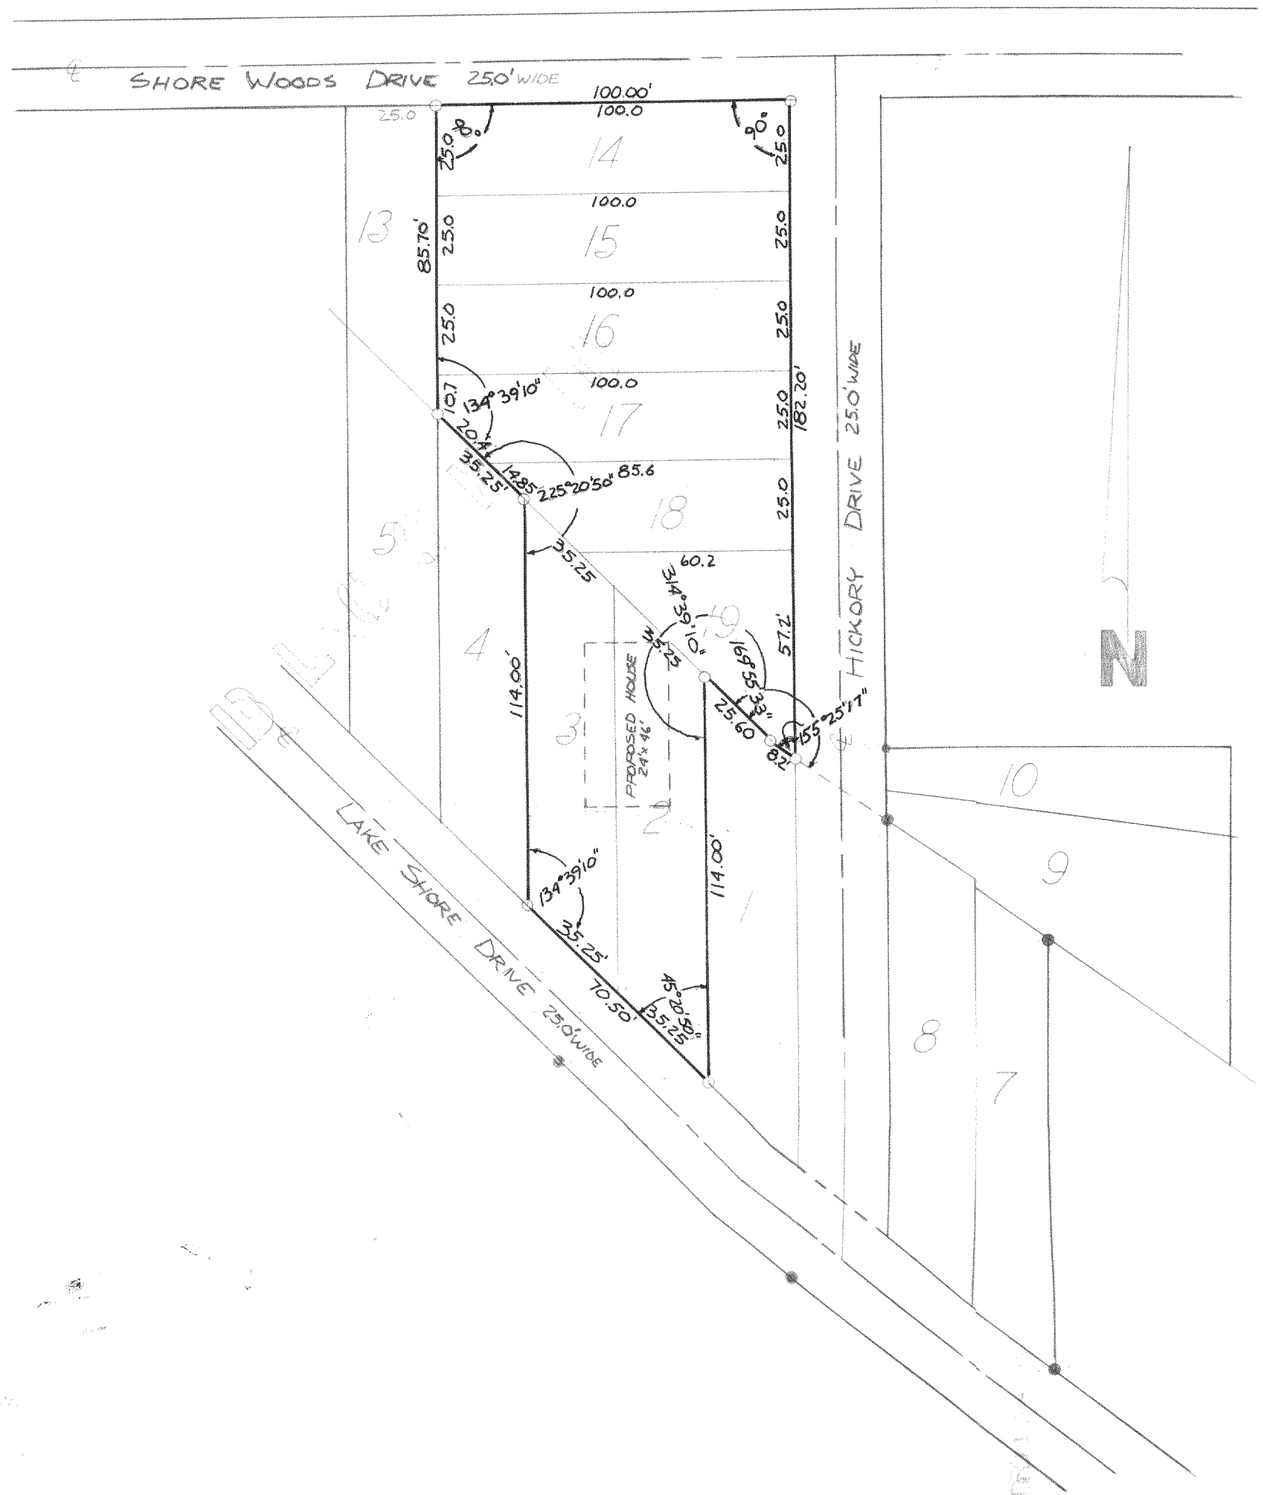

LEGEND

- ● IRON ROD FOUND
- ● IRON PIPE FOUND
- ○ IRON PIPE SET

SCALE: 1" = 40'

DESCRIPTION:
LOTS 2, 3, 14, 15, 16, 17, 18, & 19, BLOCK 10 OF NORTH LAKE SHOREWOODS, T.3N, R.16E, LOCATED IN WALWORTH COUNTY, WISCONSIN.

CERTIFICATE:
I, JOSEPH M. BIAGI, SURVEYOR, DO HEREBY CERTIFY THAT I HAVE SURVEYED THE PROPERTY HEREON DESCRIBED.

SIGNED: AUGUST 27, 1974

JOSEPH M. BIAGI RLS 12
ELKHORN, WI.

WISCONSIN
JOSEPH M. BIAGI
S-12
ELKHORN
WIS.
LAND SURVEYOR

REVISIONS			NORTH LAKE SHOREWOODS		
NO.	DATE	BY	LOTS 2, 3, 14, 15, 16, 17, 18, & 19 BLK. 10		
1					
2					
3			DRAWN BY JPR	SCALE 1" = 40'	MATERIAL
4			CHK'D	DATE 8-27-74	DRAWING NO. #97-74
5			TRACED	APP'D	

©NLS-99.103

TELEDYNE POST 18AE-10E—12X18

316-100B