PLAT OF SURVEY


LOTS 7 THRU 17 OF BLOCK 36
& LOTS 1 THRU 8, THE WEST 1/2 OF LOT 11, & LOTS 12 THRU 15 OF BLOCK 31
INTERLAKEN SUBDIVISION, ACCORDING TO THE RECORDED PLAT THEREOF, WALWORTH COUNTY, WISCONSIN

LEGAL DESCRIPTION
LANDS ADDED TO 1996 SURVEY

THE SYMMETRICAL ONE HALF OF LOT 34 ADJOINING LOT 33 AND THE SYMMETRICAL TWO THIRDS OF LOT 33 ADJOINING LOT 34, IN BLOCK 35, ON A MAP ENTITLED: THIRD MAP OF INTERLAKEN, TOWN OF SUGAR CREEK, WALWORTH COUNTY, WISCONSIN, AND RECORDED IN THE OFFICE OF THE REGISTER OF DEEDS FOR SAID COUNTY ON THE 20th DAY OF JUNE, 1929 IN VOLUME NO. 11 OF DEEDS, PAGES 4 AND 5.

AND ALSO
THE SYMMETRICAL ONE THIRD OF LOT 33 ADJOINING LOT 32, AND LOT 32, IN BLOCK 35, ON A MAP ENTITLED: THIRD MAP OF INTERLAKEN, TOWN OF SUGAR CREEK, WALWORTH COUNTY, WISCONSIN, AND RECORDED IN THE OFFICE OF THE REGISTER OF DEEDS FOR SAID COUNTY ON THE 20th DAY OF JUNE, 1929 IN VOLUME NO. 11 OF DEEDS, PAGES 4 AND 5.

AND ALSO THAT PART OF JUNIPER ROAD LYING SOUTH OF WHITTIER ROAD AS ABANDONED IN ROAD VACATION RECORDED IN VOL. 645, ON PAGE 4931 OF WALWORTH COUNTY DEEDS.

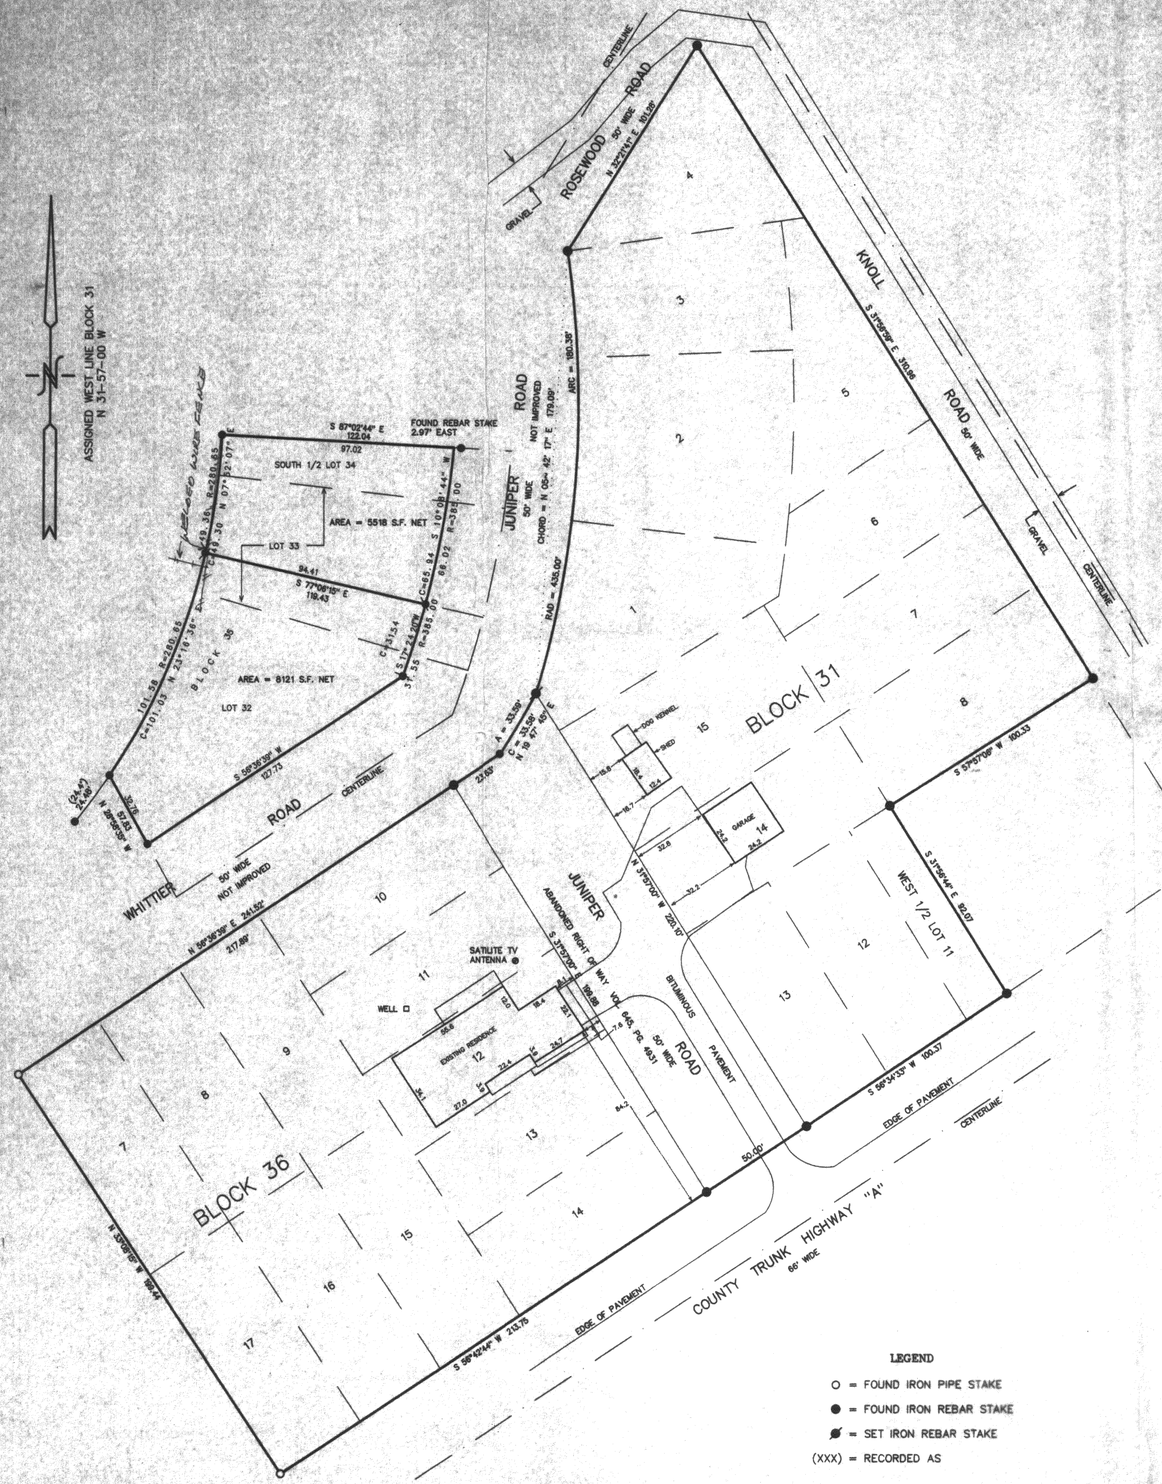

MAP SCALE IN FEET ORIGINAL 1" = 30'

LEGEND
- O = FOUND IRON PIPE STAKE
- ● = FOUND IRON REBAR STAKE
- ⌀ = SET IRON REBAR STAKE
- (XXX) = RECORDED AS

NOTE: COPIES OF THIS MAP TO WHICH THE FOLLOWING CERTIFICATE WILL APPLY ARE BLUE LINE PRINTS SHOWING SURVEYOR'S ORIGINAL SEAL AND SIGNATURE IN BLACK INK. COPIES BY ANY OTHER MEANS MAY HAVE ALTERATIONS WHICH DO NOT REPRESENT THE SURVEYOR'S WORK PRODUCT.

I HEREBY CERTIFY THAT THE ABOVE DESCRIBED PROPERTY HAS BEEN SURVEYED UNDER MY DIRECTION AND THAT THE ABOVE MAP IS A TRUE REPRESENTATION THEREOF AND SHOWS THE SIZE AND LOCATION OF THE PROPERTY AND ITS EXTERIOR BOUNDARIES. THIS SURVEY IS MADE FOR THE USE OF THE PRESENT OWNERS OF THE PROPERTY, AND ALSO THOSE WHO PURCHASE, MORTGAGE, OR GUARANTEE THE TITLE THERETO WITHIN ONE YEAR FROM THE DATE HEREOF.

DATED: 11-14-1996
REV 09-21-98

PETER S. GORDON R.L.S. 2101

WISCONSIN PETER S. GORDON S-2101 ELKHORN, WI LAND SURVEYOR

RECEIVED OCT 7 1998

GI-319 GI-278
GI-320 GI-278A
GI-321 GI-280
GI-281
316-1031

PLAT OF SURVEY

-- WORK ORDERED BY --
GENE SCHILTS
P.O. BOX 378
ELKHORN, WISCONSIN 53121

FARRIS, HANSEN & ASSOCIATES, INC.
Engineering, Architecture, Surveying
7 Ridgeway Court P.O. Box 437
ELKHORN, WISCONSIN 53121
Office: (414) 723-2098
Fax: (414) 723-5866

REVISIONS

PROJECT NO. 4643
DATE 11/14/96
SHEET NO. 1 OF 1