
PREPARED FOR: JEFF WINKLER
34305 HONEY LN.
BURLINGTON WI. 53105

J.K. SURVEYING INC.
N3705 WILLOWBEND LANE
LAKE GENEVA, WI, 53147
262-248-3697

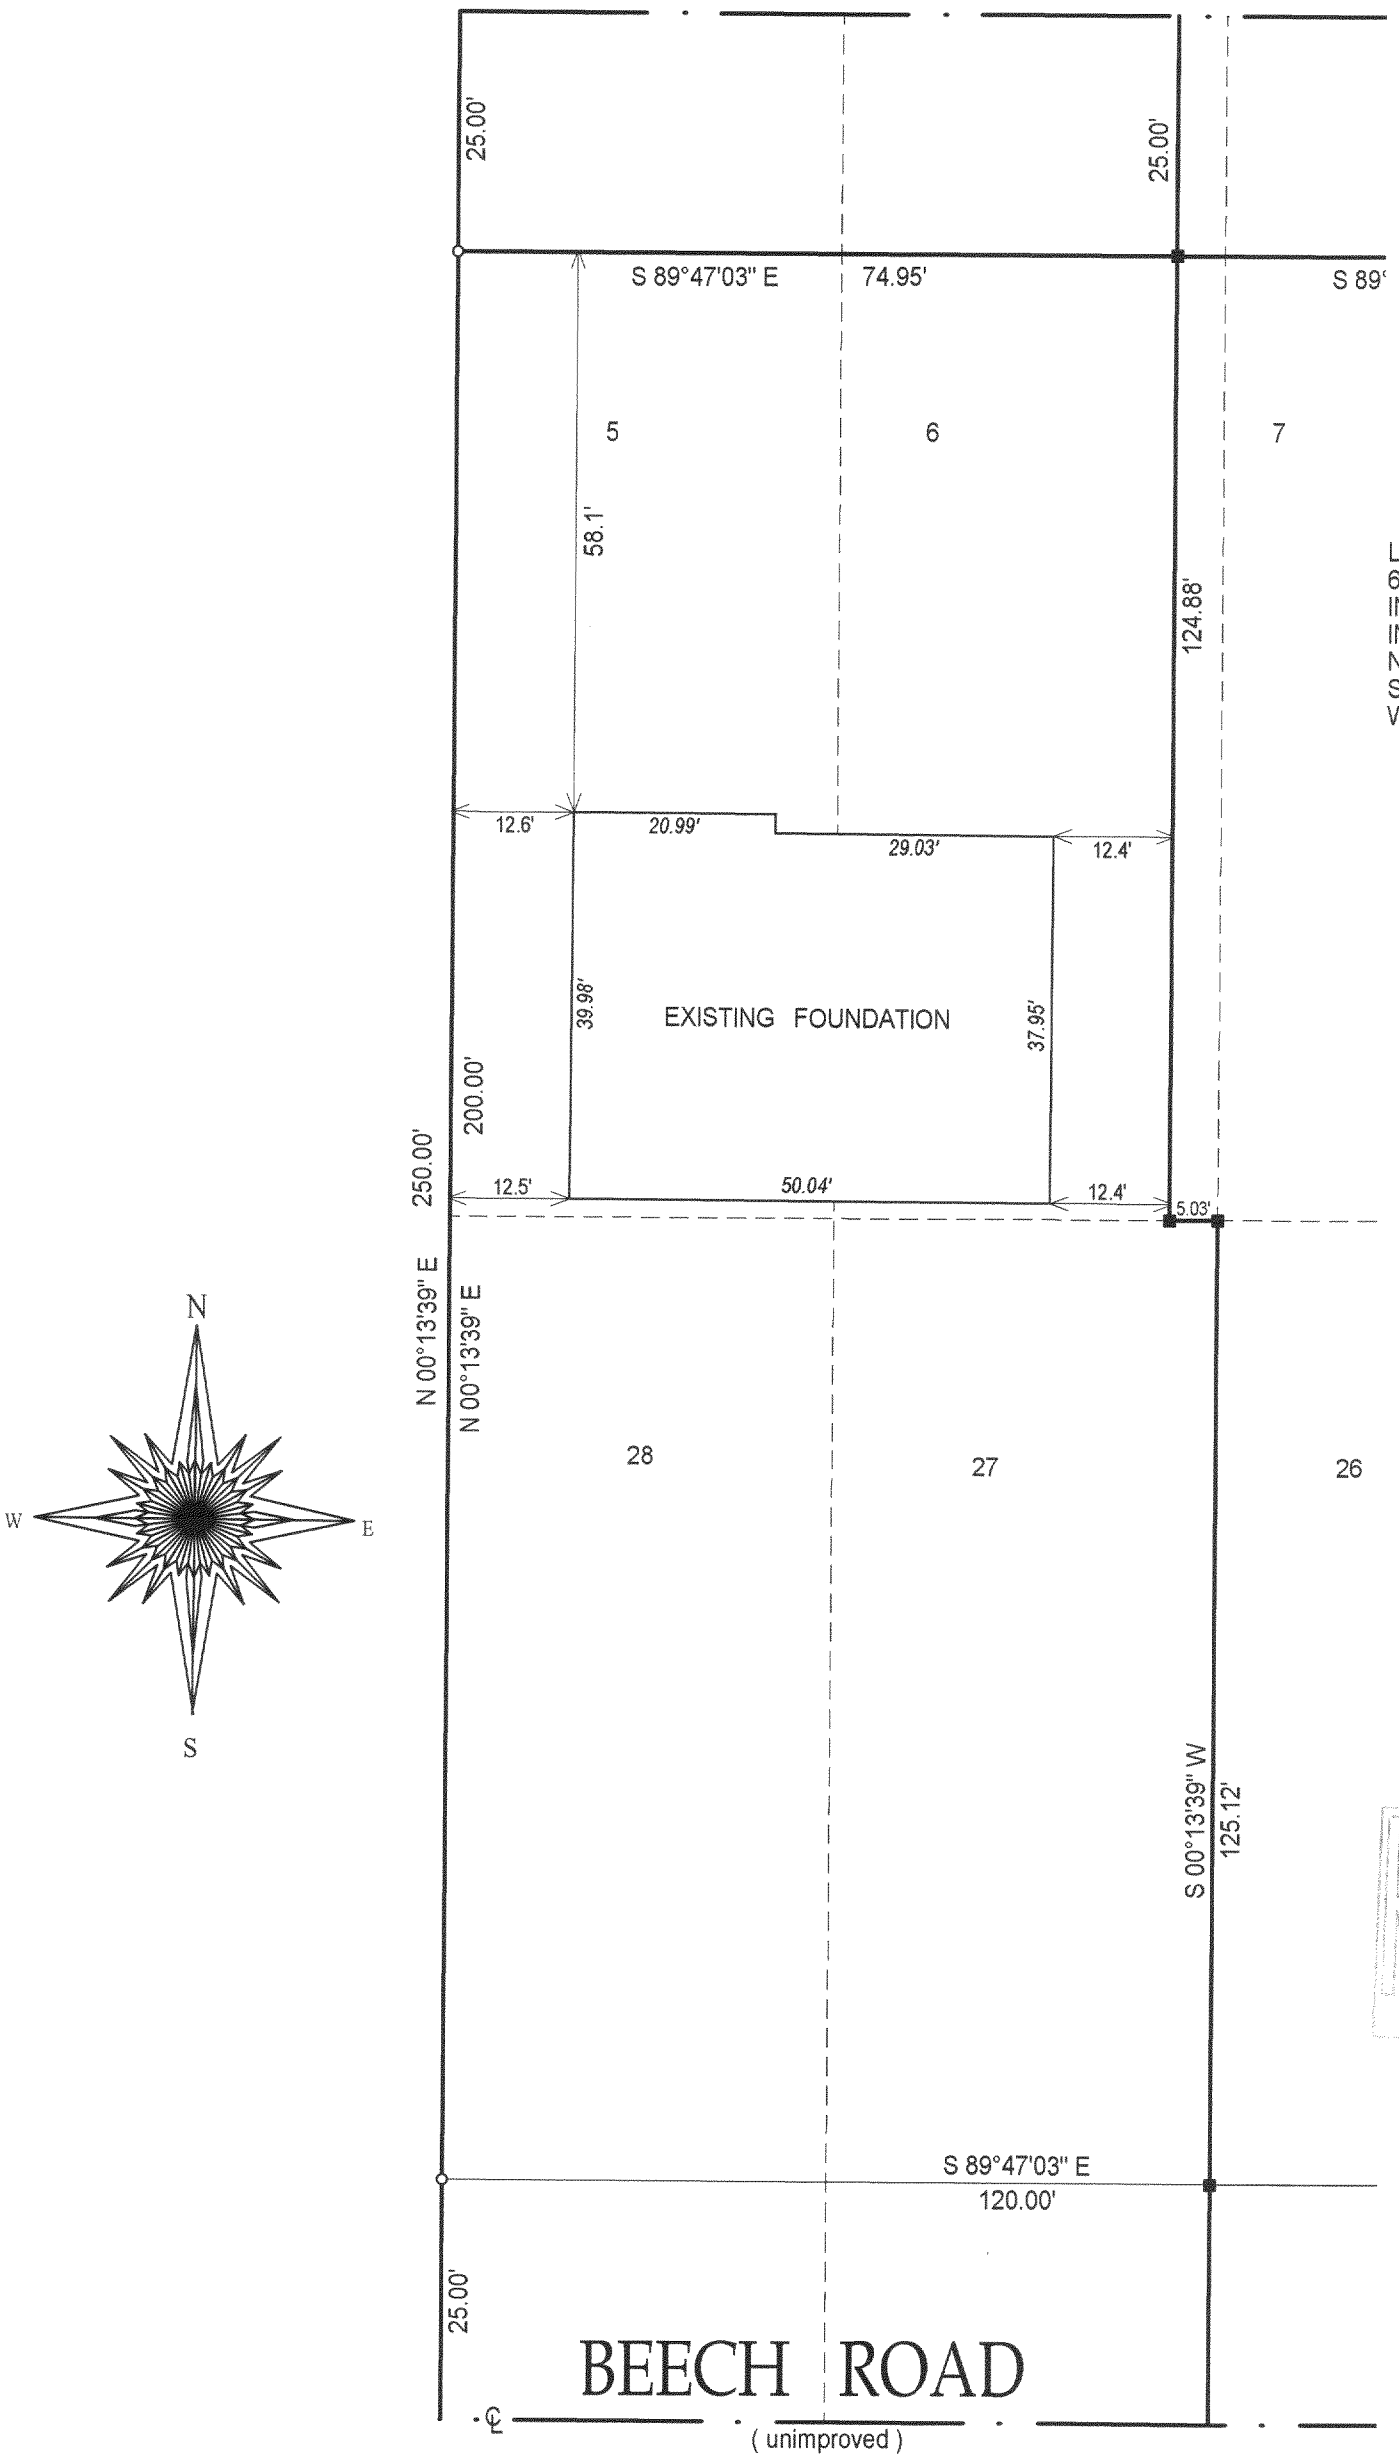

PLAT OF SURVEY

-OF-

LOT 5 AND THE WEST 35 FEET OF LOT 6 AND LOTS 27 AND 28 BLOCK 67, INTERLAKEN, A SUBDIVISION LOCATED IN THE NW 1\4 OF SECTION 14, TOWN 3 NORTH, RANGE 16 EAST, TOWN OF SUGAR CREEK, WALWORTH COUNTY, WISCONSIN.

RECEIVED
AUG 1 6 2004
KW

WISCONSIN
JOHN P. KROTT
S-2258
LAKE GENEVA WIS.
LAND SURVEYOR

( ) = RECORDED AS
□ = FOUND IRON BAR
○ = FOUND IRON PIPE
● = SET IRON PIPE
■ = SET IRON BAR

SCALE: 1" = 20'
JOB #: 03-417A
TAX ID #:

REVISED 2-3-2004 MOVED HOUSE BACK

COMPARE LEGAL DESCRIPTION ABOVE AND DRAWING WITH DEED. FOR BUILDING RESTRICTIONS AND EASEMENTS NOT SHOWN,REFER TO DEED, ABSTRACT SOURCES AND LOCAL MUNICIPAL CODES. NOTIFY THE SURVEYOR IMMEDIATELY OF ANY DISCREPANCY.

"I hereby certify that the above described property was surveyed under my supervision and that the above map, to the best of my knowledge and belief, is a true representation thereof and shows the size and location of all visible structures, apparent easements and encroachments if any."
This survey is made for the present owners of the property, and those who purchase, mortgage, or guarentee the title thereto, within one year from the date hereof.

John P Krott

JOHN KROTT S - 2258
Wisconsin Registered Land Surveyor
(original if signed in red)

DATE OF LAST REVISION 04-20-04

DATED THE 3 RD, DAY OF FEB. 2004.

GI 00613

316-1663